



STATE OF DELAWARE  
**DEPARTMENT OF TRANSPORTATION**  
800 BAY ROAD  
P.O. BOX 778  
DOVER, DELAWARE 19903

JENNIFER COHAN  
SECRETARY

**VIA OVERNIGHT DELIVERY**

June 13, 2017

Contract No. T201680102.02  
Magnolia Truck Wash  
Kent County

Ladies and Gentlemen:

Enclosed is Addendum No. 2 for the referenced contract consisting of the following:

1. The Bid Proposal Cover, revised, to be substituted for the same page in the Proposal.
2. One (1) page, Special Provision 763569-Building Renovation, page 40, revised, to be substituted for the same page in the Proposal.
3. One (1) page, Special Provision 763638-Non Potable Well, page 41, revised, to be substituted for the same page in the Proposal.
4. Two (2) pages, Bid Proposal Forms, pages 2 and 3, revised, to be substituted for the same pages in the Proposal. Item Number 710408 has been deleted.
5. One (1) page, Plan Sheet 16, revised, to be substituted for the same page in the Proposal.
6. Expedite File Disc, Amendments No. 1.

Please note the revisions listed above and submit your bid based upon this information.

Sincerely,

*~signature on file~*

Robert A. Kovacs  
Competitively Bid Contracts Coordinator  
Delaware Department of Transportation

STATE OF DELAWARE



DEPARTMENT OF TRANSPORTATION

BID PROPOSAL

for

CONTRACT T201680102.02

MAGNOLIA TRUCK WASH

**RE-ADVERTISEMENT**

**This Contract Was Previously Advertised & Not Awarded**

KENT COUNTY

ADVERTISEMENT DATE: May 15, 2017

**PROSPECTIVE BIDDERS ARE ADVISED THAT THERE WILL BE A PRE-BID MEETING THURSDAY  
JUNE 1, 2017 AT 2:00 P.M. IN THE DelDOT ADMINISTRATION BUILDING,  
800 BAY ROAD, DOVER, DELAWARE, 19903.**

COMPLETION TIME: 271 Calendar Days

SPECIFICATIONS FOR ROAD AND BRIDGE CONSTRUCTION  
DELAWARE DEPARTMENT OF TRANSPORTATION  
AUGUST 2016

Bids will be received in the Bidder's Room at the Delaware Department of Transportation's Administration Building, 800 Bay Road, Dover, Delaware until 2:00 P.M. local time June 20, 2017

Contract No. T201680102.02

**763569 - BUILDING RENOVATION**

**Description:**

This work consists of all equipment, labor, materials necessary to furnish and install the ~~maintenance shop building~~ **truck wash facility** complete per the contract drawings. The work specifically includes but is not necessarily limited to the building shell including foundation and footers. It also includes the concrete floor, walls, plumbing, electrical, HVAC, mechanical, lighting, and all other items indicated within the building as indicated in the Contract Drawings and noted in the Technical Specifications in Appendix A.

**Materials and Construction:**

All materials and construction shall conform to the requirements of the Contract Drawings and any technical specifications referenced.

**Method of Measurement:**

Payment for this item will be made on a lump sum basis wherein no measurement will be made.

**Basis of Payment:**

Payment will be made at the Lump Sum price bid for this item. The price bid shall include the cost for performing the work specified and furnishing all labor, materials, tools, equipment and incidentals necessary to provide a complete, working and usable facility acceptable to the Engineer.

~~5/23/16~~ 6/12/17

Contract No. T201680102.02

## **763638 - NON-POTABLE WELL**

### **Description:**

This work consists of providing a non-potable well and associated pump at the location shown on the Plans and as directed by the Engineer. The electrical service ~~and associated pumps shall~~ to the well shall be provided as part of a separate pay item.

### **Materials and Construction Methods:**

The Contractor shall prepare, submit, and gain approval from the Engineer on shop drawings detailing all well materials, appurtenances, and construction methods prior to any well installation activities. Should the contractor choose to order any materials prior to final approval of the shop drawings, he will do so at his own risk.

The Contractor installing the well shall be a well driller licensed with the Delaware Department of Natural Resources and Environmental Control (DNREC), Division of Water Resources, Water Supply Section, Well Permits Branch. The licensed well contractor shall prepare, submit, and gain approval on a well permit from DNREC prior to any well installation activities. All well materials and installation procedures shall comply with the latest version of the "Delaware Regulations Governing the Construction and Use of Wells", available from the Delaware DNREC, Division of Water Resources, Water Supply Section. Contractor shall be responsible for completing drawdown tests as required to verify compliance with the flow requirements indicated on the Contract Drawings.

The proposed well shall meet or exceed the following characteristics:

- 200 gallons per minute (GPM) well yield
- Well diameter and depth as determined by the contractor to meet the required flow rate.
- Well pump equal to the equipment specified on the contract drawings. ~~The well pump and~~ required electrical service shall be provided as part of a separate pay item.

Final acceptance of the non-potable well shall be made only after its satisfactory operation as determined by the Engineer. The existing well at serving the wash pad shall be abandoned by the Contractor after receiving approval to do so by the Engineer. Well abandonment procedures shall conform to current DNREC regulations.

### **Method of Measurement:**


The quantity of non-potable wells will not be measured.

### **Basis of Payment:**

The quantity of non-potable well will be paid for at the Contract lump sum price. Price and payment will constitute full compensation for all of the work necessary to provide a fully functional non-potable well, including acquiring the well drilling permit from DNREC, furnishing and installing the well and all well appurtenances (well pipe, casing, screen, pump, well seal, etc.), restoring all disturbed areas, disposing of surplus materials, abandonment of the existing well, and for all labor, tools, equipment and incidentals necessary to complete the work.


~~4/27/17~~ 6/12/17

Q:\SMD\120995\_017\_Magnolia\_Maintenance\CADD\ARCHITECTURAL\12-0995-017b Magnolia Facility Wash Bay ReDesign.rvt

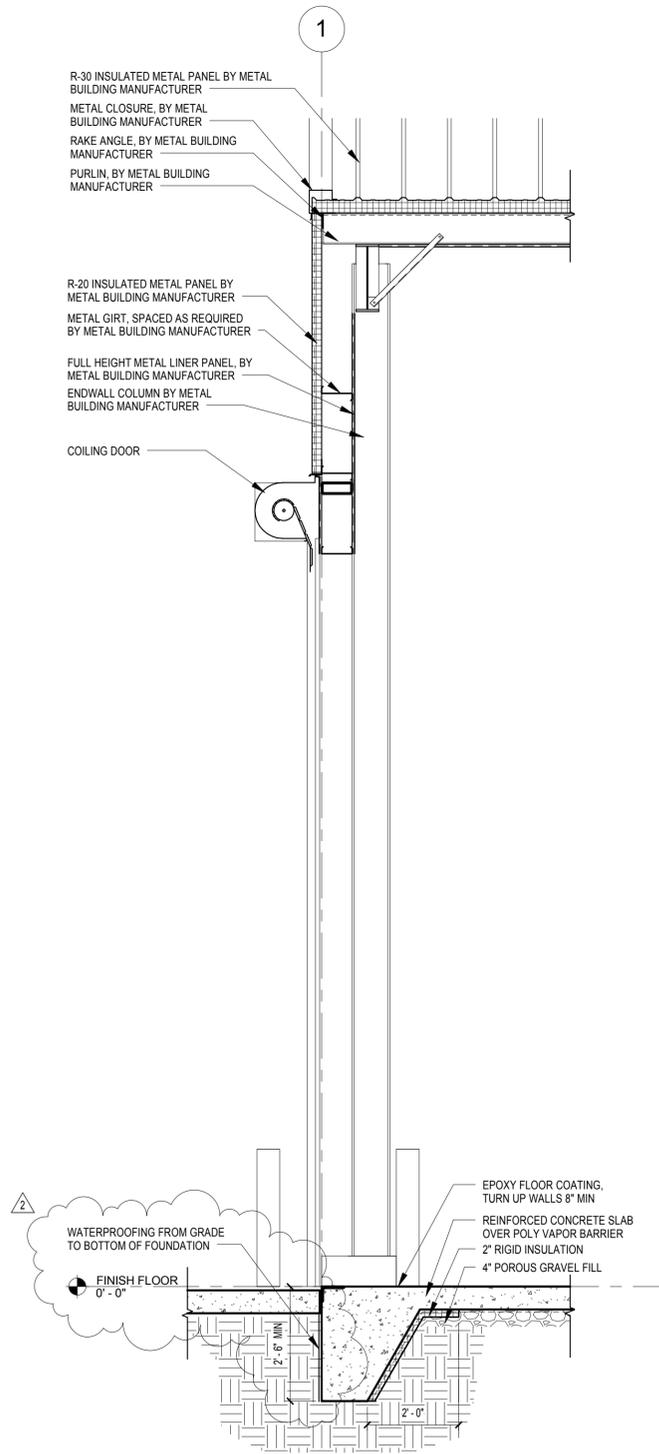


1 WALL SECTION  
A-302 1/2" = 1'-0"

NOTE: EXPOSED PRIMARY STEEL MEMBERS AND HOLLOW METAL DOORS & FRAMES SHALL BE PAINTED WITH HIGH PERFORMANCE COATING.

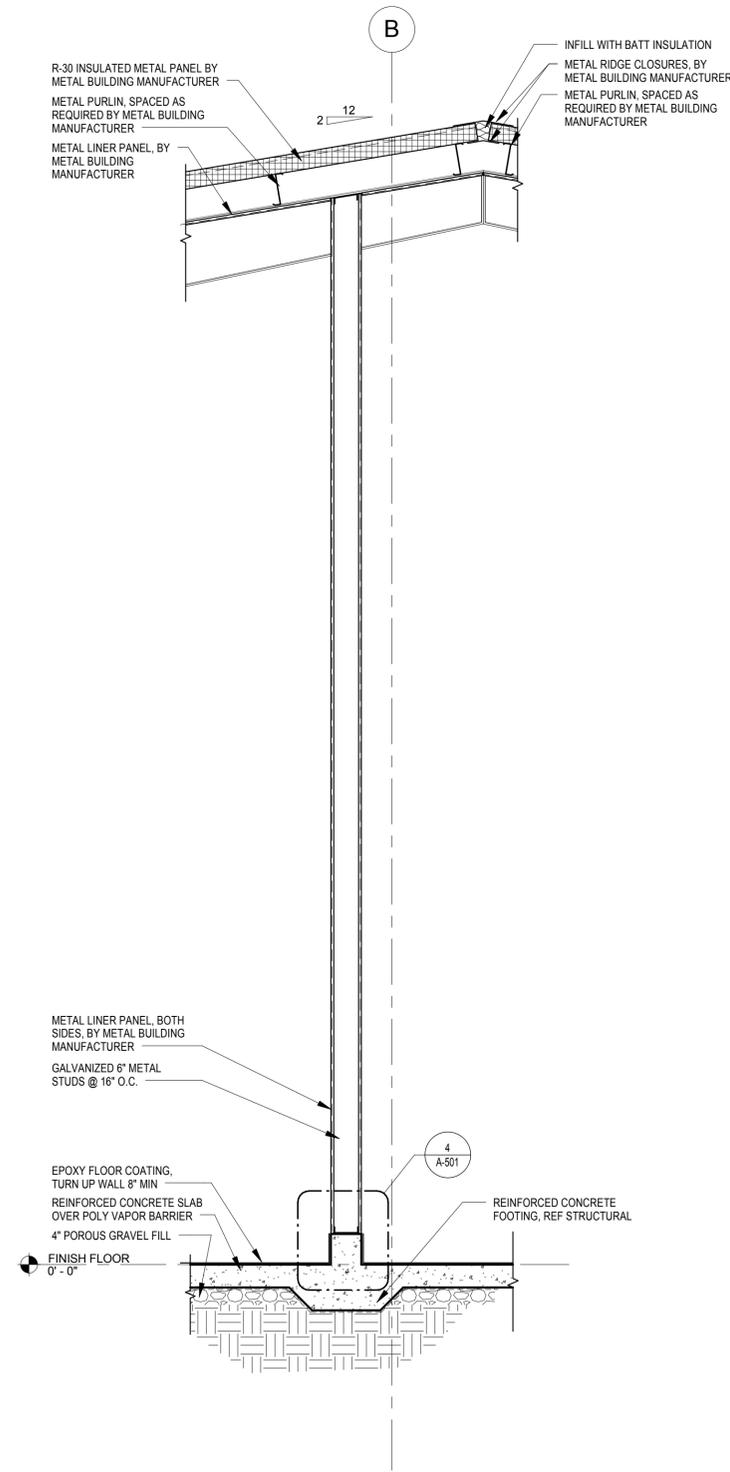

2 WALL SECTION  
A-302 1/2" = 1'-0"

NOTE: EXPOSED PRIMARY STEEL MEMBERS AND HOLLOW METAL DOORS & FRAMES SHALL BE PAINTED WITH HIGH PERFORMANCE COATING.

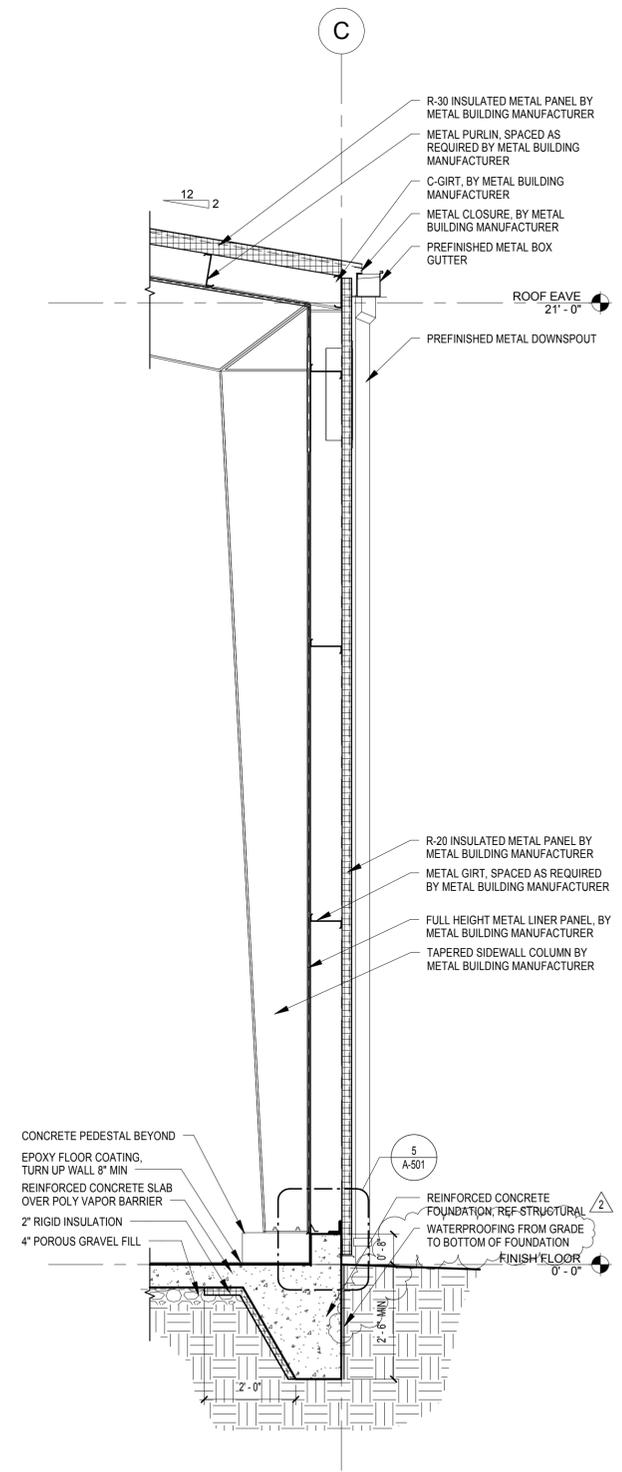

3 WALL SECTION  
A-302 1/2" = 1'-0"

NOTE: EXPOSED PRIMARY STEEL MEMBERS AND HOLLOW METAL DOORS & FRAMES SHALL BE PAINTED WITH HIGH PERFORMANCE COATING.

SDATE\_USERS

ADDENDUMS / REVISIONS	
2	6/6/17 ADDENDUM 2

CONTRACT	BRIDGE NO.
T201680102	DESIGNED BY: DCH
COUNTY	CHECKED BY: KNM
KENT	

DELAWARE DEPARTMENT OF TRANSPORTATION  
SCHEDULE OF ITEMS

PAGE: 2  
DATE:

CONTRACT ID: T201680102.02 PROJECT(S): T201680102

All figures must be typewritten.

CONTRACTOR : \_\_\_\_\_

LINE NO	ITEM DESCRIPTION	APPROX. QUANTITY AND UNITS	UNIT PRICE		BID AMOUNT	
			DOLLARS	CTS	DOLLARS	CTS
0080	601192 PVC PIPE, 8"	92.000 LF				
0090	601219 CORRUGATED POLYETHYLENE PIPE, TYPE S, 12"	92.000 LF				
0100	602003 DRAINAGE INLET, 34" X 24"	2.000 EACH				
0120	710500 INSTALL WATERLINE	LUMP		LUMP		
0130	711009 INSTALLING SANITARY SEWER, PVC, 8"	95.000 LF				
0140	727006 TEMPORARY CONSTRUCTION FENCE	755.000 LF				
0150	763536 TRUCK WASH SYSTEM	LUMP		LUMP		
0160	763569 BUILDING RENOVATION	LUMP		LUMP		
0170	763638 NON-POTABLE WELL WITH ELECTRIC SERVICE	LUMP		LUMP		
0180	830001 CONDUIT JUNCTION WELL, TYPE 1, 20"X20" PRECAST CONCRETE	1.000 EACH				

DELAWARE DEPARTMENT OF TRANSPORTATION  
SCHEDULE OF ITEMS

PAGE: 3  
DATE:

CONTRACT ID: T201680102.02 PROJECT(S): T201680102

All figures must be typewritten.

CONTRACTOR :

LINE NO	ITEM DESCRIPTION	APPROX. QUANTITY AND UNITS	UNIT PRICE		BID AMOUNT	
			DOLLARS	CTS	DOLLARS	CTS
0190	831004 FURNISH & INSTALL UP TO 4" SCHEDULE 80 PVC CONDUIT (TRENCH)	 1010.000  LF				
0200	832010 FURNISH & INSTALL 1-CONDUCTOR #10 STRNDED COPPER, TYPE USE-2	 800.000  LF				
0210	832016 FURNISH & INSTALL STRANDED INSULATED COPPER GROUND WIRE, 1/#1/0 AWG	 45.000  LF				
0220	832021 FURNISH & INSTALL STRANDED INSULATED COPPER GROUND WIRE, 1/#10 AWG	 265.000  LF				
0230	832036 FURNISH & INSTALL 1-CONDUCTOR 250 KCMIL STRANDED COPPER, TYPE USE-2	 180.000  LF				
0240	905001 SILT FENCE	 250.000  LF				
0250	905004 INLET SEDIMENT CONTROL, DRAINAGE INLET	 6.000  EACH				
	SECTION 0002 TOTAL					
	TOTAL BID					