

DIGITAL ACCESSIBILITY NOTICE

The Delaware Department of Transportation (DelDOT) is committed to ensuring that its digital services, content, and documents are accessible to all users and is actively working to comply with applicable federal and state accessibility requirements. DelDOT continues to make improvements over time, with current efforts focused on programs, applications, content, and documents that are actively in use and available to the public.

Due to the nature and complexity of certain materials, including construction plans, technical drawings, historical documents, maps, and other graphic-intensive files, some documents may not currently be fully digitally accessible or compliant with current accessibility standards. In some cases, these documents are provided for historical, reference, informational, or procurement purposes only.

If you require an accessible version of a document or need assistance accessing any content, please contact DelDOT, and reasonable efforts will be made to provide the information in an accessible format upon request. DelDOT appreciates your patience and understanding as accessibility improvements continue to be implemented.

COUNTY	CONTRACT	P. R. A. REG. NO.	STATE	FED. AID PROJECT NO.	FISCAL YEAR	SHEET NO.	TOTAL SHEETS
NEW CASTLE	6401063211	2	DEL.	I-95-1(13)		15	26

"AS-BUILT" PLAN
3-7-66

NOTES

Specifications:

Construction: State of Delaware, State Highway Department, Standard Specifications, 1960
Design: A.A.S.H.O. Standard Specifications for Highway Bridges, 1961.

Dead Load: Concrete - 150* per cu.ft.; Wearing Surface - 25* per sq.ft.

Live Load: H20-S16-44 Modified. Slab designed for 16^k wheel load.


Unit Stresses: Reinforcing Steel (Intermediate Grade) $f_s = 20,000 \text{ p.s.i.}$
Concrete $f_c' = 3000 \text{ p.s.i.}$ $f_c = 1200 \text{ p.s.i.}$

Superstructure: Concrete Deck-Steel Beam Construction
composite action under live load for Span 2.

Elevations: All elevations refer to U.S.C. & G. datum.

For General Notes see Sheet No. 2


For details of Slope Protection see Sheet No. 25

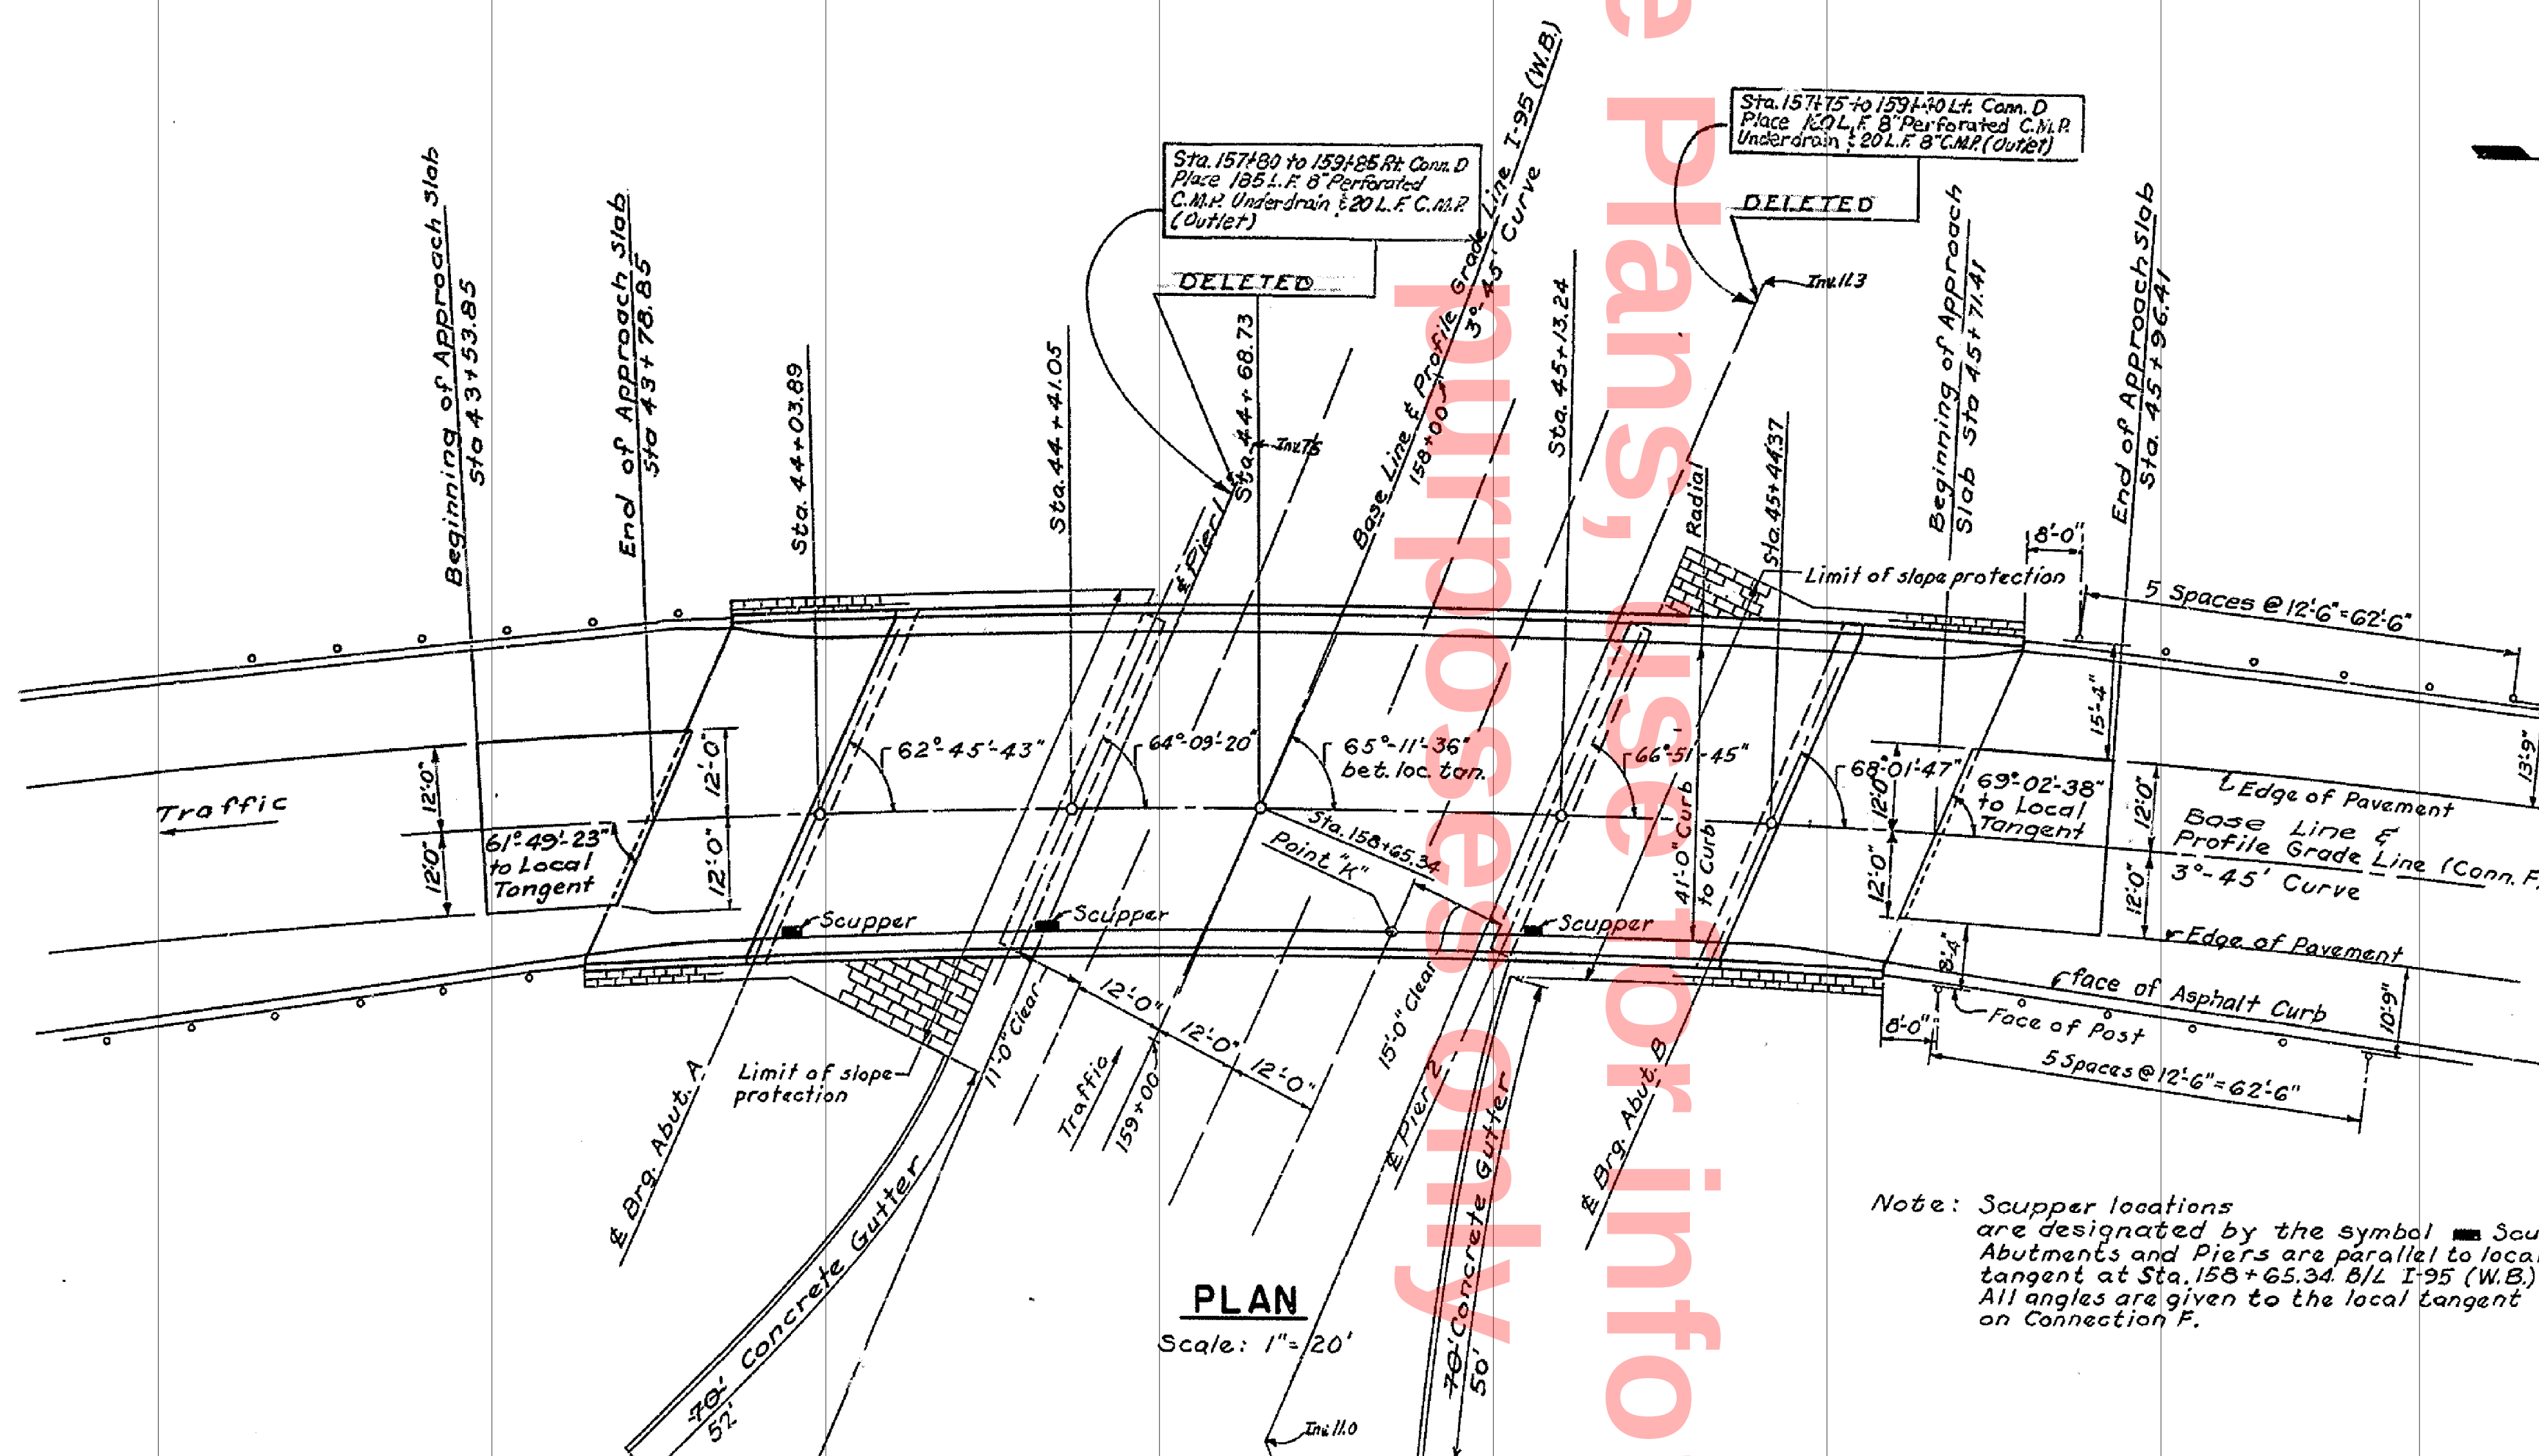

PLAN


Scale: 1"=20'

Note: Scupper locations are designated by the symbol . Scupper Abutments and Piers are parallel to local tangent at Sta. 158+65.34 B/L 1:95 (W.B.) All angles are given to the local tangent on Connection F.

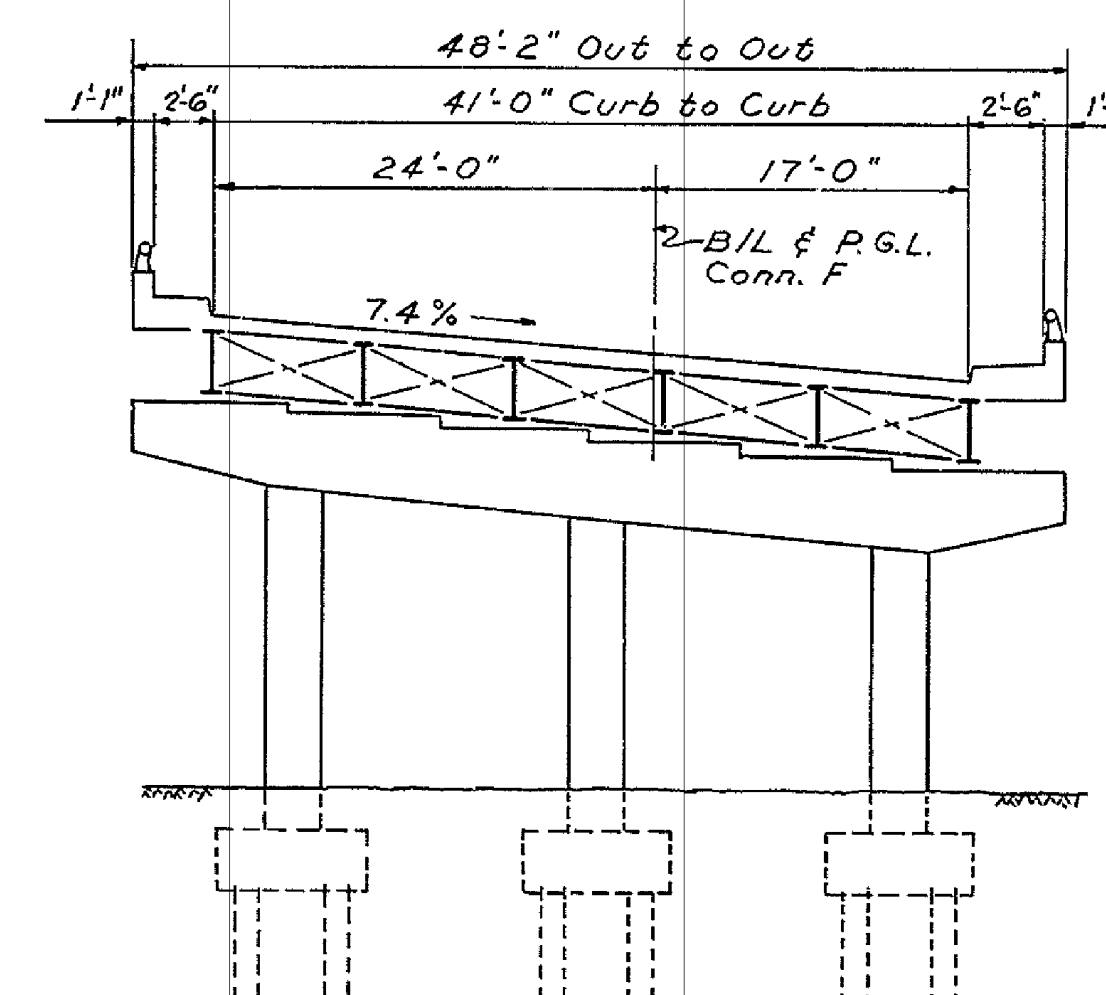

SECTION

Scale: $1'' = 10'$

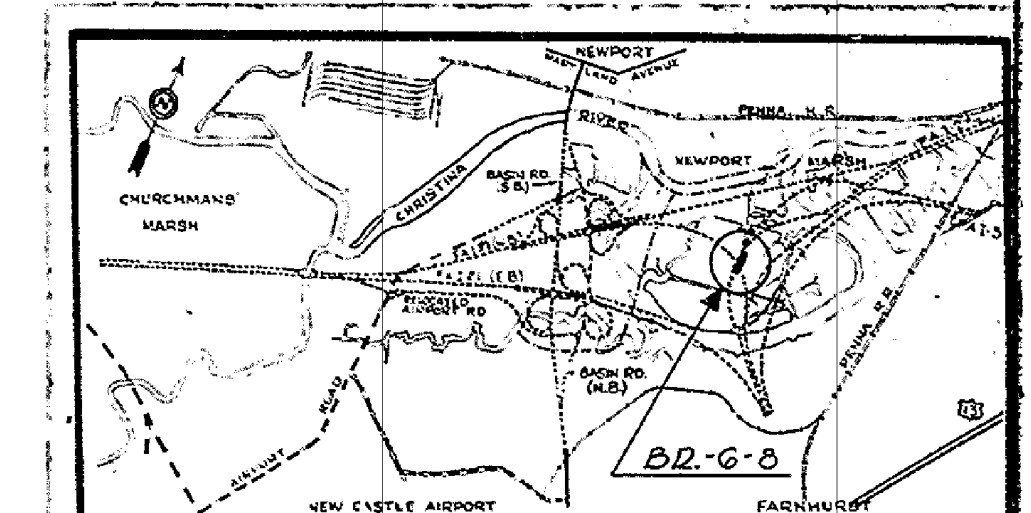

**DELAWARE
STATE HIGHWAY DEPARTMENT**

INTERSTATE ROUTE F.A.I.-1
CHRISTINA RIVER INTERCHANGE


CONNECTION F- BRIDGE 6-8
SITE PLAN

J. E. GREINER CO.
MORAN, PROCTOR, MUESER & RUTLEDGE
CONSULTING ENGINEERS

DESIGNED: J.M.M.	CHECKED: R.C.C. J.M.M.	DATE: 12/19/63
DRAWN: B.L.M.	IN CHARGE: C.B.M.	SCALE: As Shown.


APPROVED

BRIDGE ENGINEER






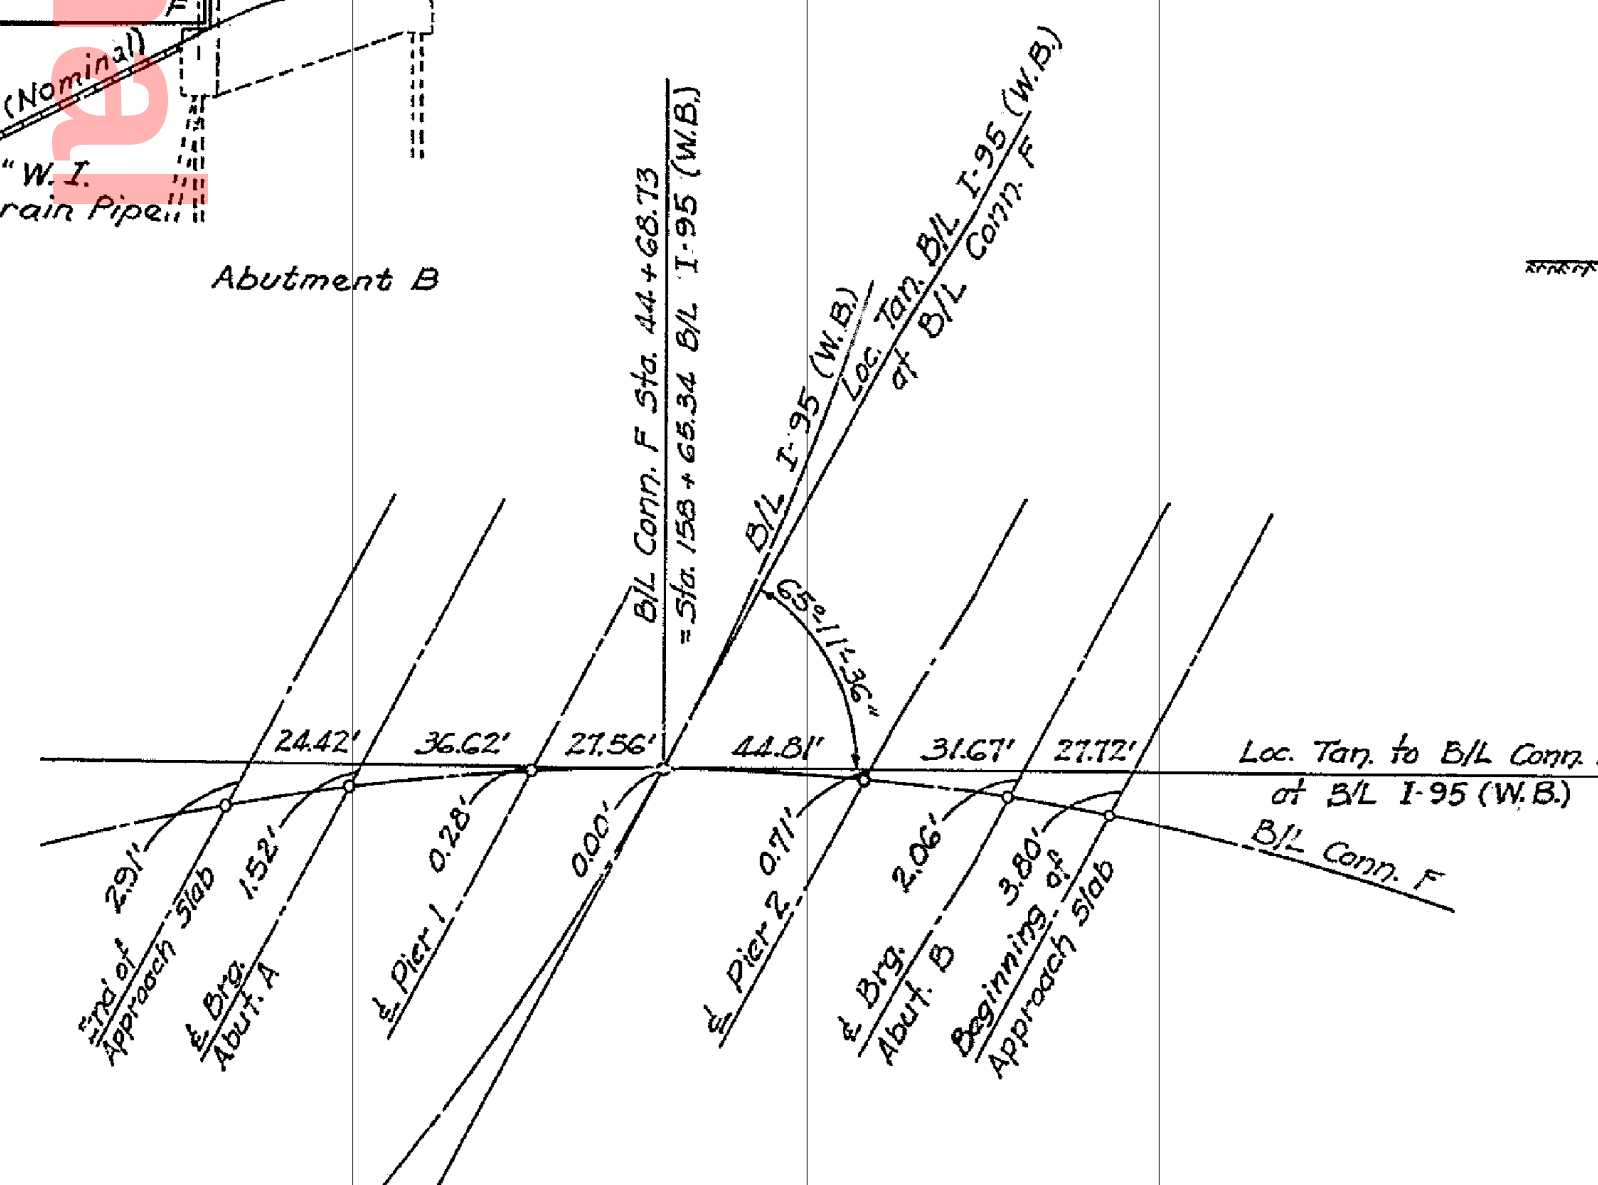


B/L	CONN. F FROM TANGENT	AT B/L	I-95 (W.B.)
-----	----------------------	--------	-------------

No Scale

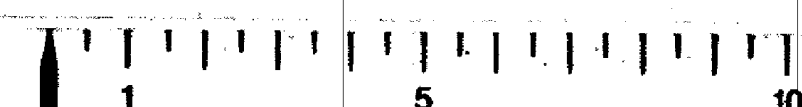

COUNTY	CONTRACT	P.O. & NO.	STATE	PER. AID PROJECT NO.	FISCAL YEAR	SHEET NO.	TOTAL SHEETS
NEW CASTLE	1A1063211	2	DEL.	1-95-1(13)		16	26

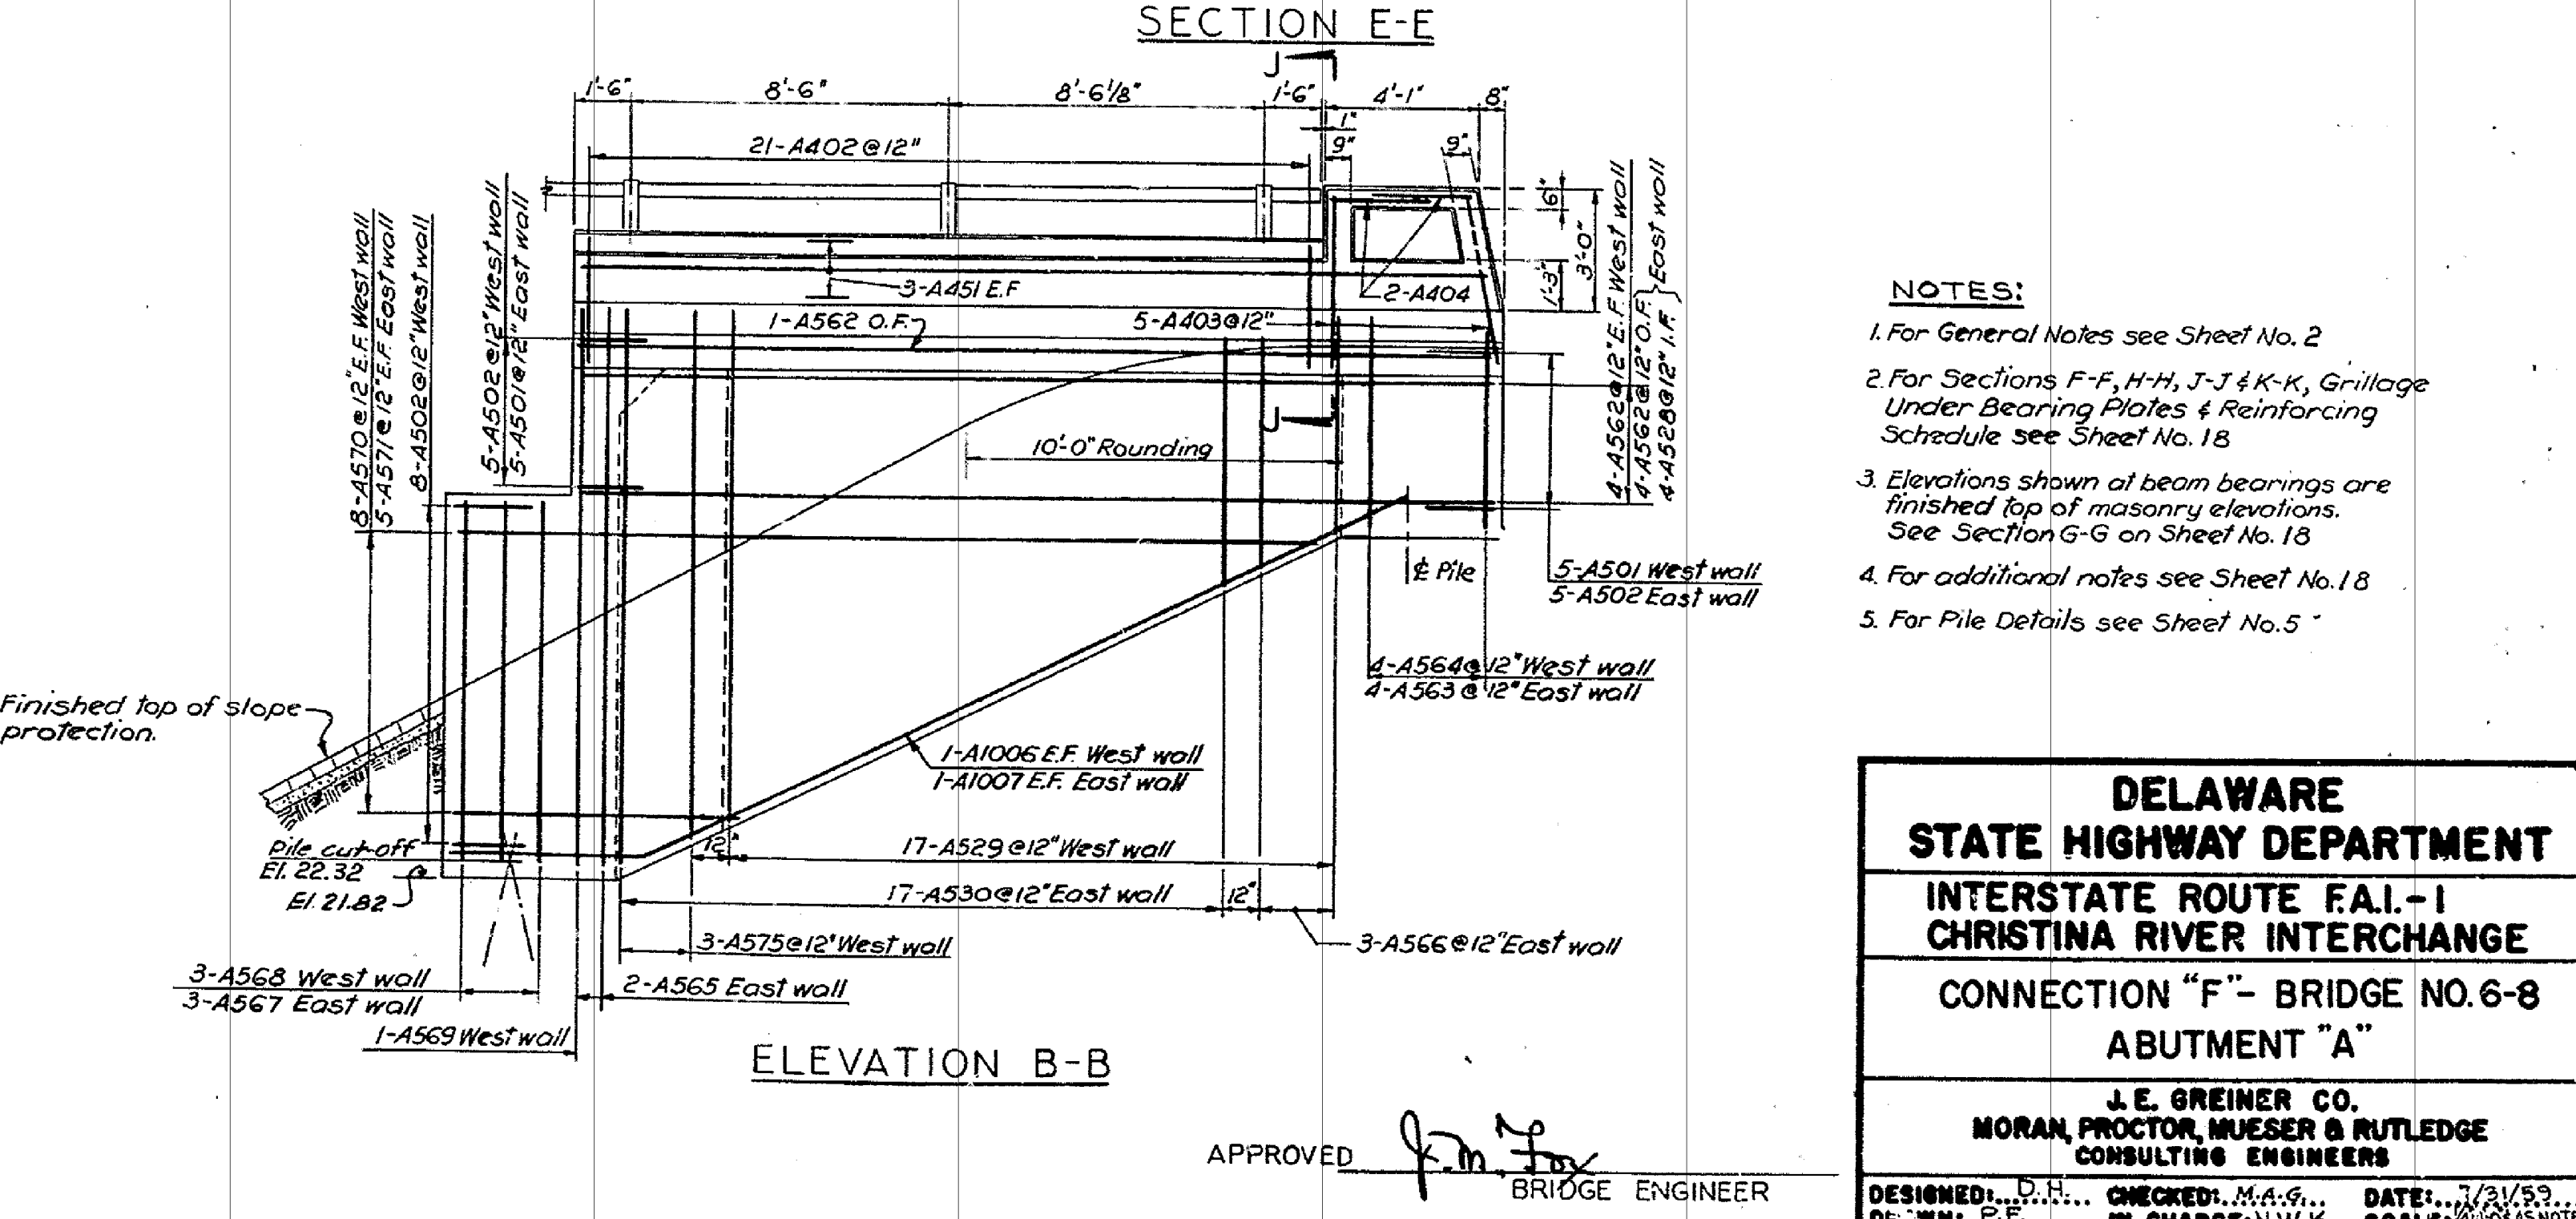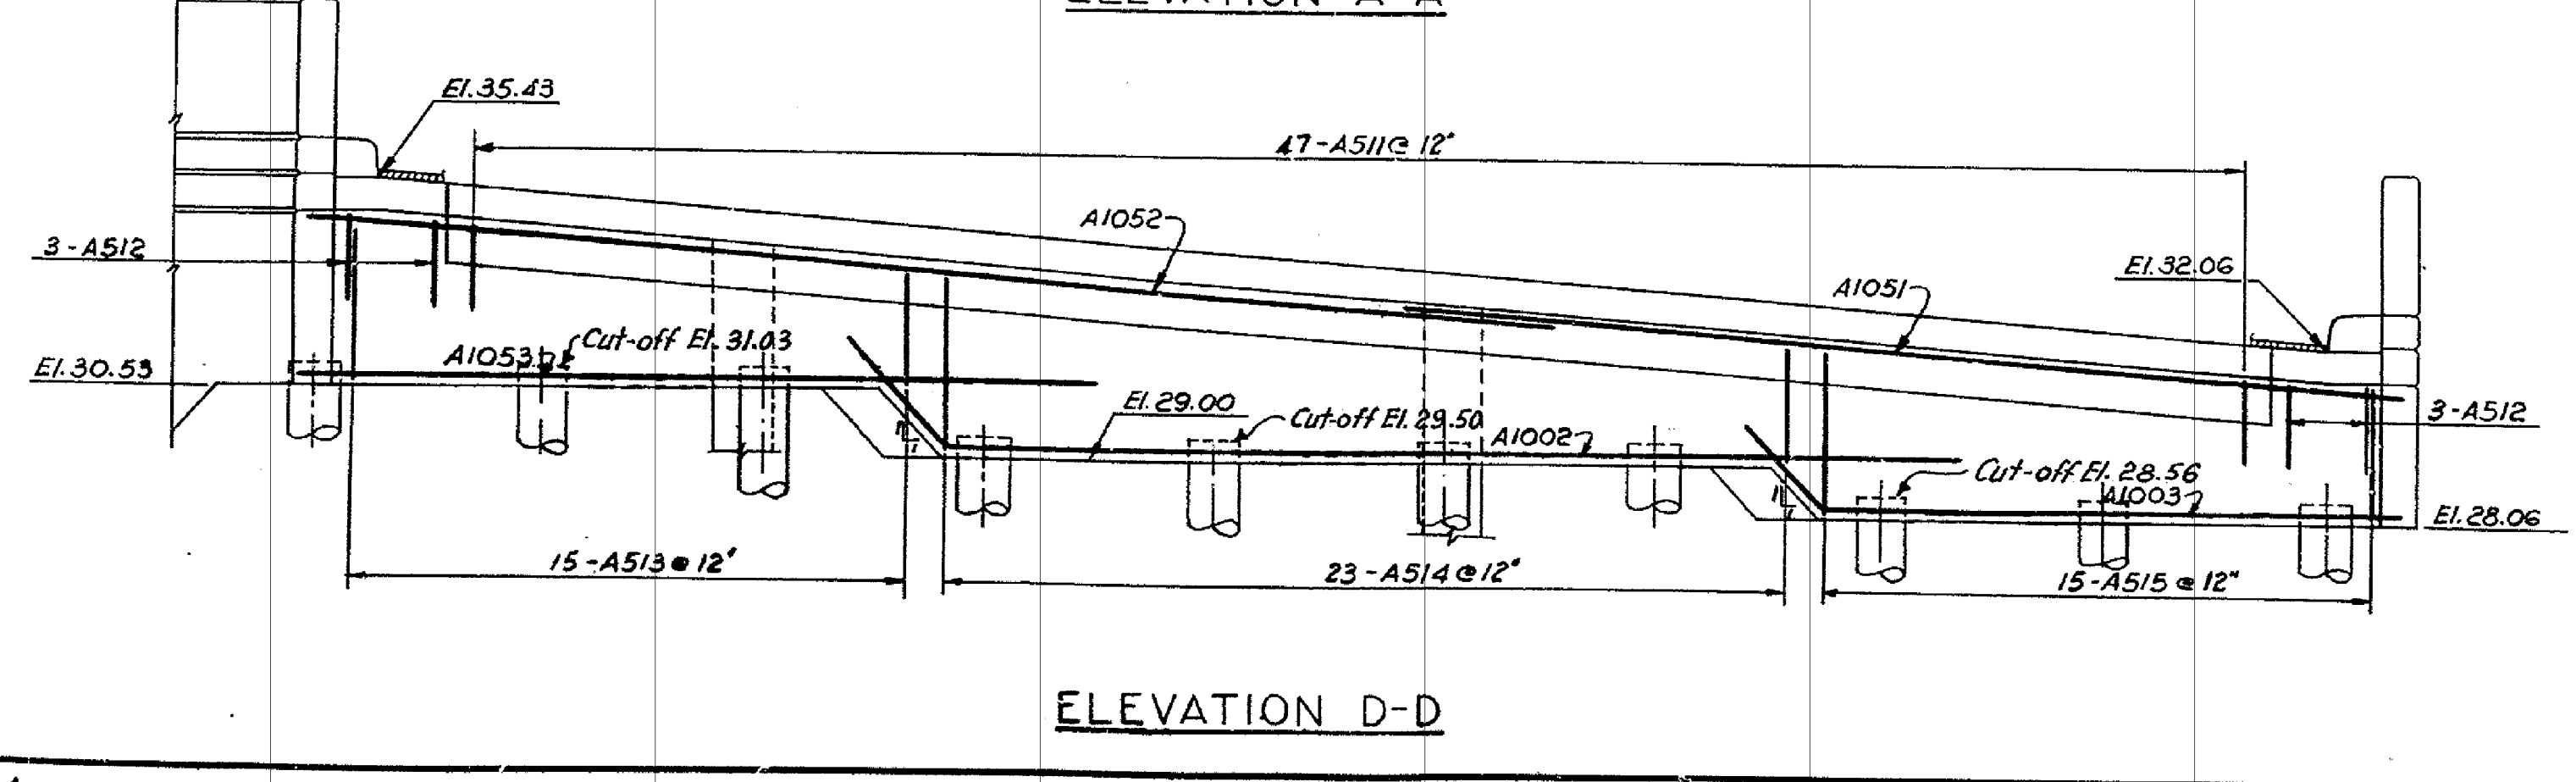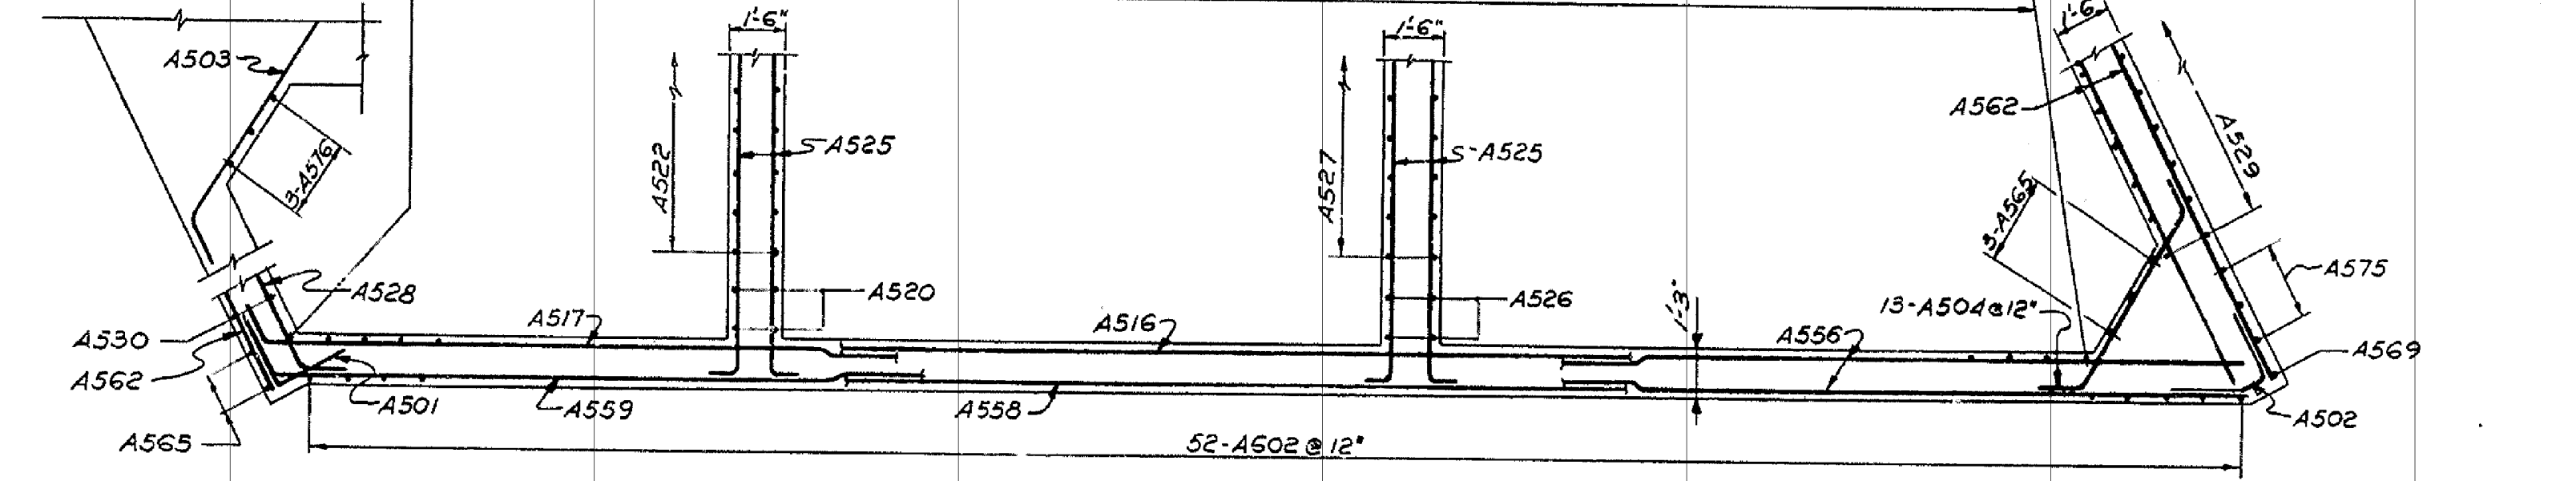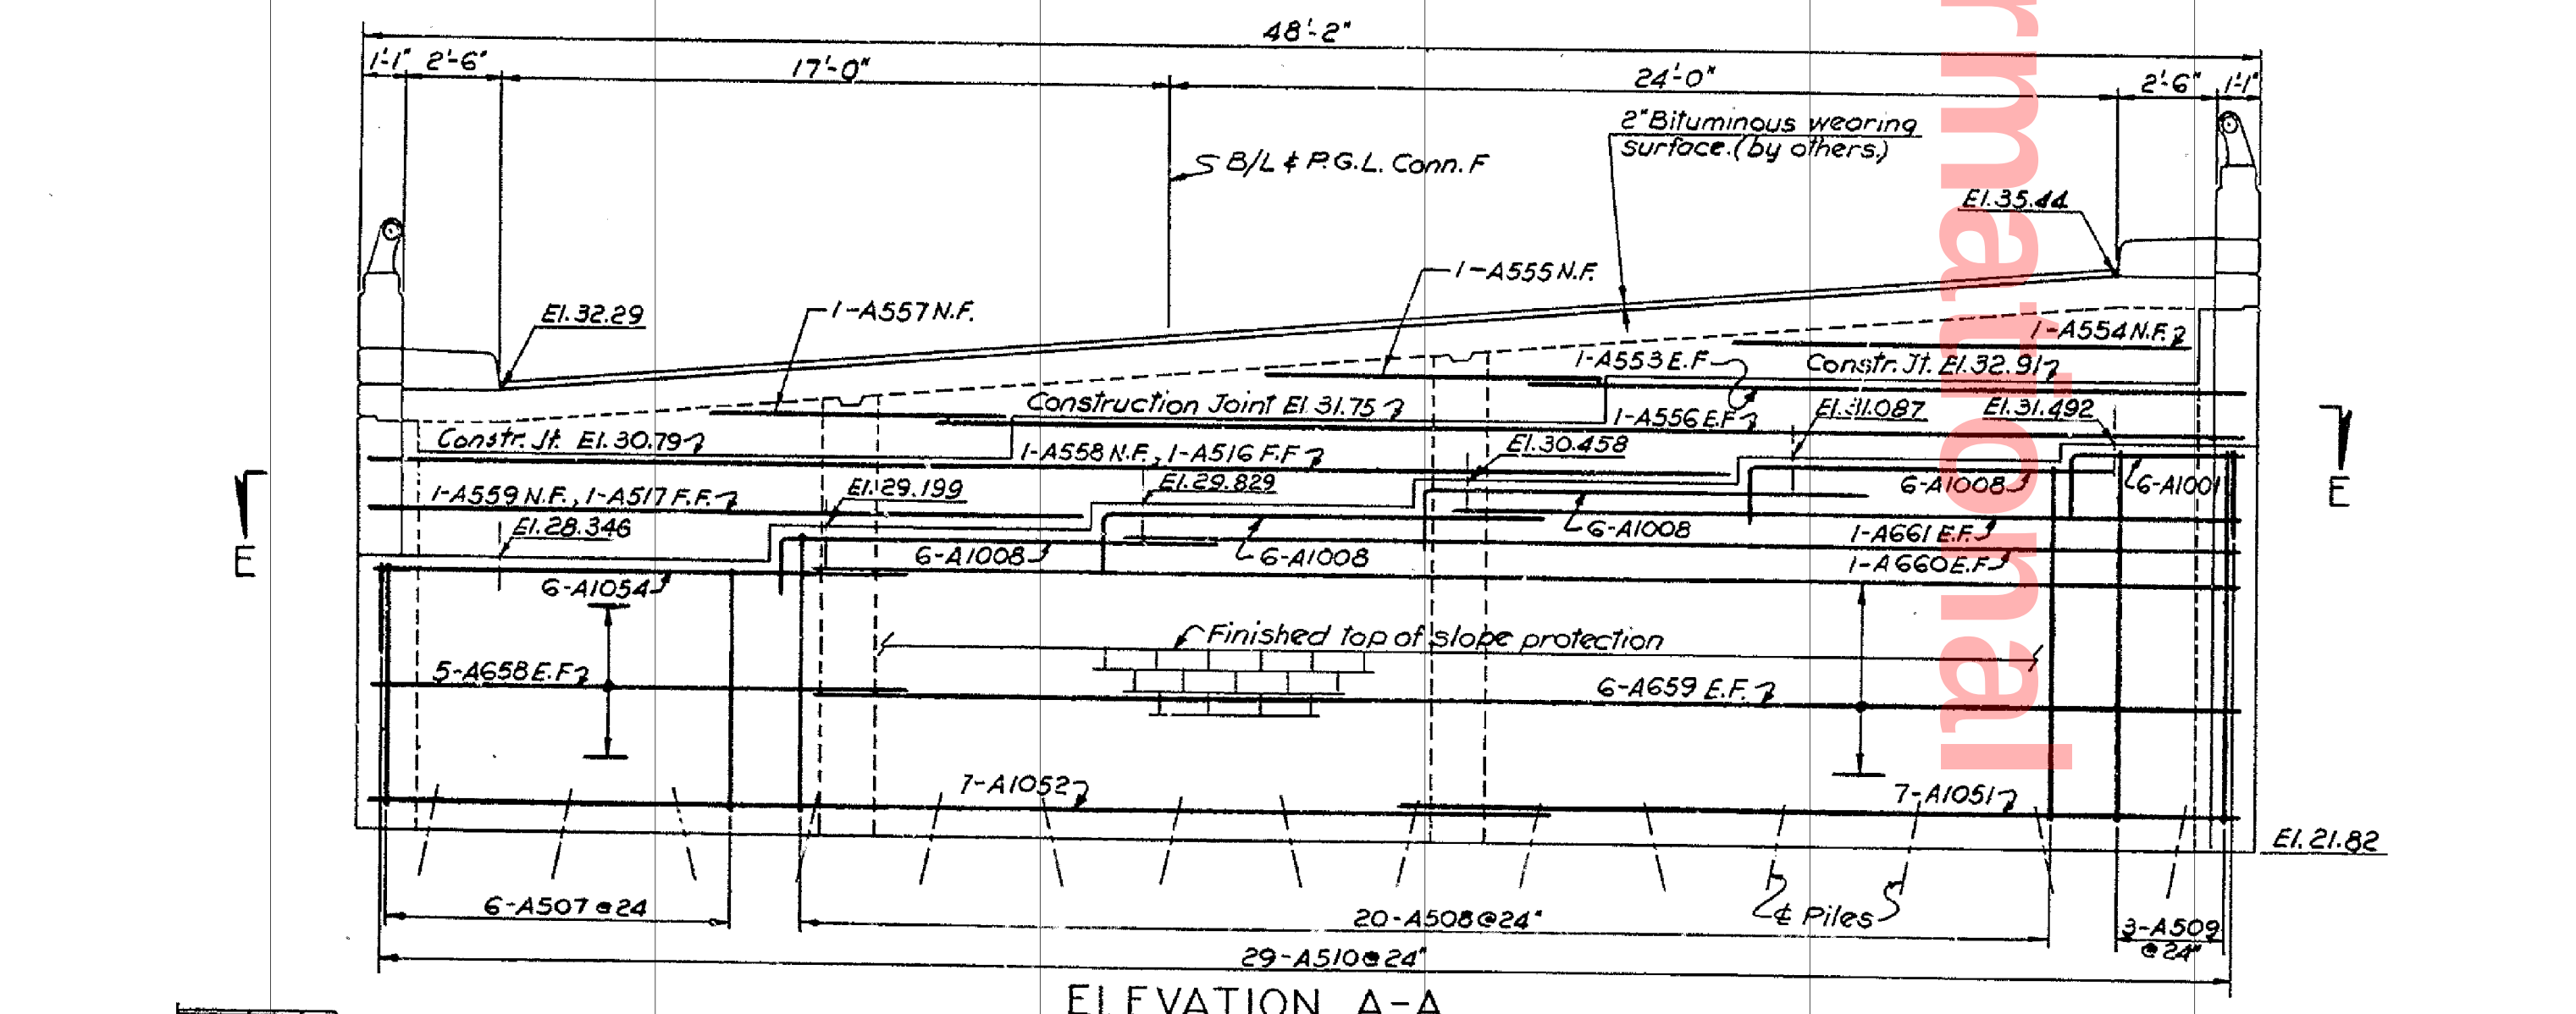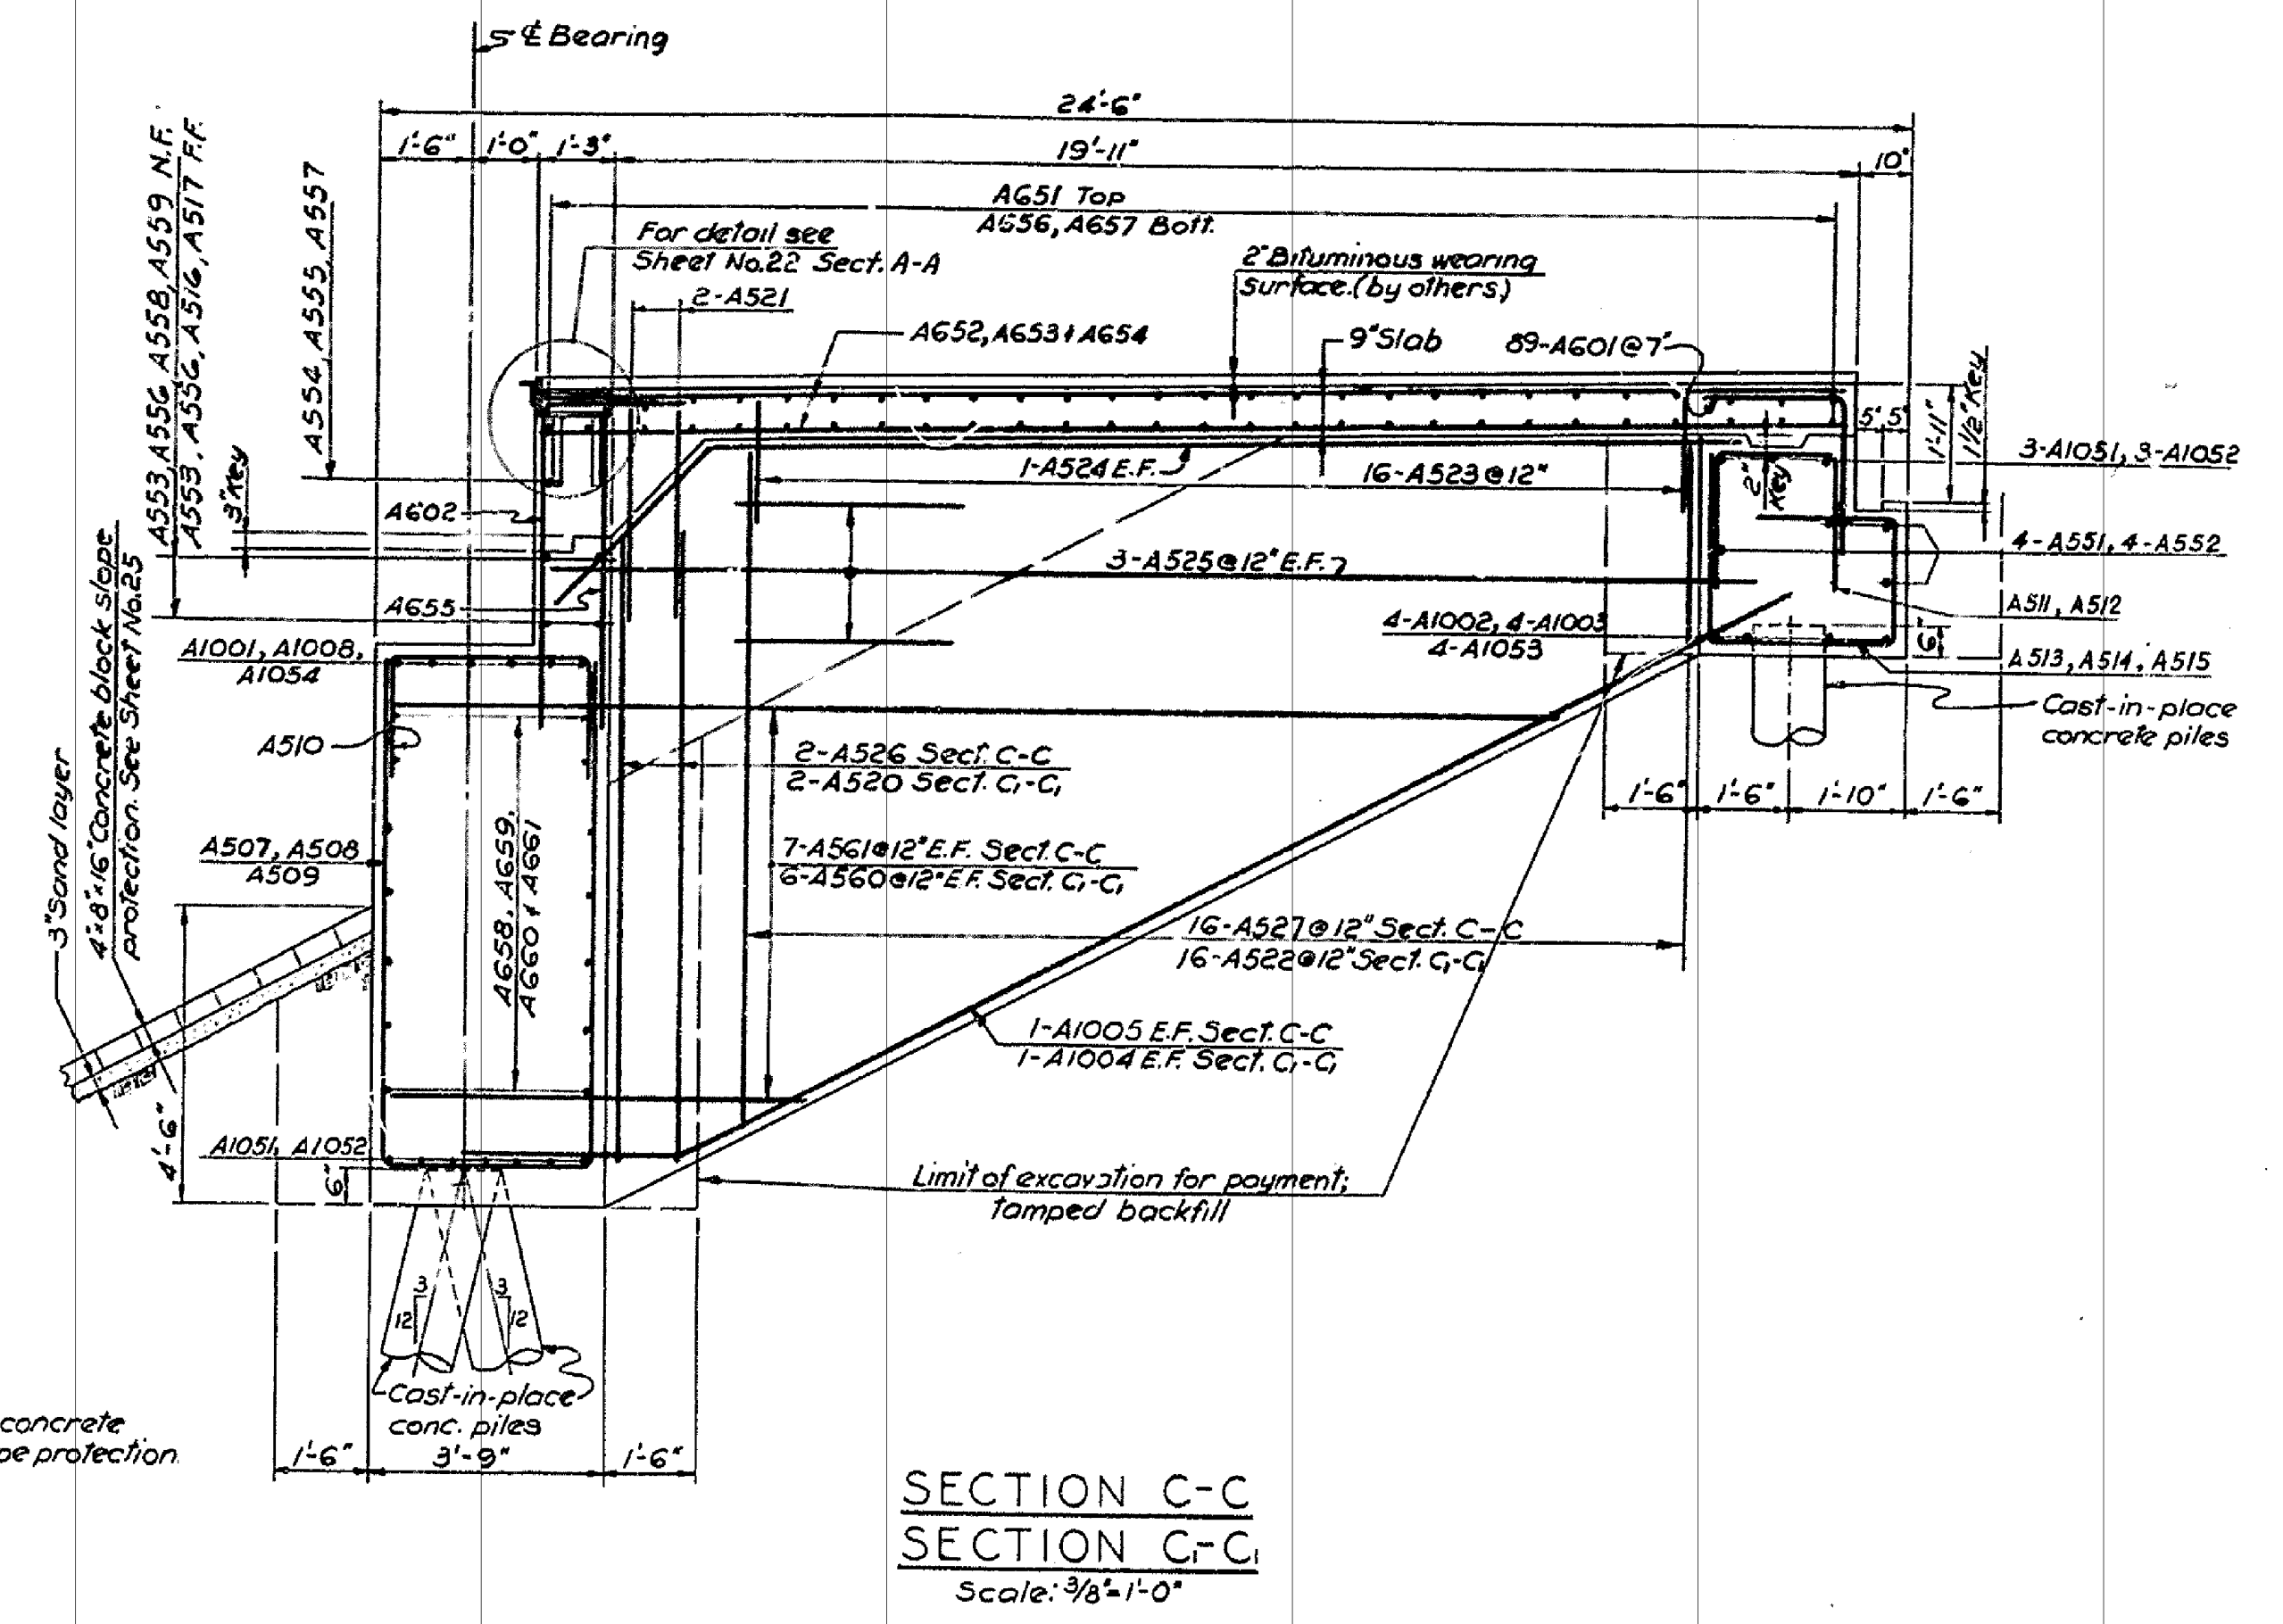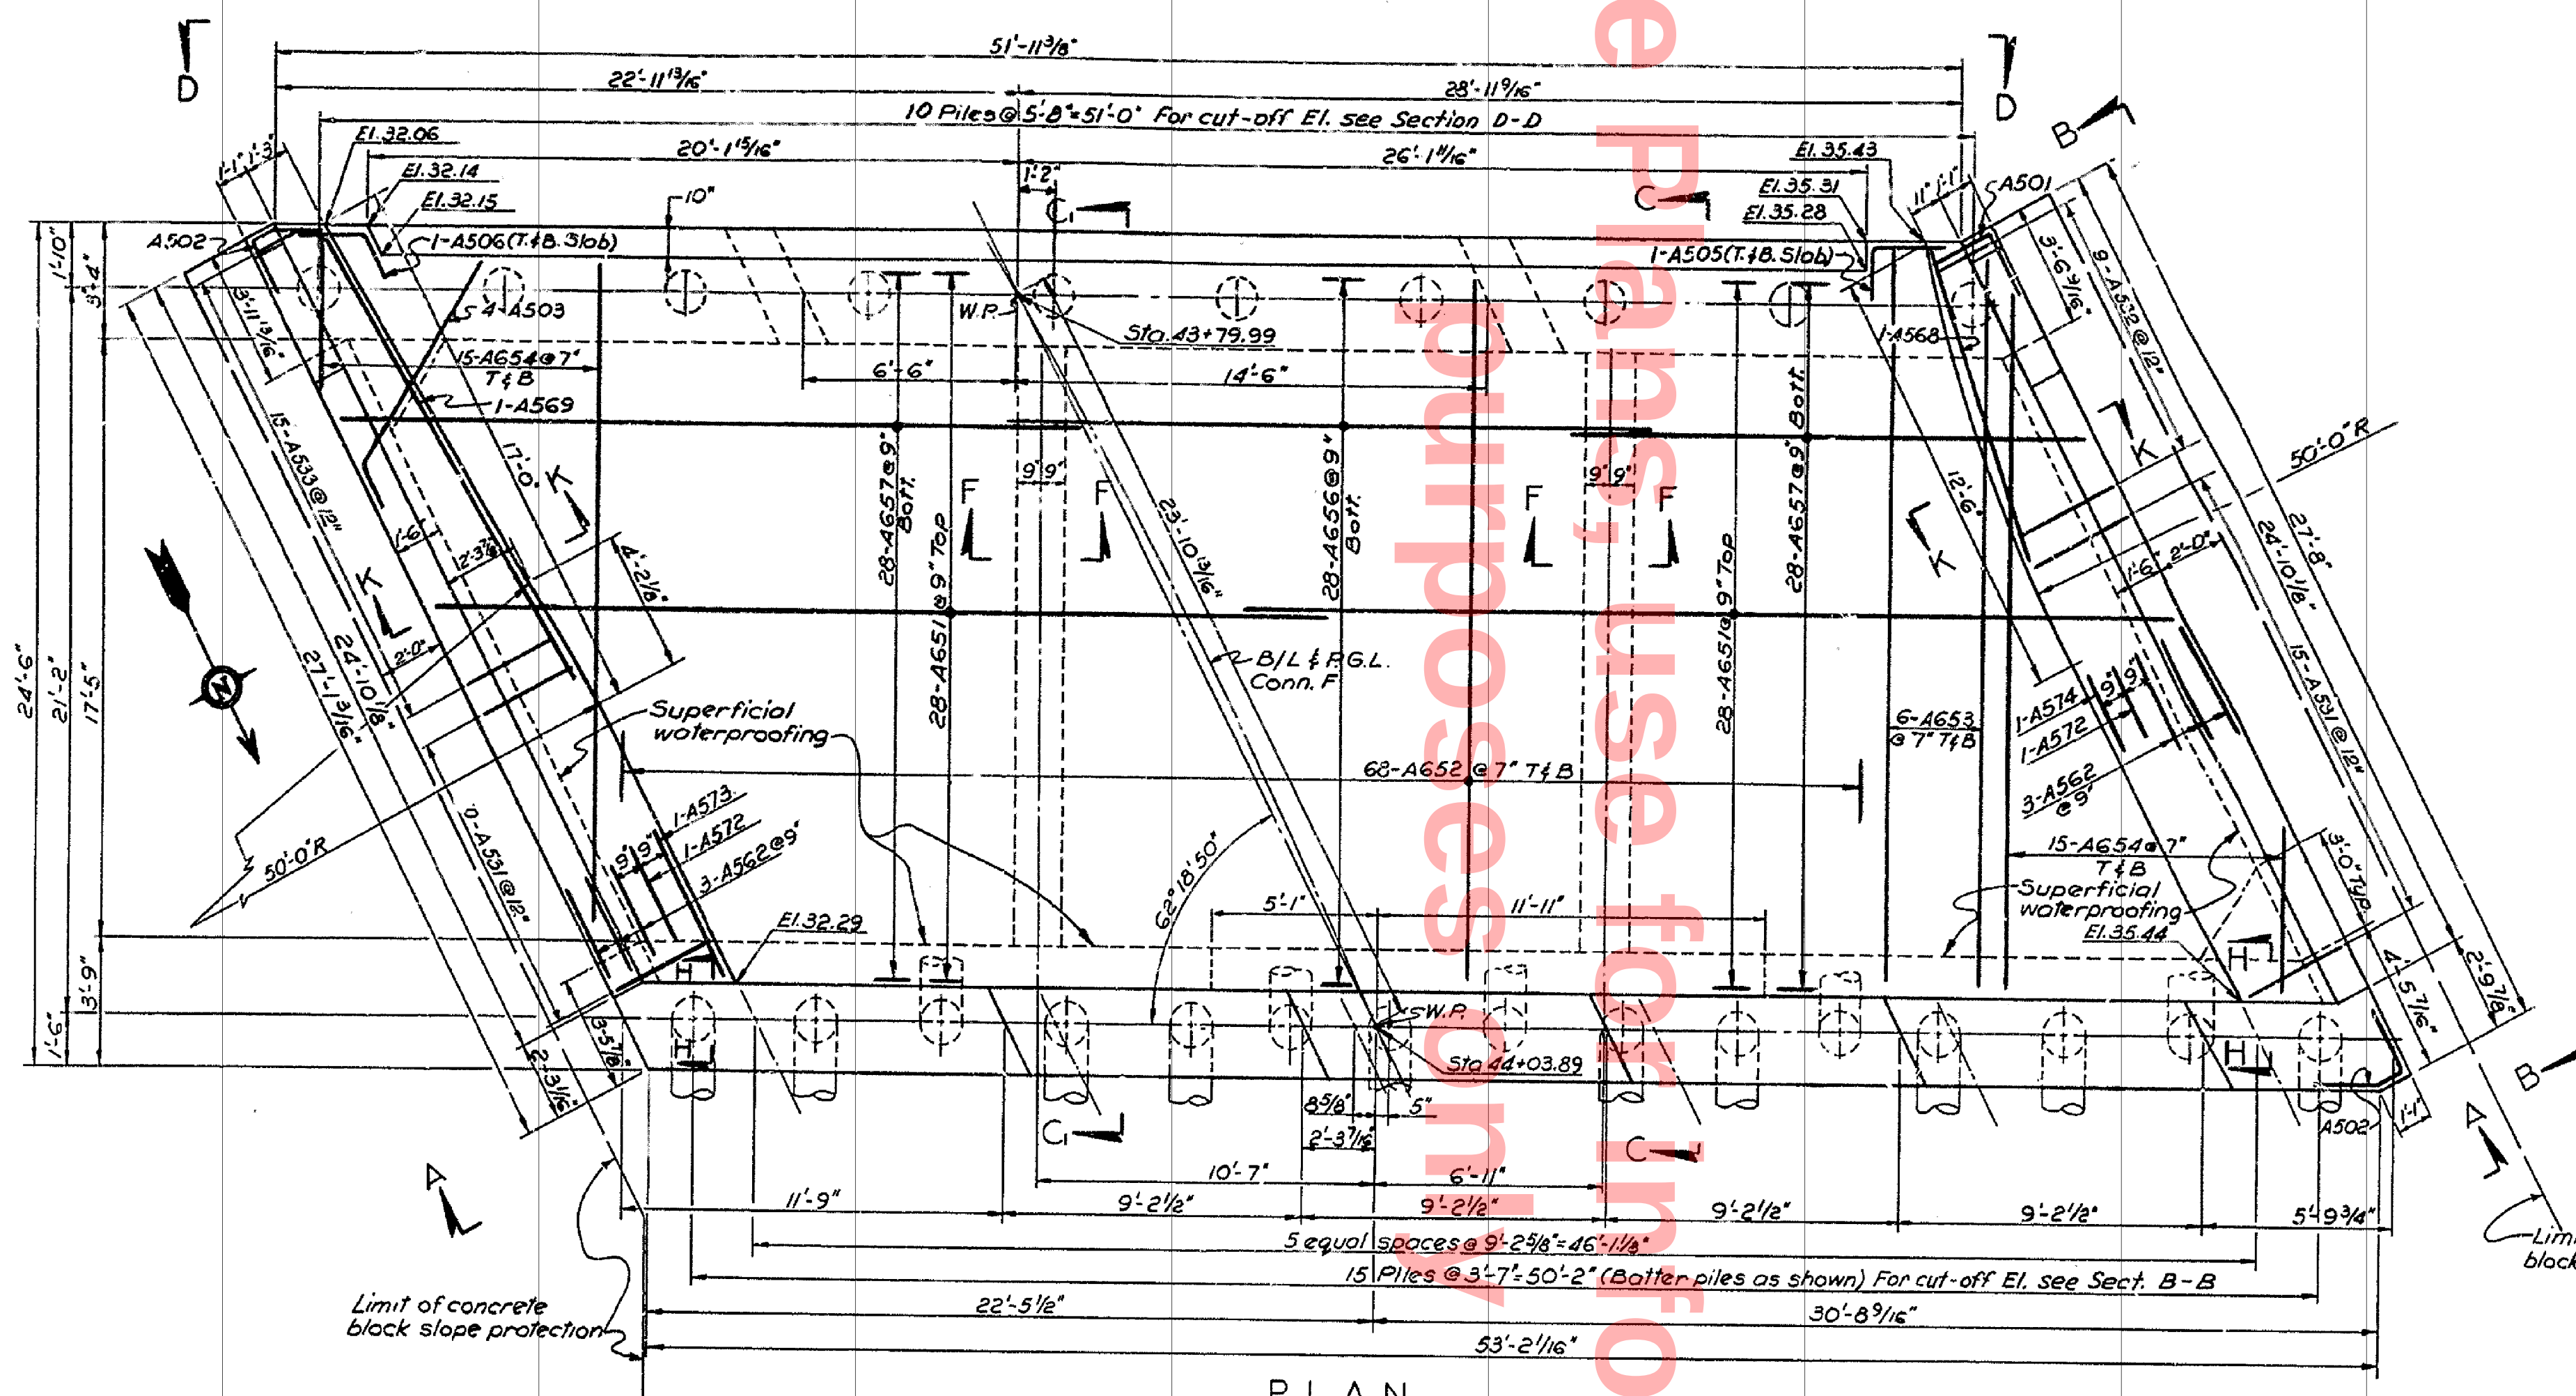

- NOTES:
- For General Notes see Sheet No. 2
 - For Sections F-F, H-H, J-J & K-K, Grillage Under Bearing Plates & Reinforcing Schedule see Sheet No. 18
 - Elevations shown at beam bearings are finished top of masonry elevations. See Section G-G on Sheet No. 18
 - For additional notes see Sheet No. 18
 - For File Details see Sheet No. 5







DELAWARE
STATE HIGHWAY DEPARTMENT
INTERSTATE ROUTE I-1
CHRISTINA RIVER INTERCHANGE
CONNECTION "F" - BRIDGE NO. 6-8
ABUTMENT "A"

J.E. GREINER CO.
MORAN, PROCTOR, MUESER & RUTLEDGE
CONSULTING ENGINEERS

DESIGNED: D.H. CHECKED: M.A.G. DATE: 7/21/93
DR: W.N. IN CHARGE: W.N. SCALE: AS SHOWN

APPROVED *[Signature]*
BRIDGE ENGINEER

COUNTY	CONTRACT	F.A.A. MAP NO.	STATE	FED. AID PROJECT NO.	FISCAL YEAR	SHEET NO.	TOTAL SHEETS
NEW CASTLE	6401063211	2	DEL.	1-95-1(13)		17	26

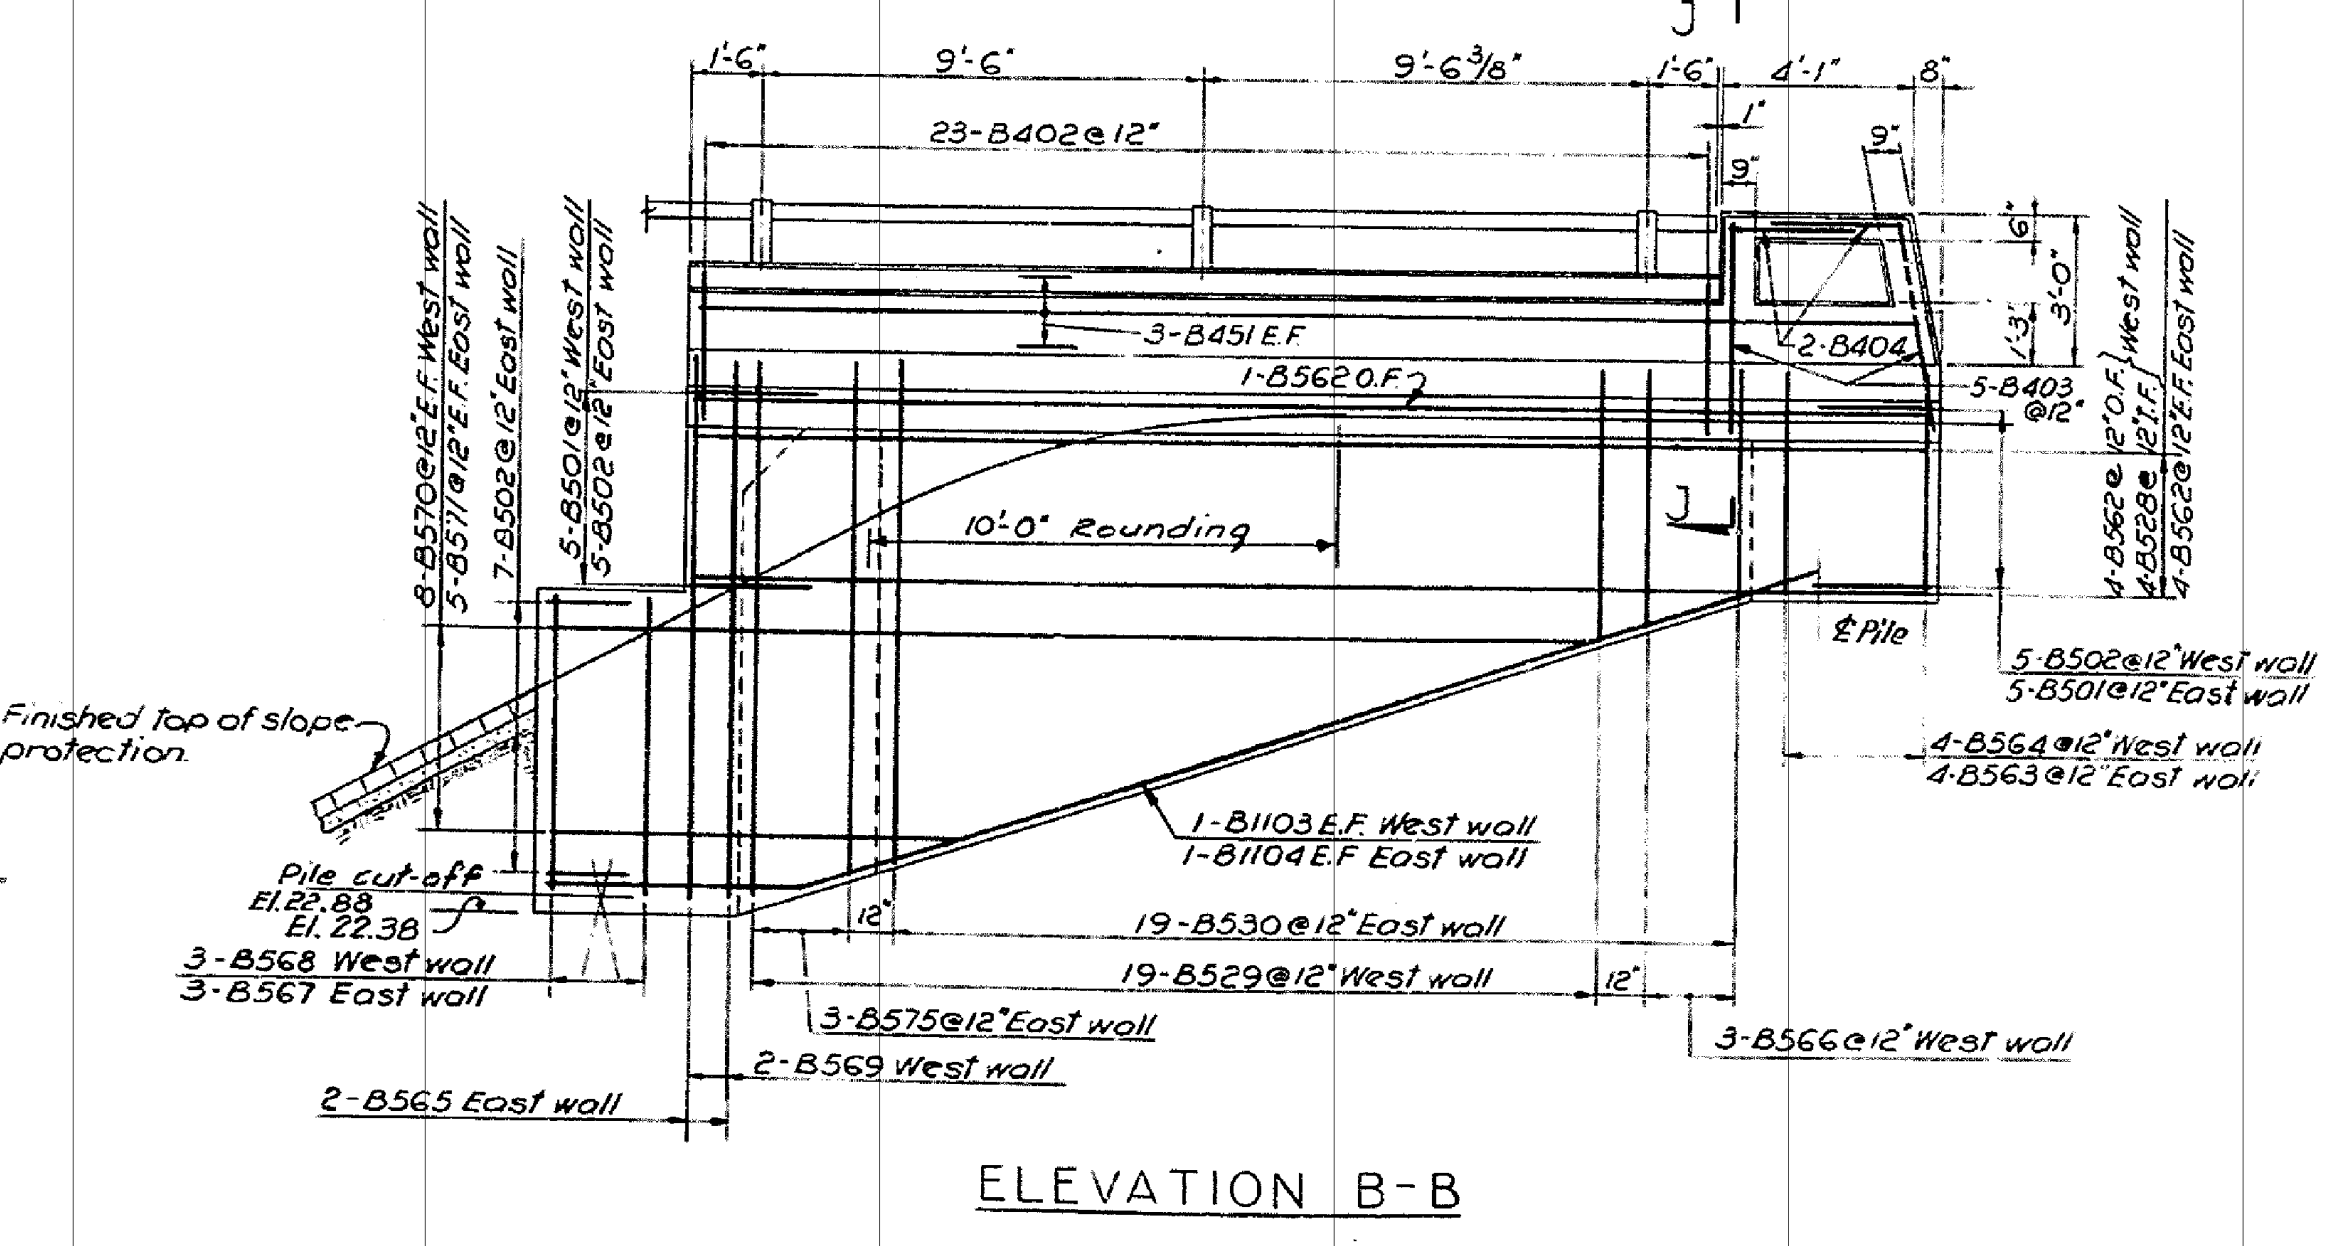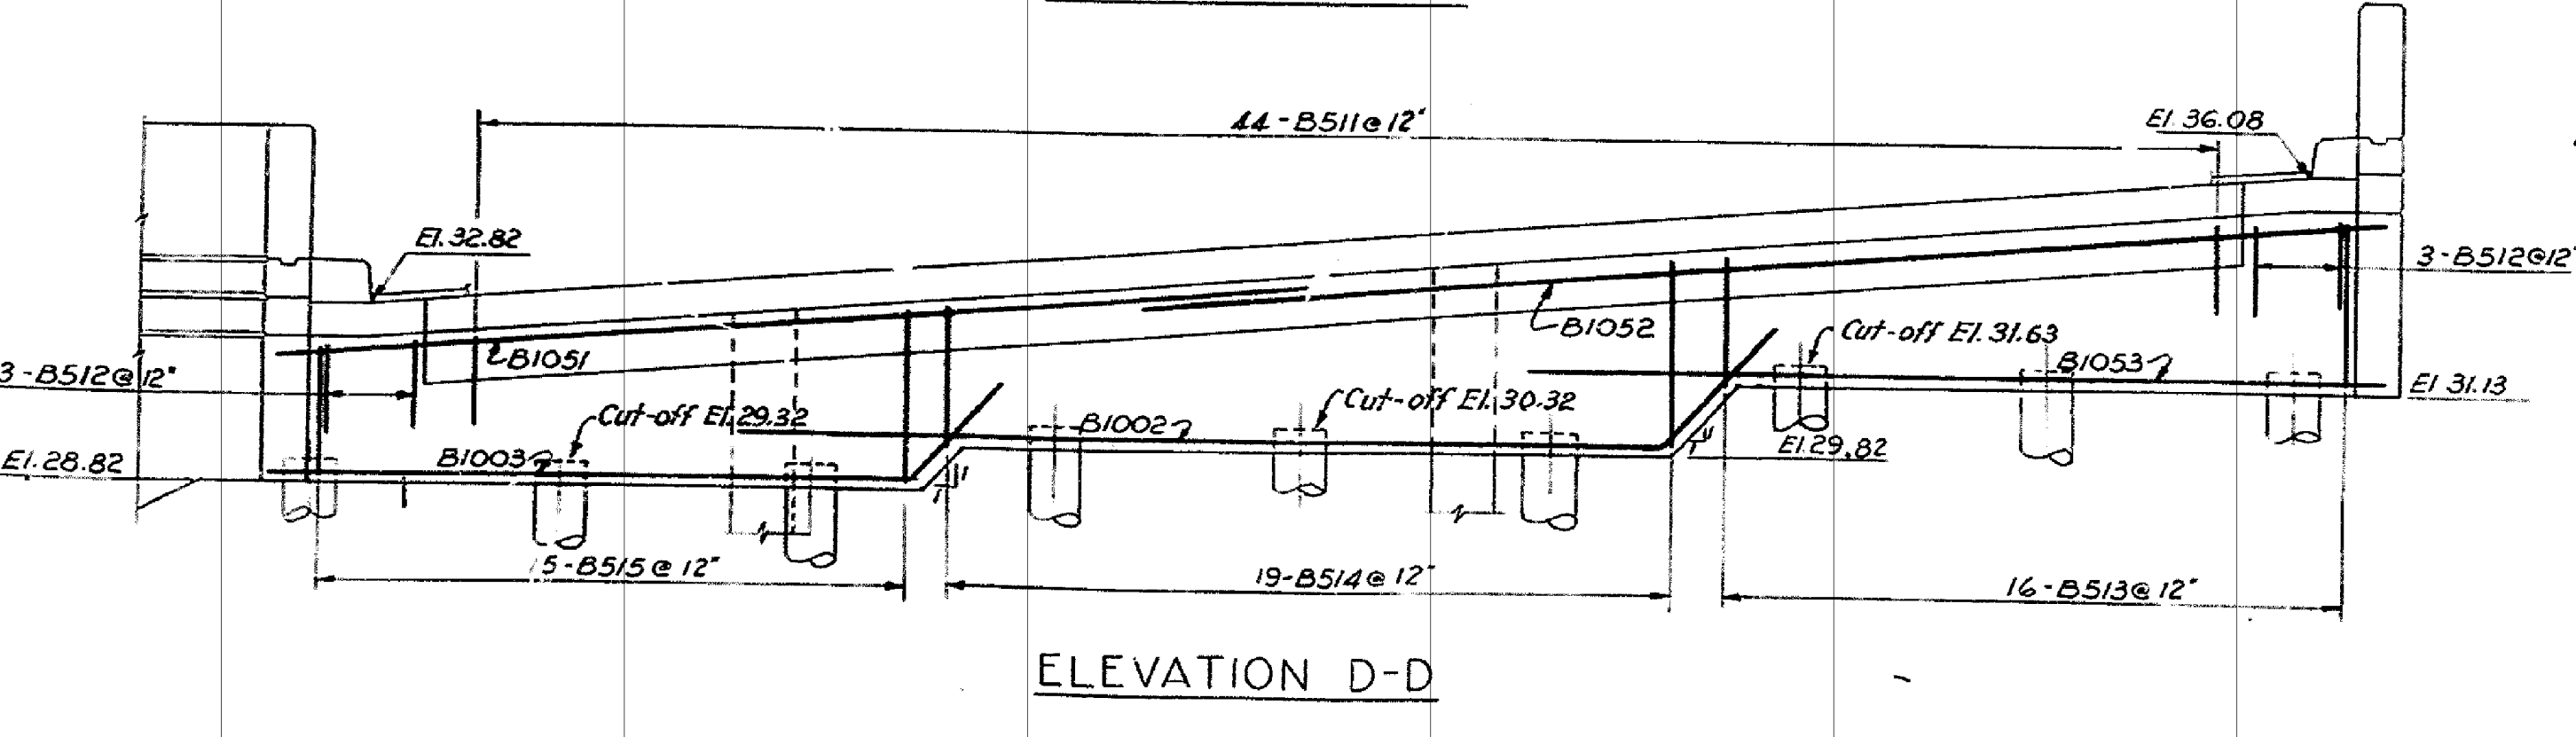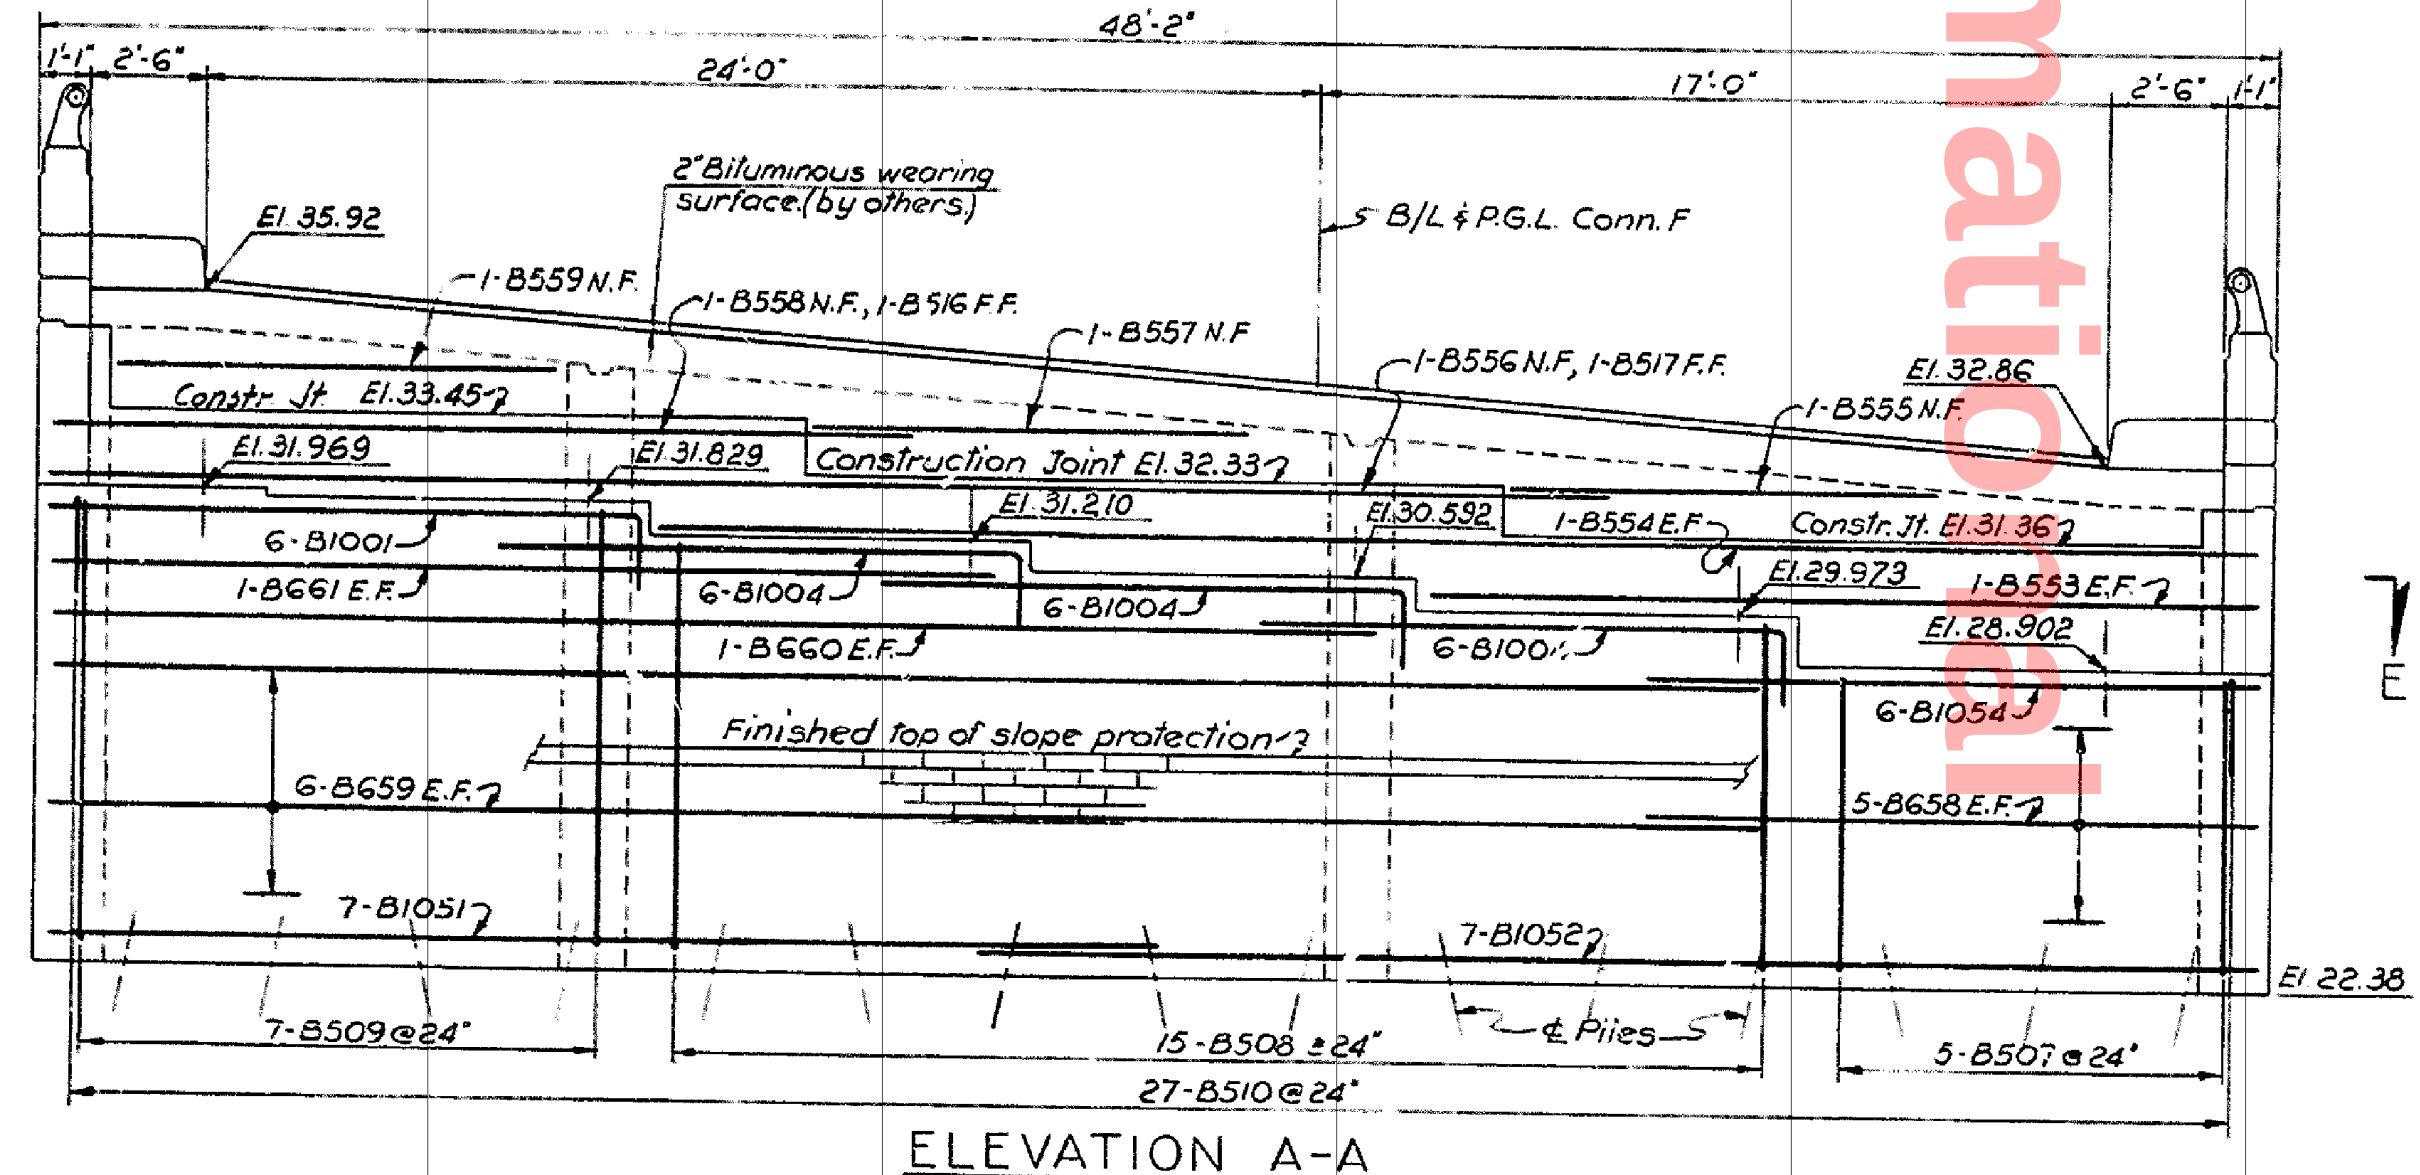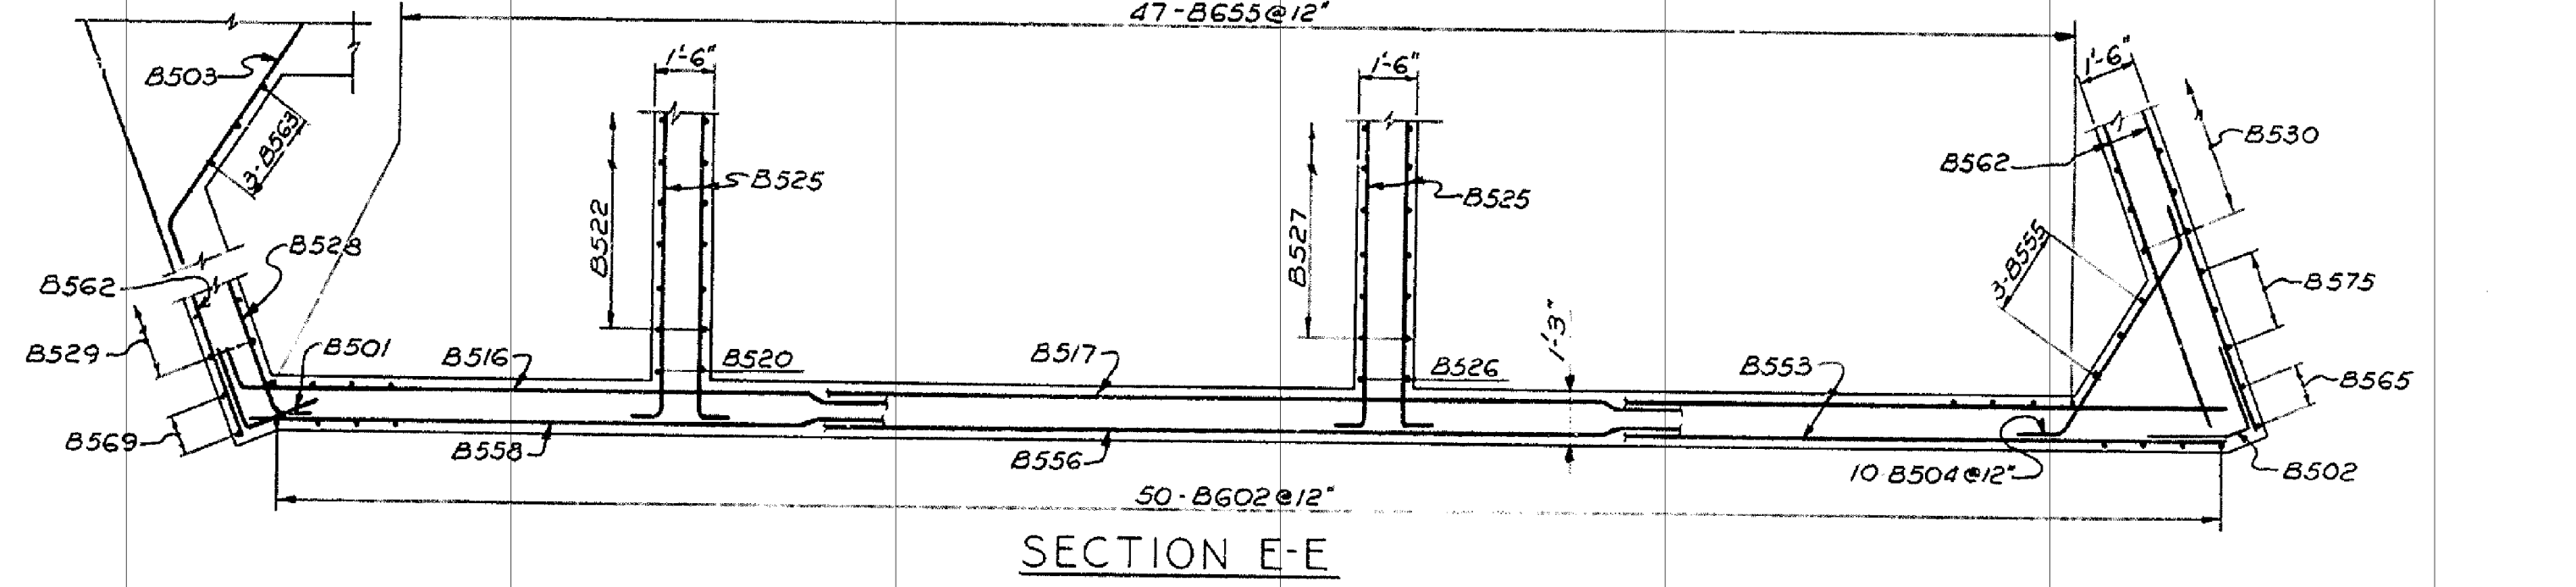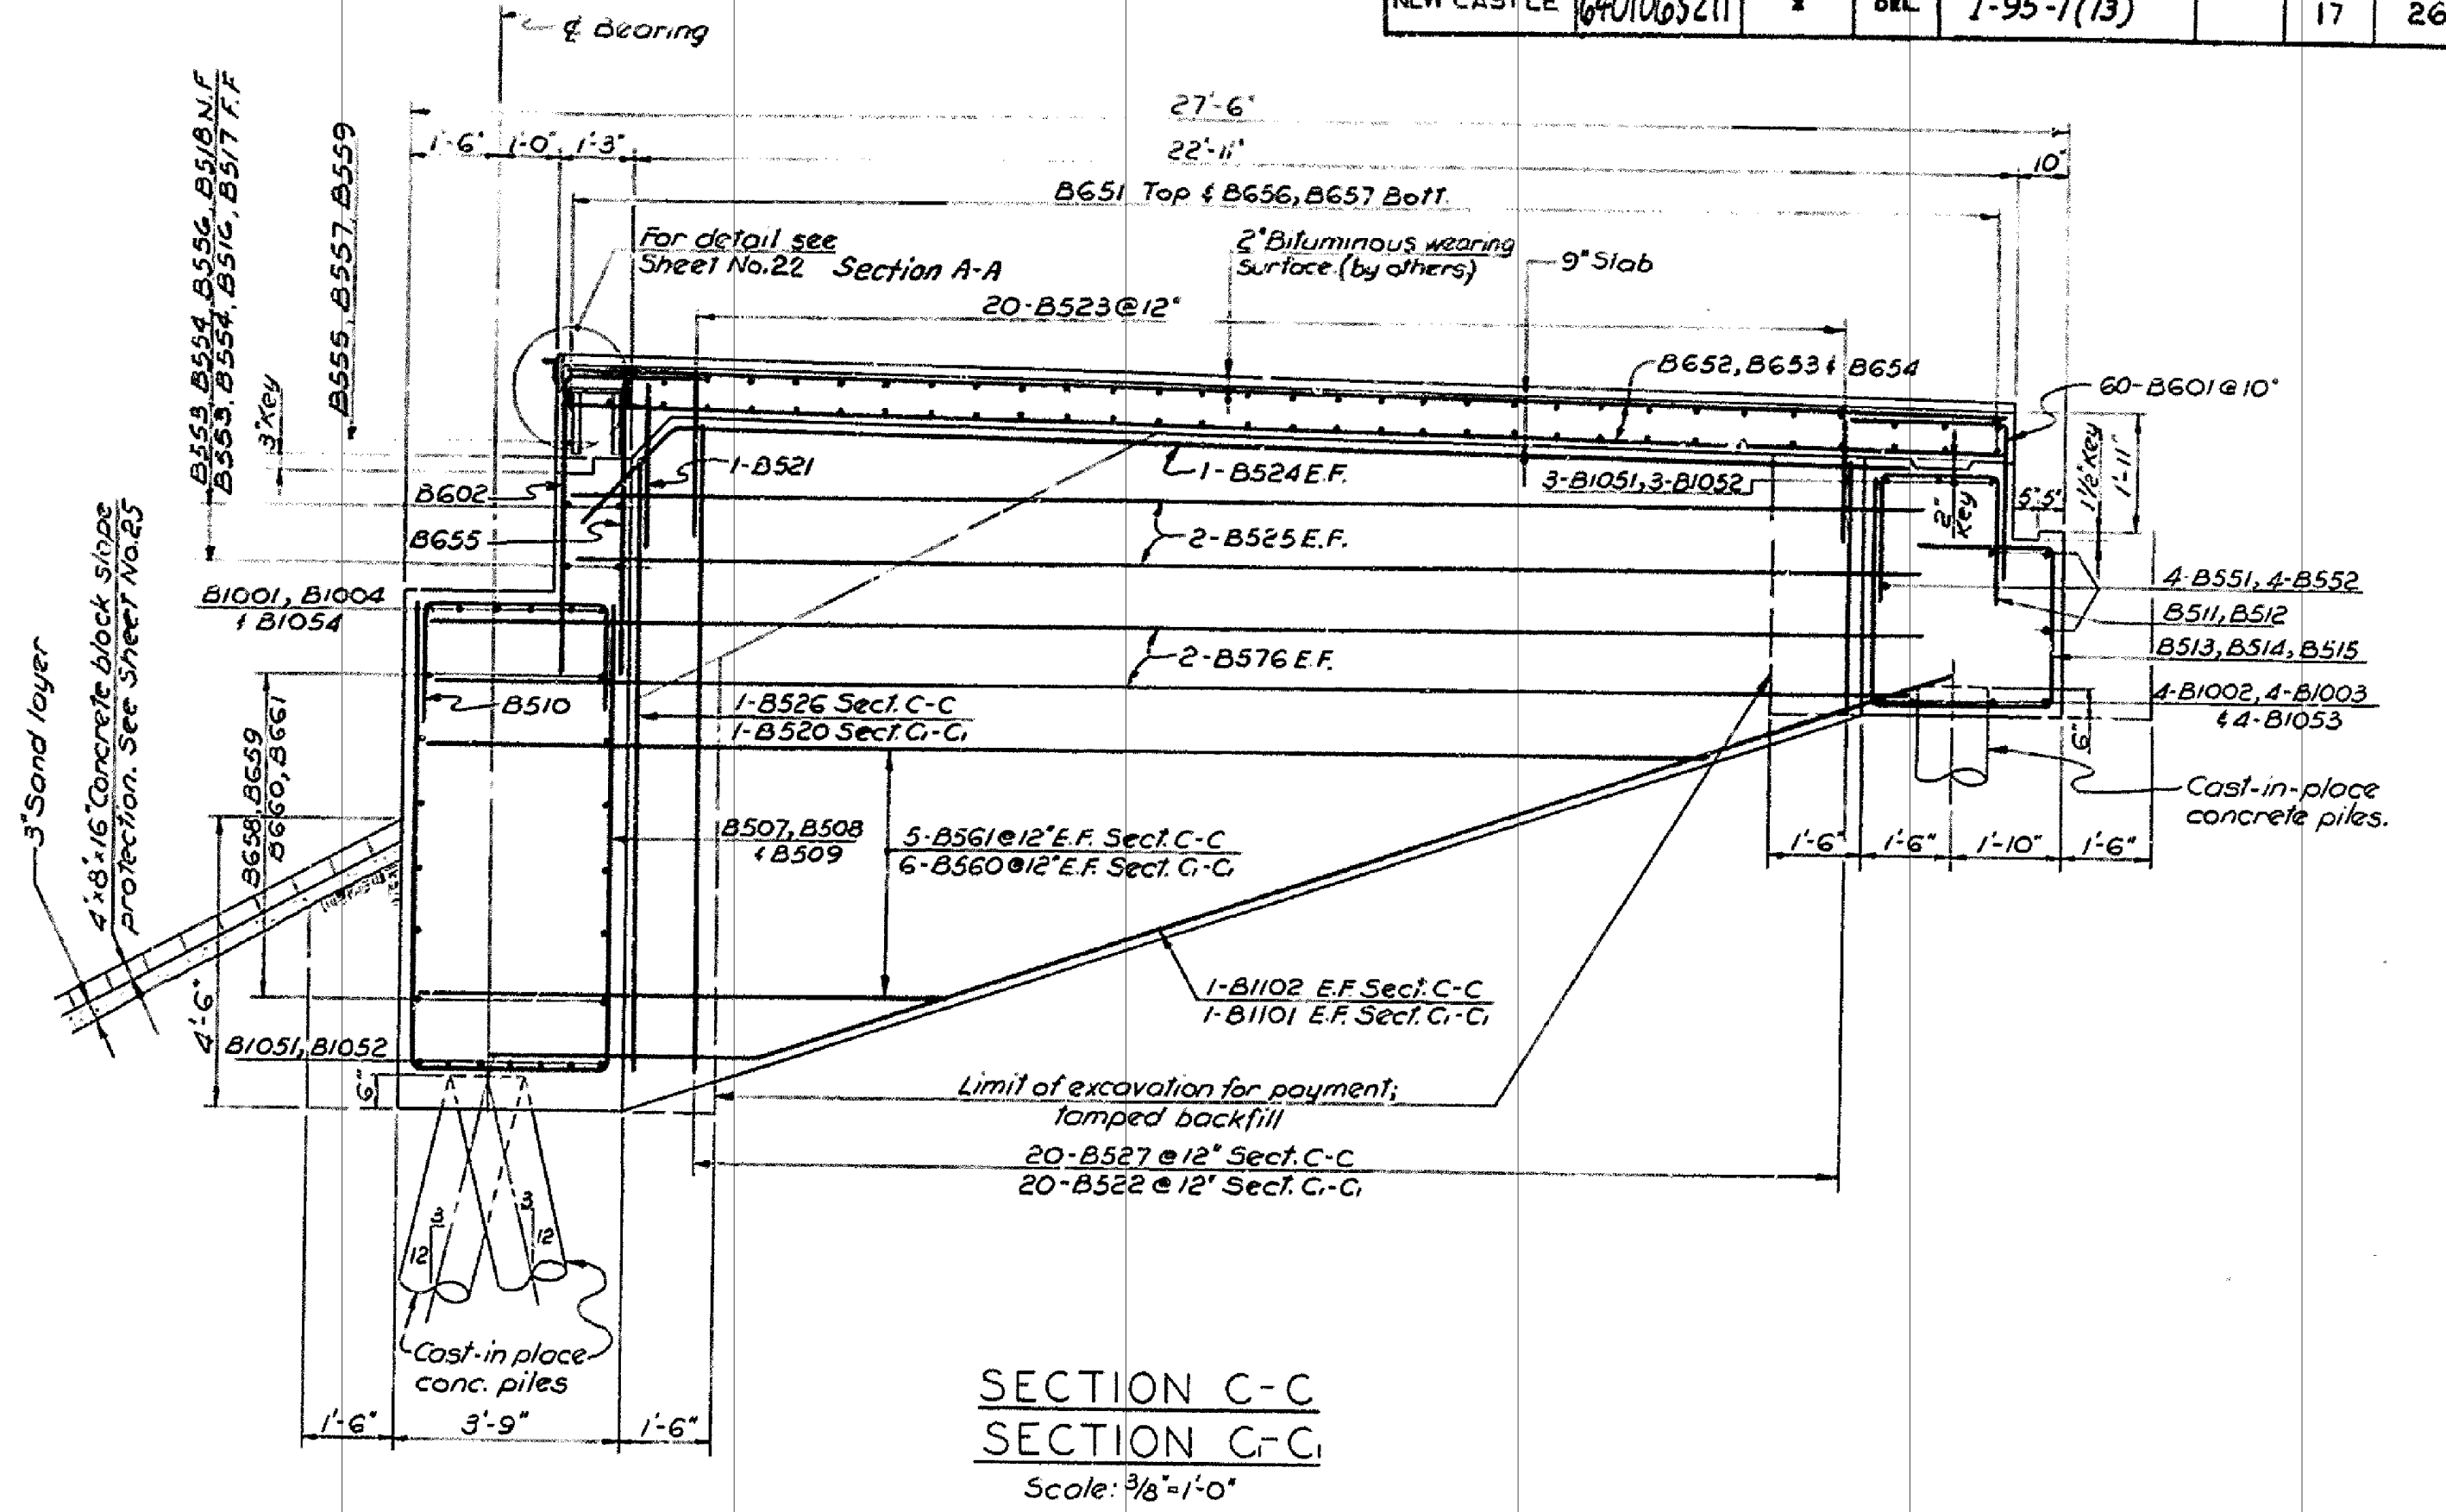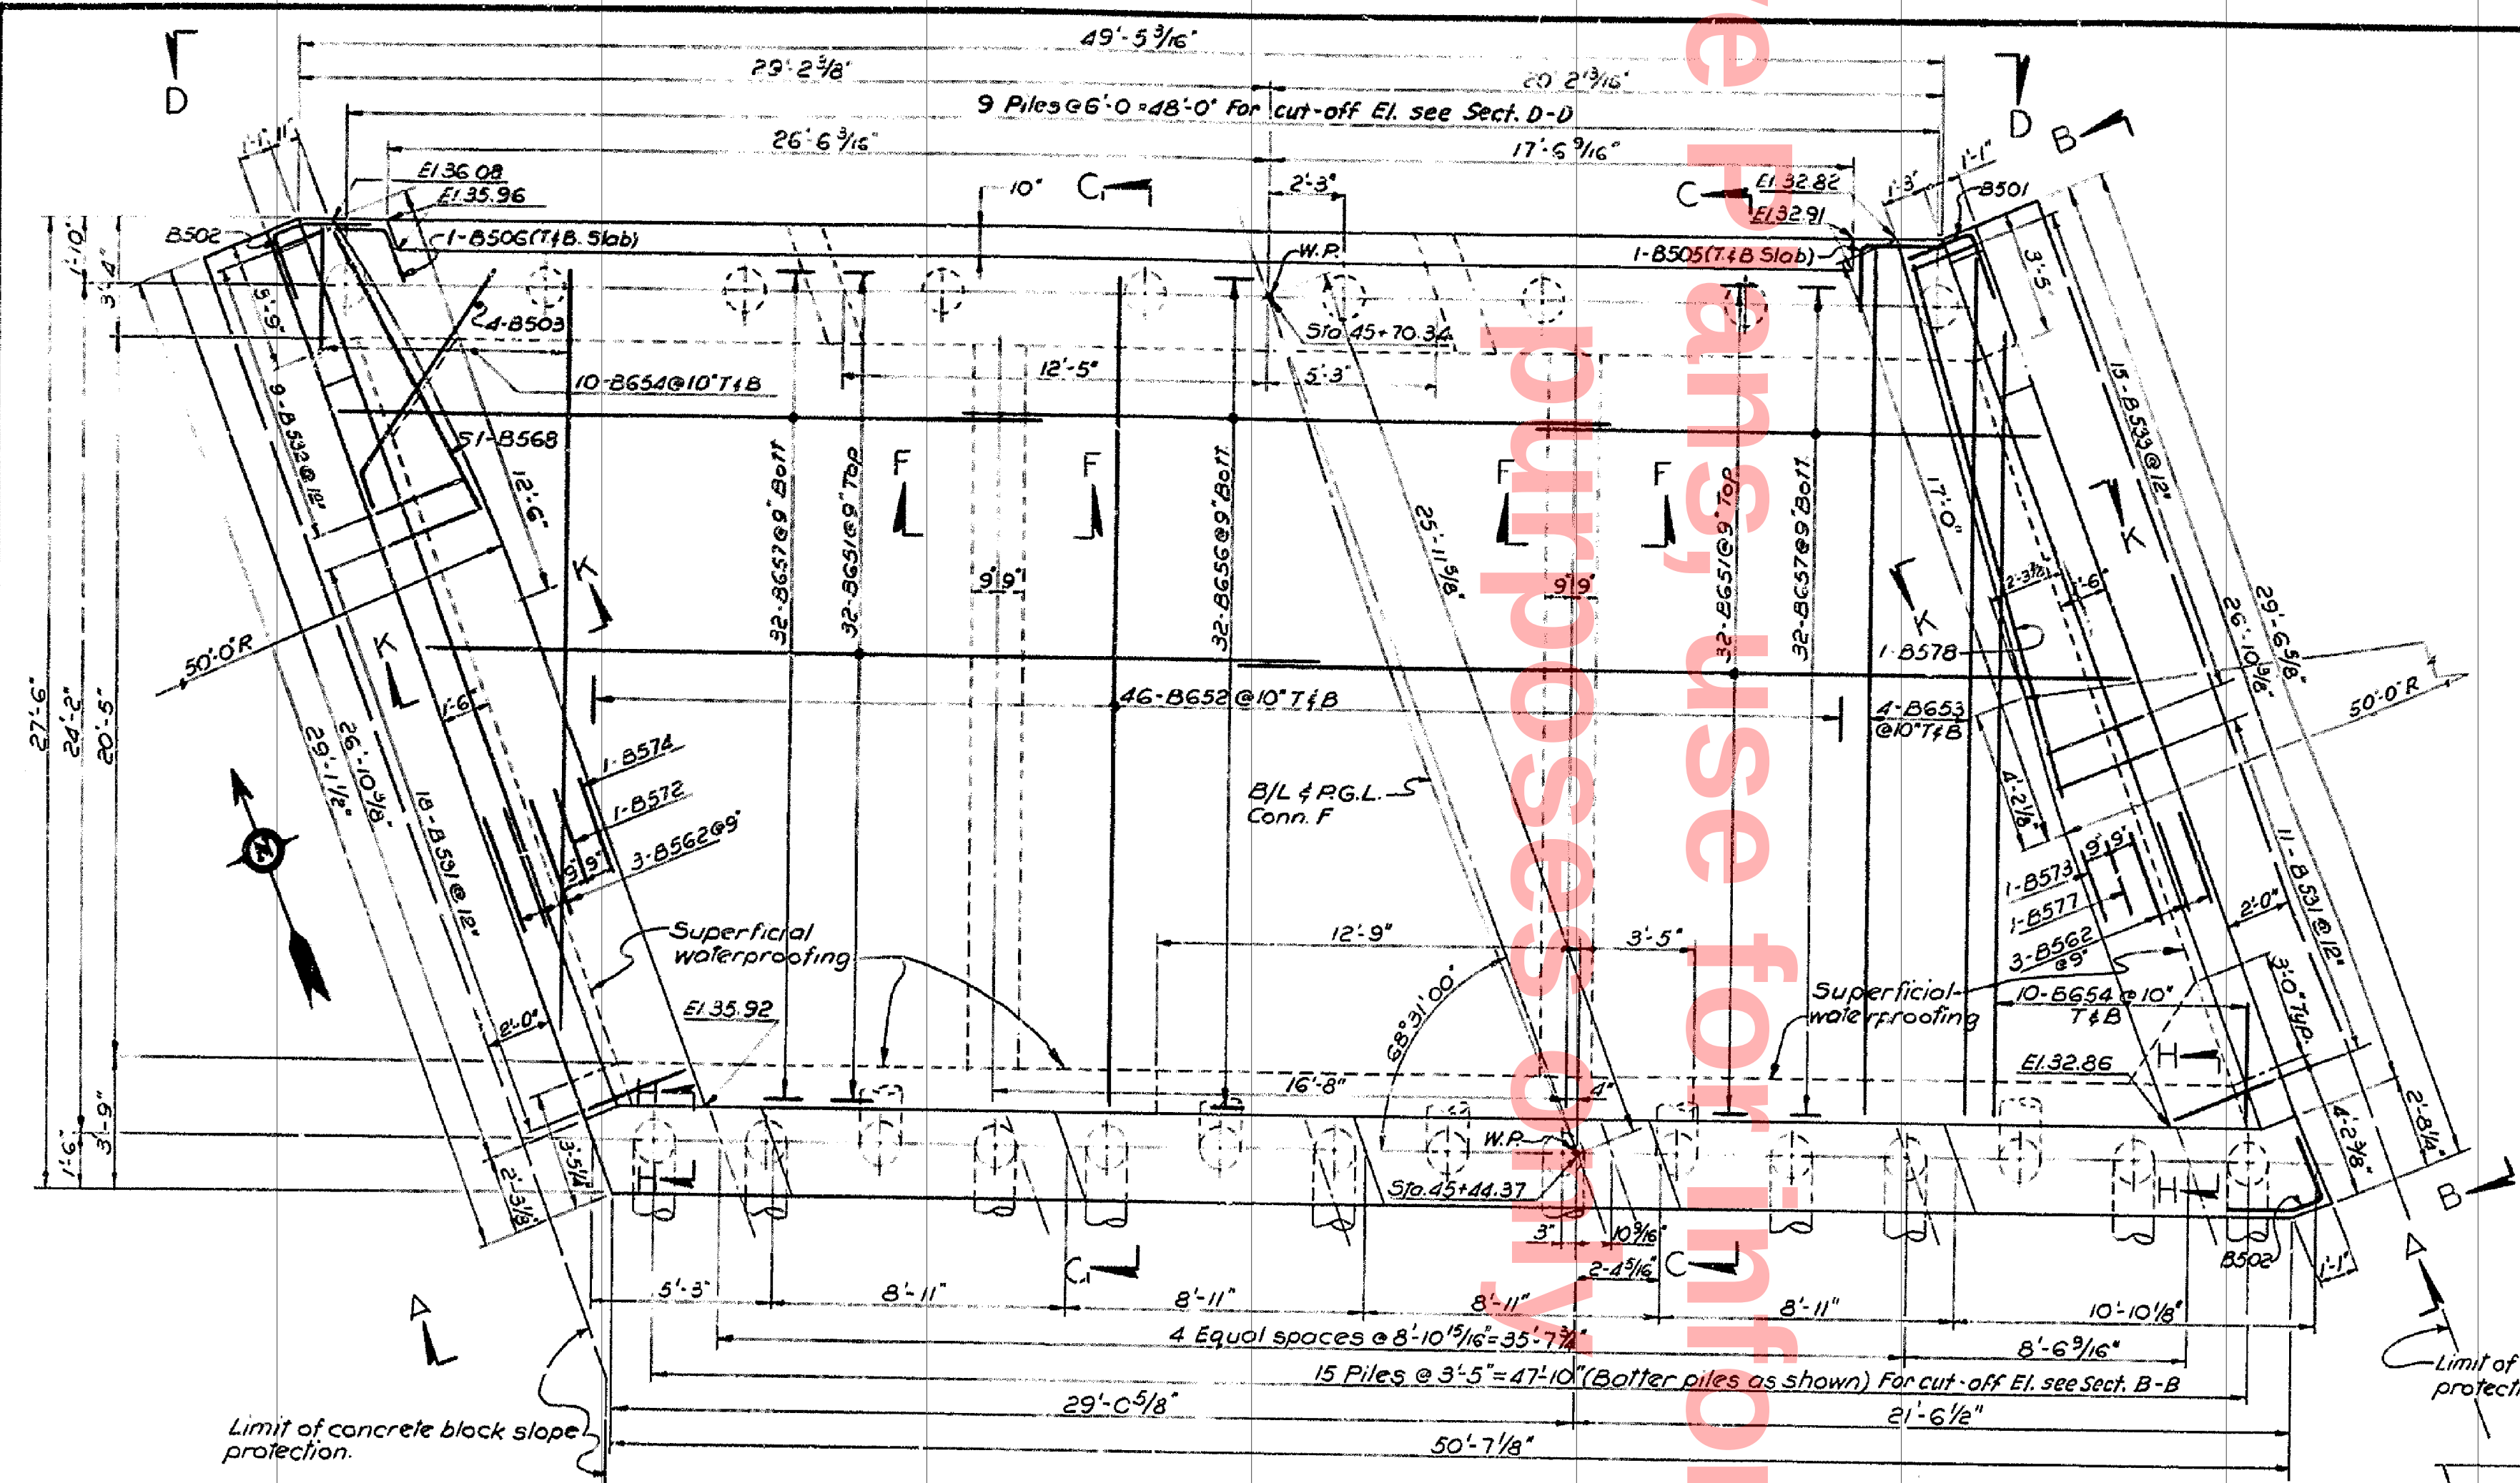

- NOTES:
- For General Notes see Sheet No. 2
 - For Sections F-F, H-H, J-J & K-K, Grillage Under Bearing Plates & Reinforcing Schedule see Sheet No. 18
 - Elevations shown of beam bearings are finished top of masonry elevations. See Section G-G on Sheet No. 18
 - For additional notes see Sheet No. 18
 - For Pile Details see Sheet No. 5

DELAWARE STATE HIGHWAY DEPARTMENT

INTERSTATE ROUTE FAI-1

CHRISTINA RIVER INTERCHANGE

CONNECTION "F" - BRIDGE NO. 6-8

ABUTMENT "B"


J.E. GREINER CO.
MORAN, PROCTOR, MUESER & RUTLEDGE
CONSULTING ENGINEERS

DESIGNED: M.A.G. CHECKED: A.H. DATE: 7/31/59
DRAWN: R.E. IN CHARGE: N.Y.K. SCALE: 1/8"=1'-0"


APPROVED BRIDGE ENGINEER

REINFORCING SCHEDULE FOR ABUTMENT "A"


REINFORCING SCHEDULE FOR ABUTMENT 'B'

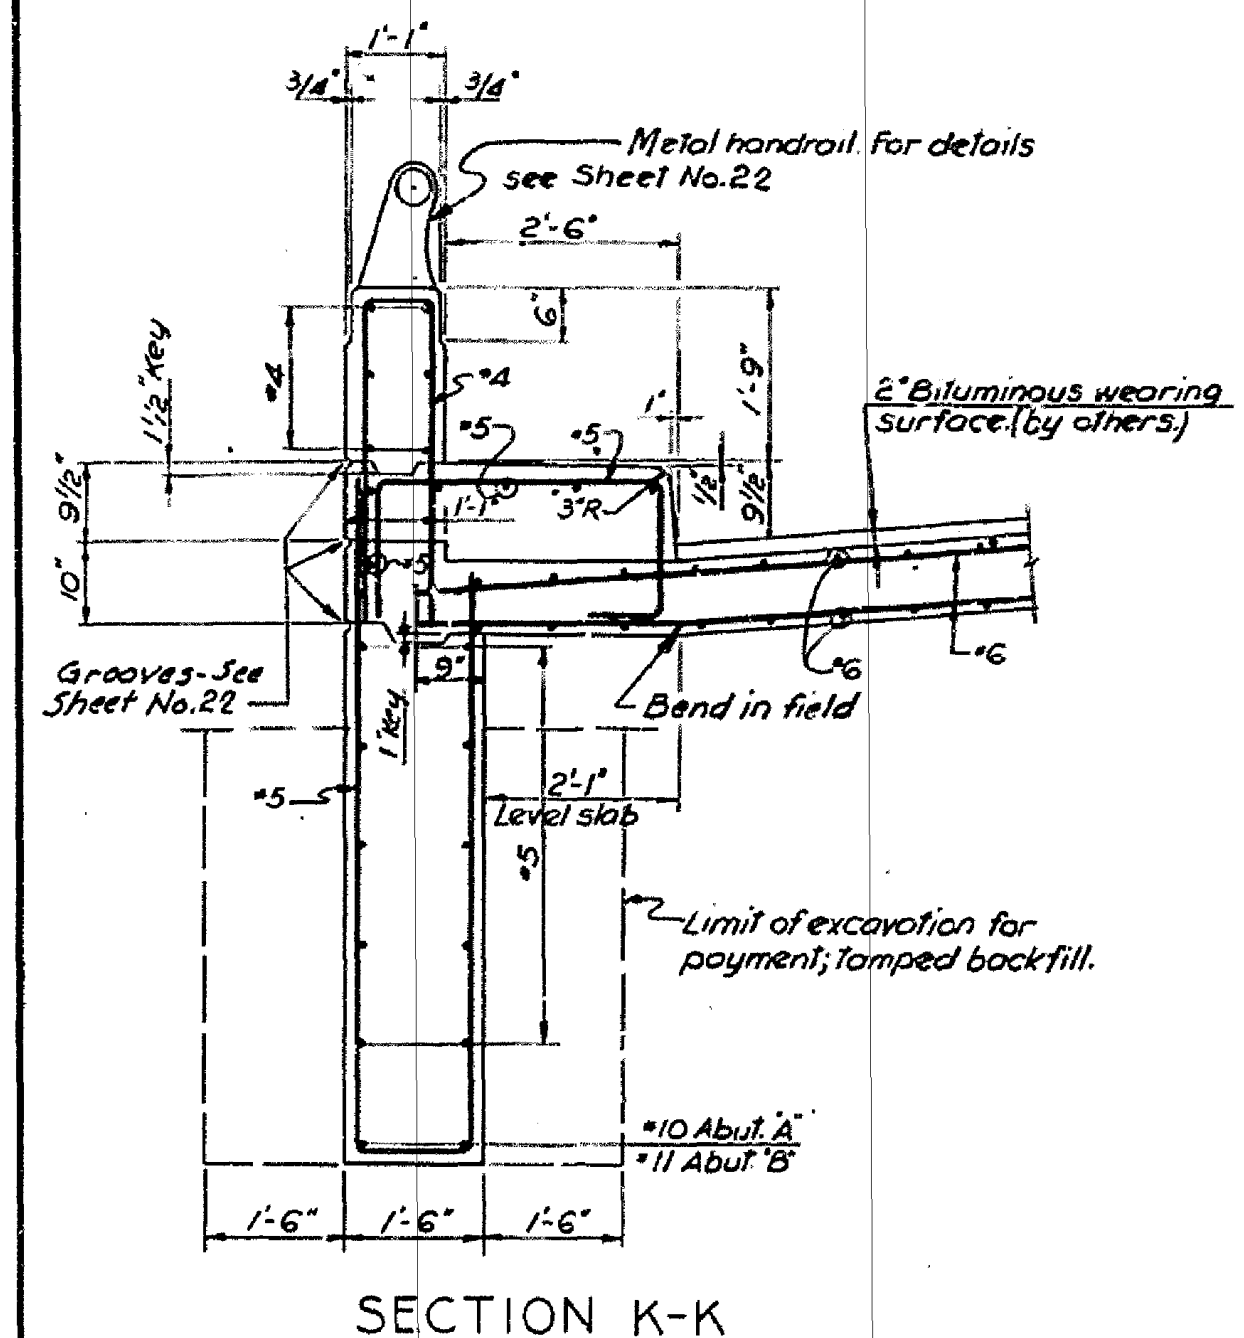


SECTION K-K

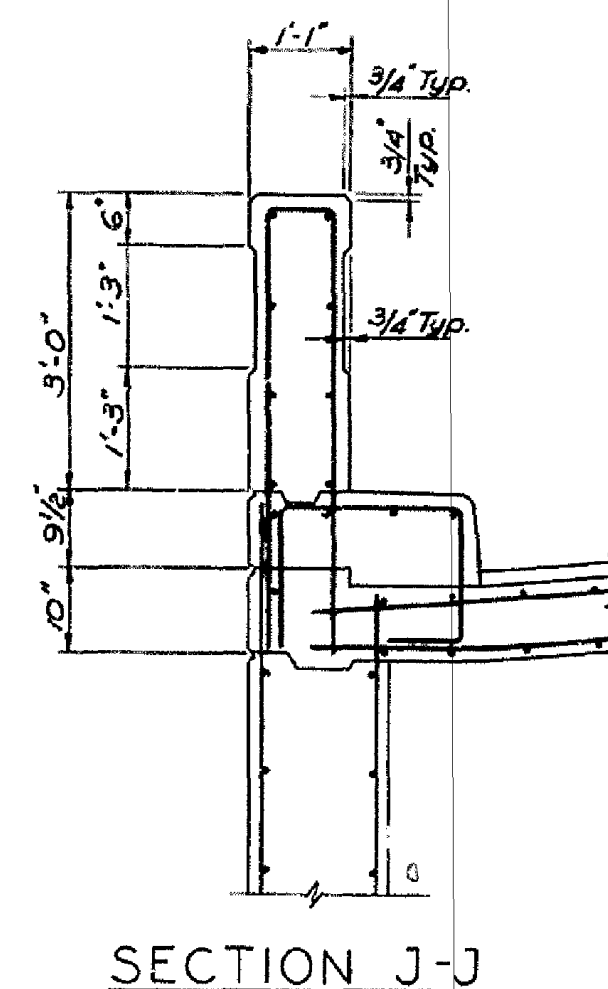


SECTION J-J

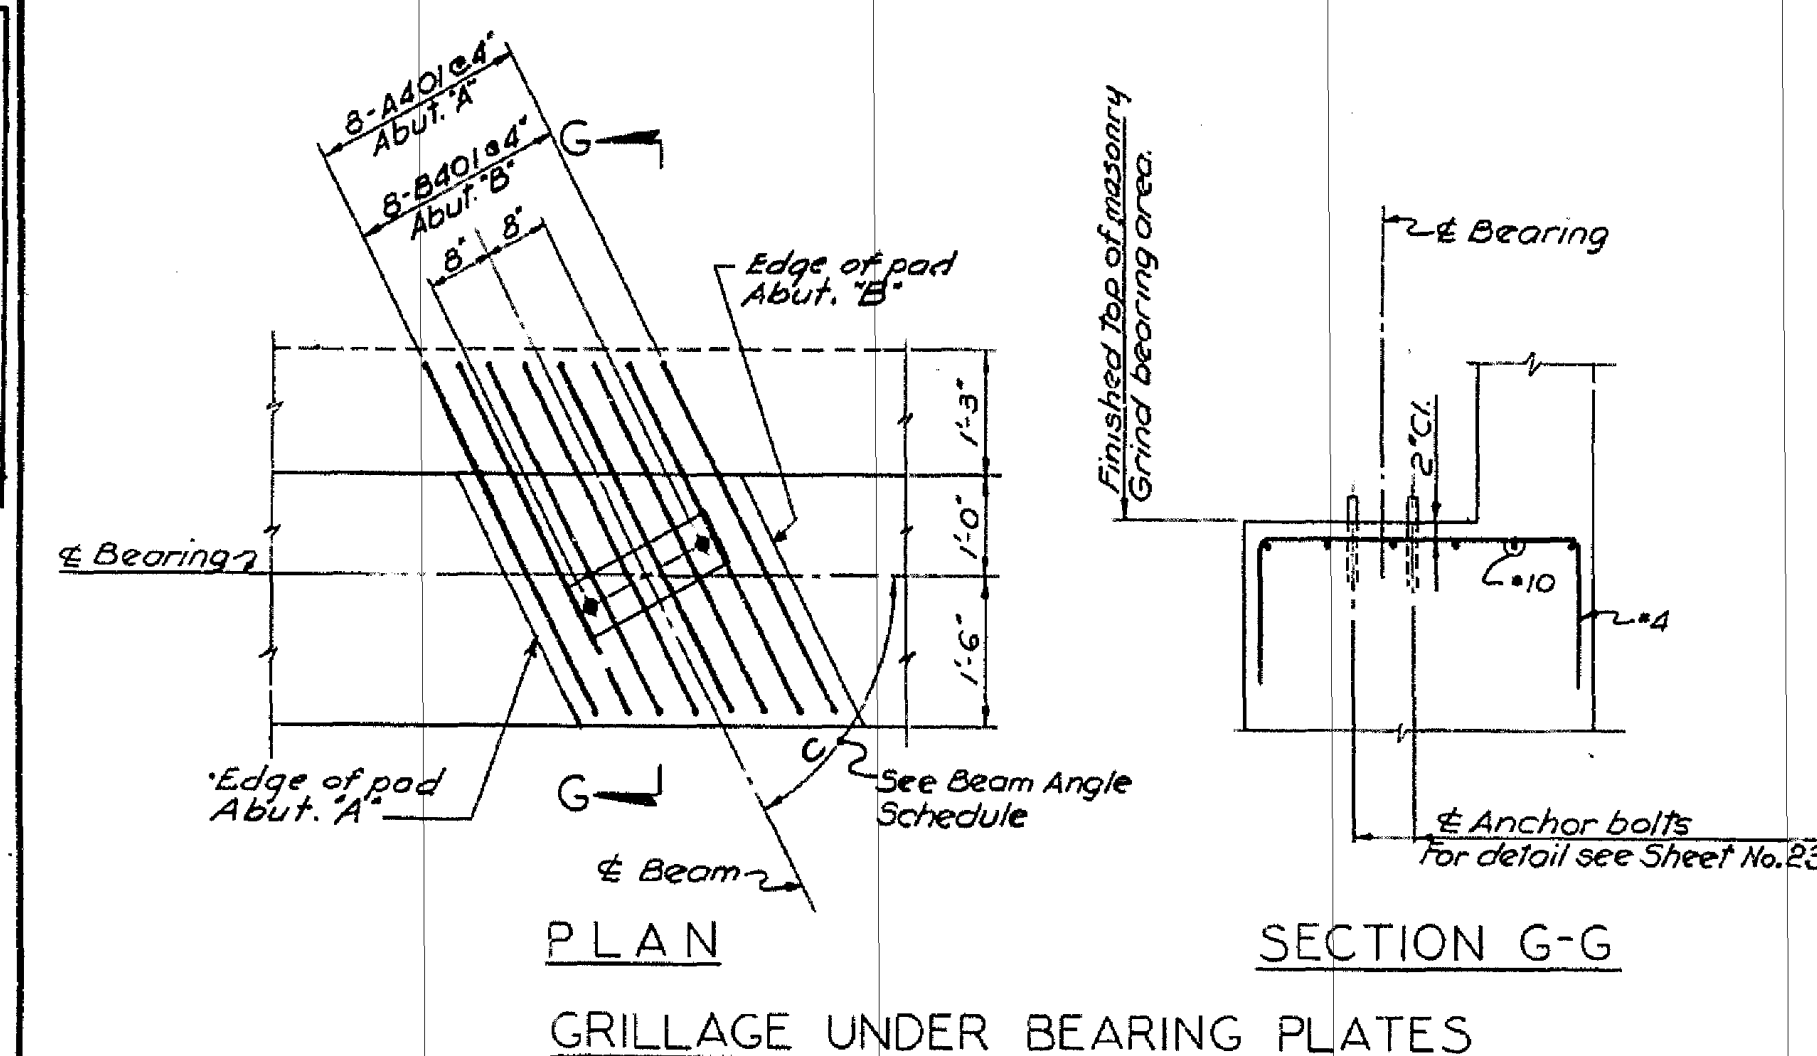


<u>PLAN</u>	<u>SECTION</u>
GRILLAGE UNDER BEARING PLATES	

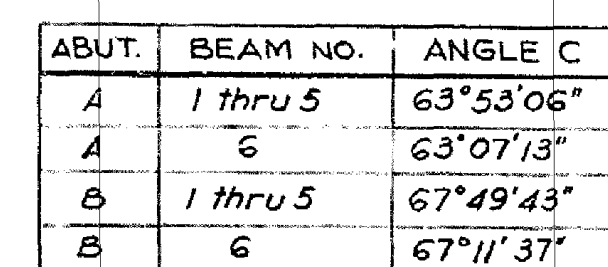

BEAM ANGLE SCHEDULE

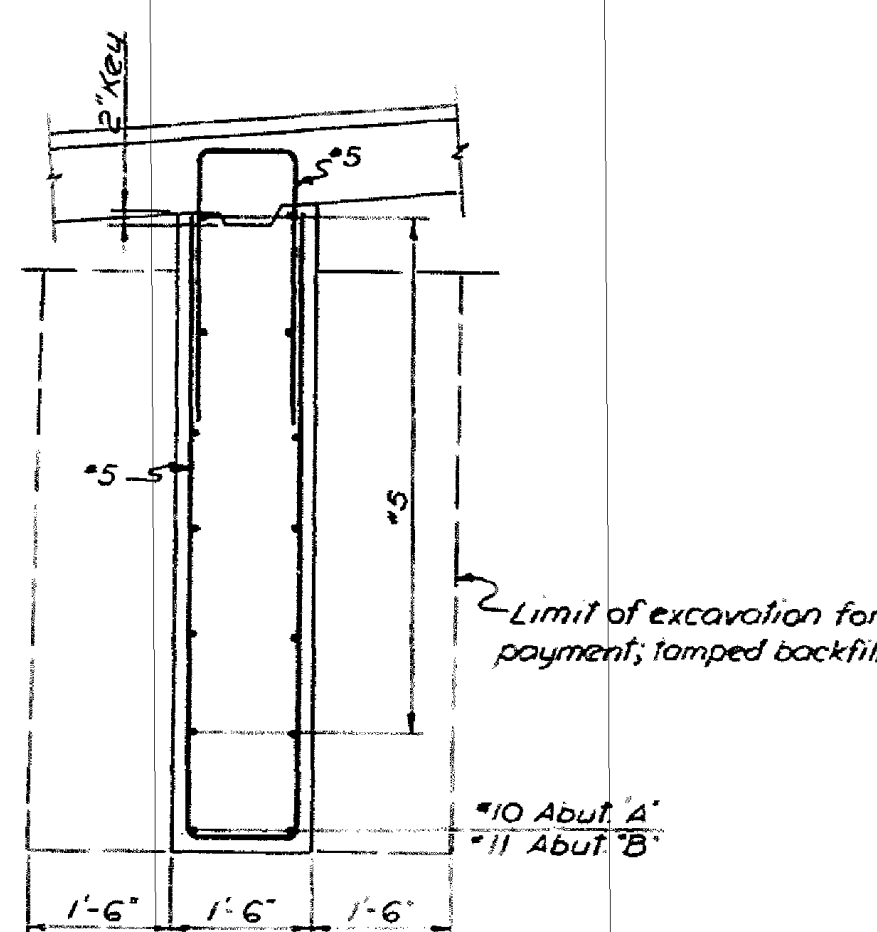

SECTION F-F

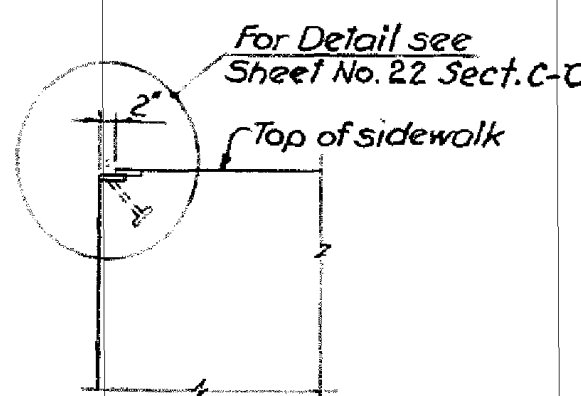

SECTION H-H

BENT BARS (All dimensions are out to out)												
MARK	NO	SIZE	LENGTH	TYPE	A	B	C	D	E	F	G	REMARKS
A401	48	*4	6-11	1	1-6	3-11	1-6					
A402	42	1	7-0	1	3-2	0-8	3-2					
A403	10	1	9-6	1	4-5	0-8	4-5					
A404	4	*4	6-3	1	2-10	0-7	2-10					
A501	50	*5	4-0	1	2-0	2-0						
A502	18	1	4-11	6	2-0	0-11	2-0	1-9	0-11			
A503	4	1	8-6	2	6-9	1-9				1-7	10"	
A504	13	1	6-9	5	3-0	0-9	0-9	8"	5"	8"	5"	
A505	2	1	5-0	1	2-0	3-0						
A506	2	1	5-0	2	3-0	2-0				1-9	11"	
A507	6	1	15-1	1	5-10	3-5	5-10					
A508	20	1	16-9	1	6-8	3-5	6-8					
			20-9	8	8	8	8					5 bars each
A509	3	1	21-5	1	9-0	3-5	9-0					
A510	29	1	7-1	1	1-10	3-5	1-10					
A511	47	1	6-2	1	2-0	2-2	2-0					
A512	6	1	7-0	1	2-0	3-0	2-0					
A513	15	1	9-5 11-2	4	2-3	1-7 2-5 1/2	3-0	2-7 3-5 1/2				Increment = 3/4"
A514	23	1	9-5 12-2	4	2-3	1-7 2-11 1/2	3-0	2-7 3-11 1/2				Increment = 3/4"
A515	15	1	9-5 11-2	4	2-3	1-7 2-5 1/2	3-0	2-7 3-5 1/2				Increment = 3/4"
A516	1	1	39-10	2	0-9	39-1	-			8"	5"	
A517	1	1	21-5	2	0-9	20-8	-			8"	5"	
A520	2	1	18-6	1	8-8	1-2	8-8					
A521	4	1	8-6	1	3-8	1-2	3-8					
A522	16	1	8-5 19-8	1	3-7 1/2 9-3	1-2	3-7 1/2 9-3					Increment 4 1/2"
A523	32	1	7-2	1	3-0	1-2	3-0					
A524	4	1	20-10	2	17-0	2-10				2-0	2-0	
A525	12	1	19-4	1	0-9	19-7	-					
A526	2	1	20-6	1	9-8	1-2	9-8					
A527	16	1	7-9 21-6	1	3-3 1/2 10-2	1-2	3-3 1/2 10-2					Increment 5 1/2"
A528	4	1	25-3	2	0-9	24-6				8"	5"	
A529	17	1	12-3 25-7	1	5-2 11-10	1-2	5-11 12-9					Increment 5"
A530	17	1	11-11 22-7	1	5-0 10-4	1-2	5-9 11-1					Increment 4"
A531	25	1	6-6	4	0-9	1-3	3-1	1-5				
A532	9	1	5-1 6-5	4	0-9	1-3	1-8 3-0	1-5				Increment 2"
A533	15	*5	5-3 6-5	4	0-9	1-3	1-10 3-0	1-5				Increment 1"
A601	89	*6	5-0	1	2-6	2-6	-					
A602	52	*6	8-9	1	2-3	6-6	-					
A1001	6	*10	6-11	1	1-6	5-5	-					
A1002	4	1	29-6	2	25-9	3-9				2-8	2-8	
A1003	4	1	18-4	2	15-4	3-0				2-1	2-1	
A1004	2	1	22-4	2	19-0	3-4				1-4	3-1	
A1005	2	1	23-1	2	20-0	3-1				1-5	2-10	
A1006	2	1	28-0	2	22-9	5-3				2-1	4-9	
A1007	2	1	26-0	2	21-0	5-0				1-7	4-9	
A1008	24	*10	14-4	1	1-6	12-10	-					

NOTE: All above marks are prefixed by 6-8.

STRAIGHT BARS				
MARK	NO	SIZE	LENGTH	REMARKS
A451	12	*4	24'-3	
A551	4	*5	31'-3	
A552	4	↓	24'-9	
A553	2		20'-4	
A554	1		13'-9	
A555	1		9'-3	
A556	2		57'-4	
A557	1		8'-3	
A558	1		39'-1	
A559	1		20'-8	
A560	12		7'-5 19'-6	Increment 2'-5" 2 bars each
A561	14		6'-7 18'-7	Increment 2'-0" 2 bars each
A562	20		24'-1	
A563	4		4'-9	
A564	4		5'-6	
A565	5		11'-0	
A566	3		4'-9 5'-5	Increment 4"
A567	3		6'-2	
A568	4		9'-3	
A569	1		14'-0	
A570	16		8'-0 23'-9	Increment 2'-3" 2 bars each
A571	10		7'-11 20'-3	Increment 3'-1" 2 bars each
A572	2		21'-0	
A573	1		12'-3	
A574	1		16'-0	
A575	3		13'-0 13'-10	Increment 5"
A576	3	*5	3'-7	
A651	56	*6	27'-6	
A652	136		20'-10	
A653	12		21'-8	
A654	60		4'-2 15'-4	Increment 1'-1" 4 bars each
A655	49		6'-6	
A656	28		20'-0	
A657	56		14'-0 25'-3	Increment 5" 2 bars each
A658	10		16'-3	
A659	12		40'-0	
A660	2		31'-9	
A661	2	*6	22'-6	
A1051	10	*10	26'-3	
A1052	10	↓	31'-9	
A1053	4		20'-2	
A1054	6	*10	16'-3	


BENT BARS (All dimensions are out to out)												
MARK	NO	SIZE	LENGTH	TYPE	A	B	C	D	E	F	G	REMARKS
B401	48	#4	6'-8"	1	1'-6"	3	1'-6"					
B402	46	#4	7'-0"	1	3'-2"	0-8"	3'-2"					
B403	10	#4	9'-6"	1	4'-5"	0-8"	4'-5"					
B404	4	#4	6'-3"	1	2'-10"	0-7"	2'-10"					
B501	10	#5	4'-0"	1	2'-0"	2'-0"	-					
B502	17	#4	4'-11"	6	2'-0"	0-11"	2'-0"	1'-10"	0-9"			
B503	4	#4	8'-6"	2	6'-9"	1-9"				1'-6"	11"	
B504	10	#4	7'-4"	5	5'-10"	0-9"	0-9"	7'	5'	7'	5'	
B505	2	#4	5'-0"	1	2'-0"	3'-0"	-					
B506	2	#4	5'-0"	2	3'-0"	2'-0"	-			1'-10"	9"	
B507	5	#4	15'-1"	1	5'-10"	3'-5"	5'-10"					
B508	15	#4	17'-1 1/2" 19'-9"	1	6'-10" 8'-2"	3'-5"	6'-10" 8'-2"					Increment 4" 5 bars each
B509	7	#4	20'-11"	1	8'-9"	5'-5"	8'-9"					
B510	27	#4	7'-1"	1	1'-10"	3'-5"	1'-10"					
B511	44	#4	6'-2"	1	2'-0"	2'-2"	2'-0"					
B512	6	#4	7'-0"	1	2'-0"	3'-0"	2'-0"					
B513	16	#4	9'-5" 11'-3 1/2"	4	2'-3"	1'-7" 2'-6"	3'-0"	2'-7" 3'-2 1/2"				Increment 3"
B514	13	#4	11'-8" 11'-8"	4	2'-3"	1'-7" 2'-8"	3'-0"	2'-7" 3'-3 1/2"				Increment 3"
B515	15	#4	11'-2" 11'-2"	4	2'-3"	1'-7" 2'-5 1/2"	3'-0"	2'-7" 3'-5 1/2"				Increment 3"
B516	1	#4	20'-9"	2	0'-9"	20'-0"	-			8'	2'	
B517	1	#4	36'-9"	2	0'-9"	36'-0"	-			8'	2'	
B520	1	#4	22'-8"	1	10'-9"	1'-2"	10'-9"					
B521	2	#4	7'-8"	1	3'-3"	1'-2"	3'-3"					
B522	20	#4	9'-5" 23'-3"	1	4'-1 1/4" 11'-3"	1'-2"	4'-1 1/4" 11'-3"					Increment 4 1/4"
B523	40	#4	7'-2"	1	3'-0"	1'-2"	3'-0"					
B524	4	#4	22'-6"	2	20'-6"	2'-0"	-			1'-6"	1'-6"	
B525	8	#4	23'-3"	1	0'-9"	22'-6"	-					
B526	1	#4	20'-8"	1	9'-9"	1'-2"	9'-9"					
B527	20	#4	8'-10" 21'-6"	1	3'-10" 10'-2"	1'-2"	3'-10" 10'-2"					Increment 4"
B528	4	#4	27'-1"	2	26'-4"	0'-9"	-			8"	2"	
B529	19	#4	13'-11" 28'-11"	1	6'-0" 13'-6"	1'-2"	6'-9" 14'-3"					Increment 5"
B530	19	#4	9'-11" 20'-5"	1	4'-0" 9'-3"	1'-2"	4'-9" 10'-0"					Increment 3"
B531	29	#4	6'-6"	4	0'-9"	1'-3"	3'-1"	1'-5"				
B532	9	#4	5'-7" 6'-5"	4	0'-9"	1'-3"	1'-8" 3'-0"	1'-5"				Increment 2"
B533	15	#5	5'-3" 6'-5"	4	0'-9"	1'-3"	1'-10" 3'-0"	1'-5"				Increment 1"
B601	60	#6	4'-4"	1	2'-3"	2'-3"	-					
B602	50	#6	7'-9"	1	2'-3"	5'-6"	-					
B1001	6	#10	15'-3"	1	1'-6"	13'-9"						
B1002	4	#4	26'-4"	2	22'-7"	3'-9"				2'-8"	2'-8"	
B1003	4	#4	18'-9"	2	15'-6"	3'-3"				2'-3"	2'-3"	
B1004	18	#10	14'-1"	1	1'-6"	12'-7"						
B1101	2	#11	25'-5"	2	21'-8"	3'-9"				1'-3"	3'-6"	
B1102	2	#11	25'-2"	2	21'-5"	3'-9"				1'-2"	3'-7"	
B1103	2	#11	28'-10"	2	23'-9"	5'-1"				2'-0"	4'-8"	
B1104	2	#11	28'-9"	2	23'-3"	5'-6"				1'-8"	5'-6"	

NOTE: All above marks are prefixed by 6-8

MARK		STRAIGHT BARS		REMARKS
NO.	SIZE	LENGTH		
B451	12	*4	26-2	
B531	4	*5	30-0	
B552	4	†	23-5	
B553	2		19-6	
B554	2		37-3	
B555	4		9-0	
B556	1		36-0	
B557	1		9-6	
B558	1		20-0	
B559	1		10-0	
B560	12		26 ³ / ₄ 26-0	Increment 2'-9 2 bars each
B561	10		26 ⁵ / ₈ 26-0	Increment 3'-3 2 bars each
B562	20		26-6	
B563	7		4-8	
B564	4		5-3	
B565	2		11-0	
B566	3		5 ¹ / ₈ 6-7	Increment 5'
B567	3		6-2	
B568	3		9-2	
B569	2		14-2	
B570	16		24 ⁷ / ₈ 24-8	Increment 2'-5 2 bars each
B571	10		26 ⁵ / ₈ 26-8	Increment 3'-5 2 bars each
B572	1		24-0	
B573	1		12-3	
B574	1		19-3	
B575	3		19-2 10-9	Increment 3 1/2
B576	8		25-0	
B577	1		21-6	
B578	1	*5	15-6	
B651	64	*6	26-3	
B652	92	†	23-10	
B653	8		24-8	
B654	40		33 ³ / ₄ 22-0	Increment 2'-1 4 bars each
B655	47		5-6	
B656	32		19-3	
B657	64		13 ⁵ / ₈ 23-10	Increment 4" 2 bars each
B658	10		14-7	
B659	12		39-1	
B660	2		30-4	
B661	2	*6	21-5	
B1051	10	*10	25-3	
B1052	10	†	30-2	
B1053	4	†	20-9	
B1054	6	*10	14-7	


NOTES:

1. For key plan see Sheet No. 19
2. For slope protection and drainage details see Sheet No. 25
3. Cast-in-place concrete piles shall be driven to develop minimum 35 tons actual bearing capacity.

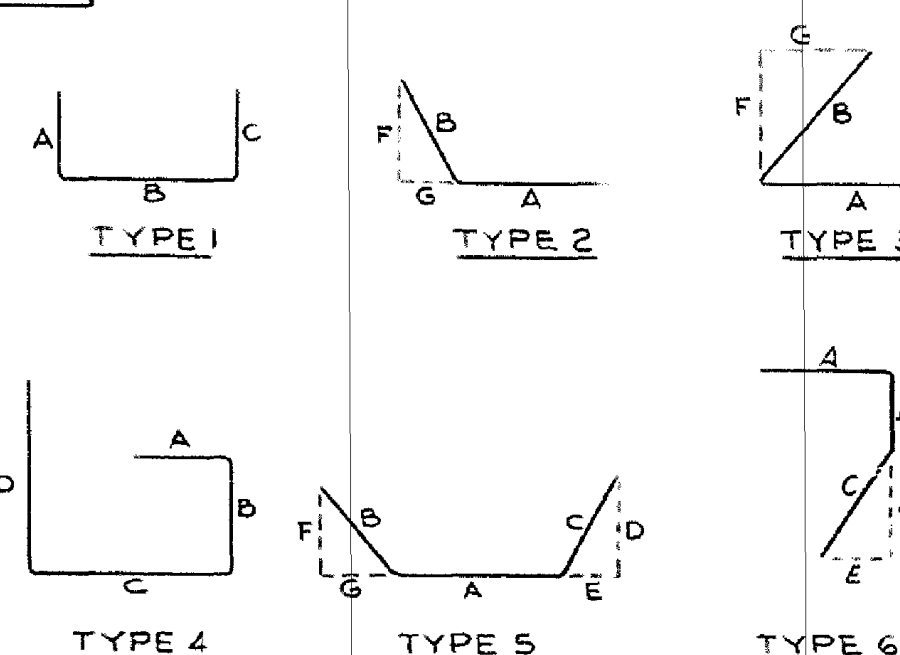

APPROVED _____
BRIDGE ENGINEER

DELAWARE STATE HIGHWAY DEPARTMENT		
INTERSTATE ROUTE F.A.I.-1 CHRISTINA RIVER INTERCHANGE		
CONNECTION "F" - BRIDGE NO. 6-8 ABUTMENTS - SECTIONS & SCHEDULES		
J.E. GREINER CO. MORAN, PROCTOR, MUESER & RUTLEDGE CONSULTING ENGINEERS		
DESIGNED: M.A.S. DRAWN: P.F.	CHECKED: A.H. IN CHARGE	DATE: 7/21/57. SCALE: 1"=8'

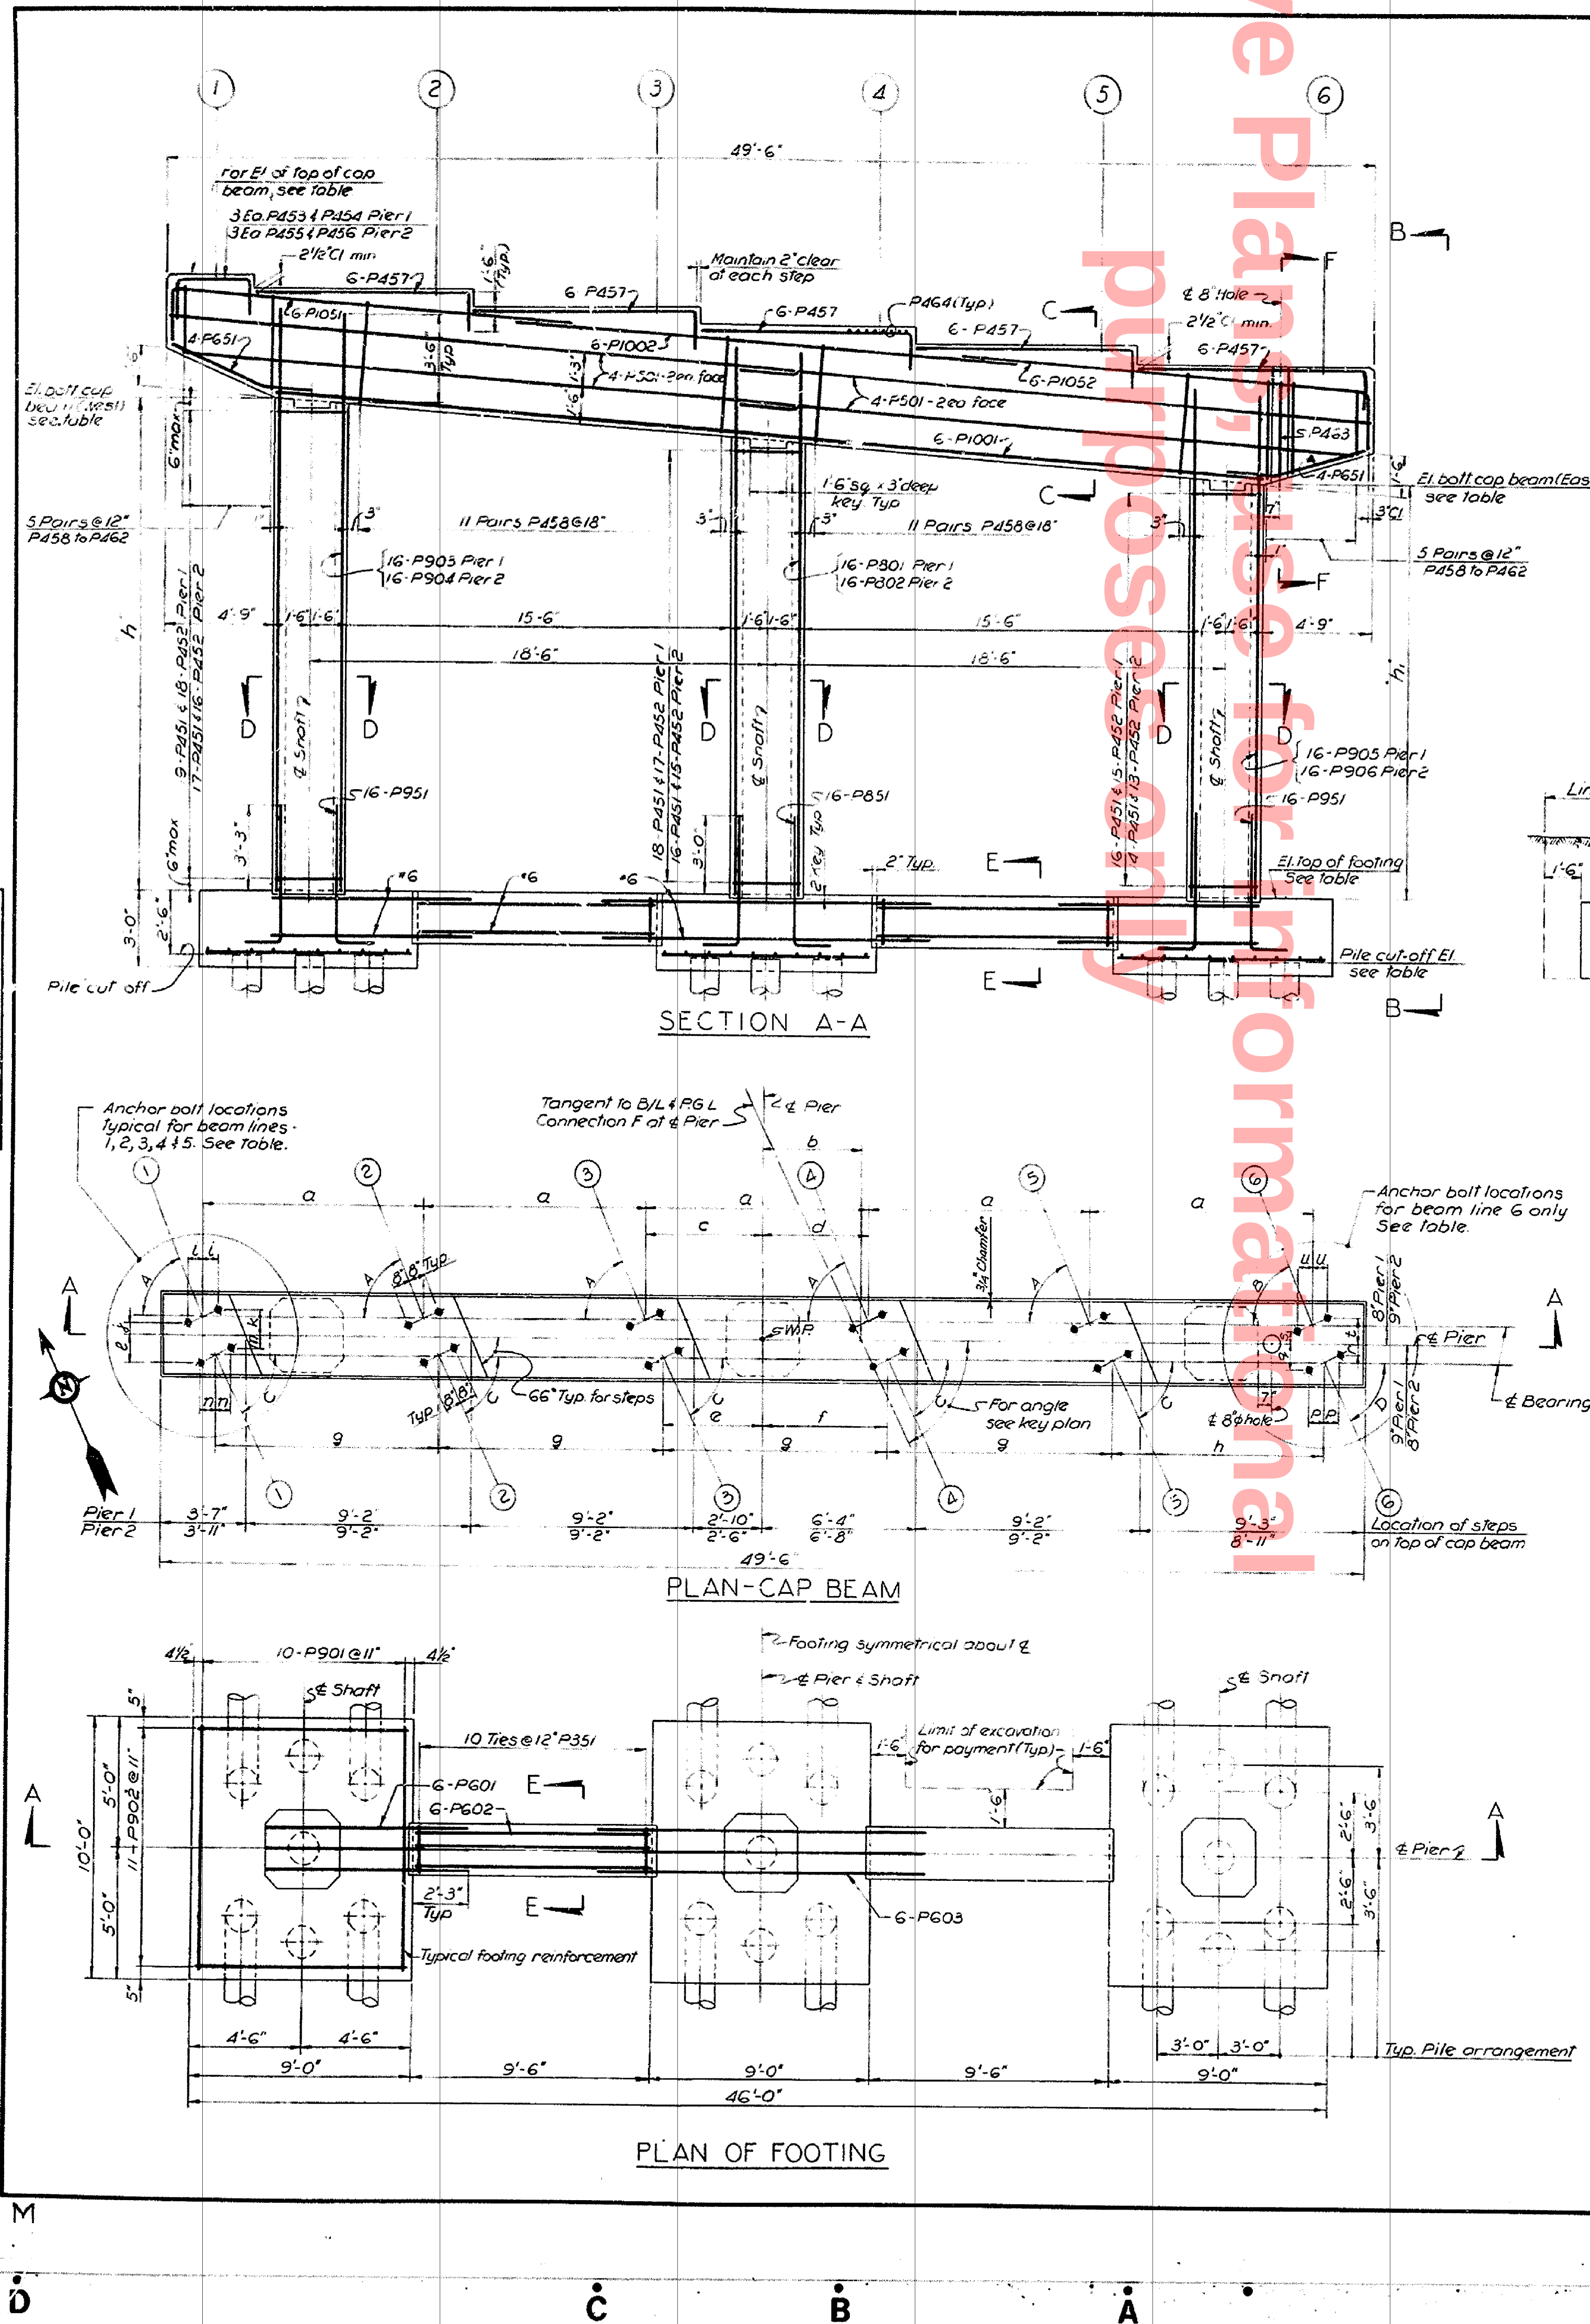

ANGLE & DIMENSION VALUES FOR PLAN OF CAP BEAM

	Pier 1	Pier 2
Angle A	65°54'45"	67°49'43"
Angle B	65°12'54"	67°11'37"
Angle C	63°53'06"	65°54'45"
Angle D	63°07'13"	65°12'54"
Dimension a	9'-1 1/4"	8'-10 3/8"
Dimension b	3'-9 7/8"	3'-9 1/8"
Dimension c	4'-10 7/8"	4'-9 3/8"
Dimension d	4'-2 3/8"	4'-1 3/4"
Dimension e	4'-0 1/8"	3'-9 3/8"
Dimension f	5'-2 3/8"	5'-3 3/8"
Dimension g	9'-2 3/8"	9'-1 1/4"
Dimension h	8'-8 1/8"	8'-11 1/8"


ANCHOR BOLT LOCATIONS

	Pier 1	Pier 2
i	7 1/8"	7 1/8"
j	4 3/4"	6"
k	11 1/4"	1'-0"
l	1'-0 1/2"	11 1/4"
m	5 1/2"	4 3/8"
n	7 3/8"	7 3/8"
p	7 1/8"	7 1/4"
q	1'-0 3/8"	11 3/8"
r	5 3/8"	4 3/8"
s	4 3/8"	5 7/8"
t	11 3/8"	1'-0 1/8"
u	7 1/4"	7 3/8"

TABULATION OF ELEVATIONS & HEIGHTS OF PIERS

	Pier 1	Pier 2
El. ①	31.659	31.755
El. ②	31.041	31.126
El. ③	30.417	30.496
El. ④	29.793	29.867
El. ⑤	29.168	29.237
El. ⑥	28.536	28.673
El. bolt of cap beam (West)	26.672	26.779
El. bolt of cap beam (East)	23.837	23.996
El. top of footing	7.612	9.179
Pile cut-off El.	5.172	7.279
Dimension "h"	19'-0"	7'-0"
Dimension "h"	16'-2"	14'-2 5/8"

NOTE: Elevations ① thru ⑥ are finished top of pier elevations.

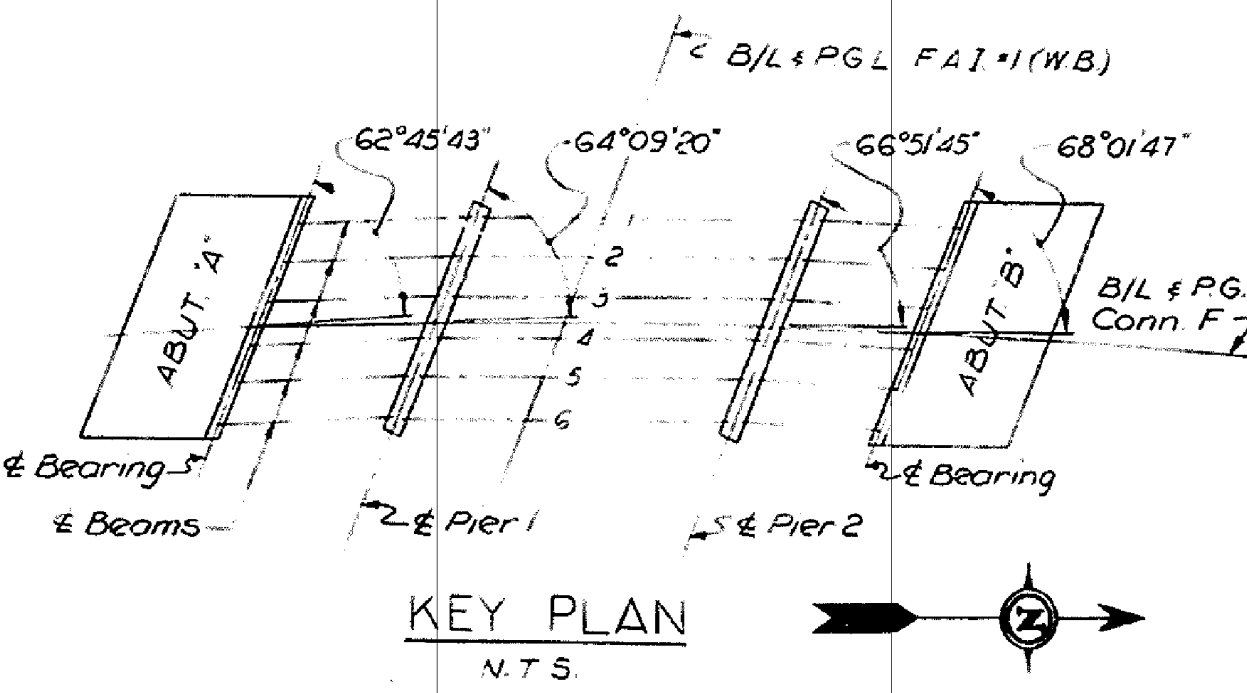

COUNTY	CONTRACT	P.R. NO.	STATE	PERCENTAGE	PROJECT NO.	PIER NO.	PIER NO.	PIER NO.
NEW CASTLE	6401063211	2	DEL.	1-95-1(13)		19	26	

REINFORCING SCHEDULE FOR PIERS 1 & 2									
LOCATION	MARK	PIER	NO.	SIZE	LENGTH	MARK	PIER	NO.	SIZE
STRAIGHT BARS	P601	1,2	24	#6	8-3	P351	1,2	40	#3
	P602	1,2	24	#6	9-6				
	P603	1,2	12	#6	13-6	P851	1,2	32	#8
	P901	1,2	60	#9	9-6	P951	1,2	64	#9
	P902	1,2	66	#9	8-6				
BENT BARS									
BENDING DIAGRAMS									

NOTE: All above marks are prefixed by 6-8

NOTES:

- For General Notes see Sheet No. 2
- For Angles given on Key Plan are to the local Tangent on Connection F.
- For Shoe and Anchor Bolt Details see Sheet No. 23
- For Drainage Details see Sheet No. 25
- For Pile Details see Sheet No. 5

DELAWARE
STATE HIGHWAY DEPARTMENT


INTERSTATE ROUTE F.A.I.-1
CHRISTINA RIVER INTERCHANGE
CONNECTION "F" - BRIDGE NO. 6-8
PIERS 1 & 2

J.E. GREINER CO.
MORAN, PROCTOR, MUESER & RUTLEDGE
CONSULTING ENGINEERS

DESIGNED: J.E.G. CHECKED: J.E.G. DATE: 1/31/53
DRAWN: J.E.G. IN CHARGE: J.E.G. SCALE: AS SHOWN


APPROVED: BRIDGE ENGINEER

COUNTY	CONTRACT	F.R.A. REG. NO.	STATE	FED. AID PROJECT NO.	FISCAL YEAR	SHEET NO.	TOTAL SHEETS
NEW CASTLE	6401063211	2	DEL.	I-95-1(13)		20	26

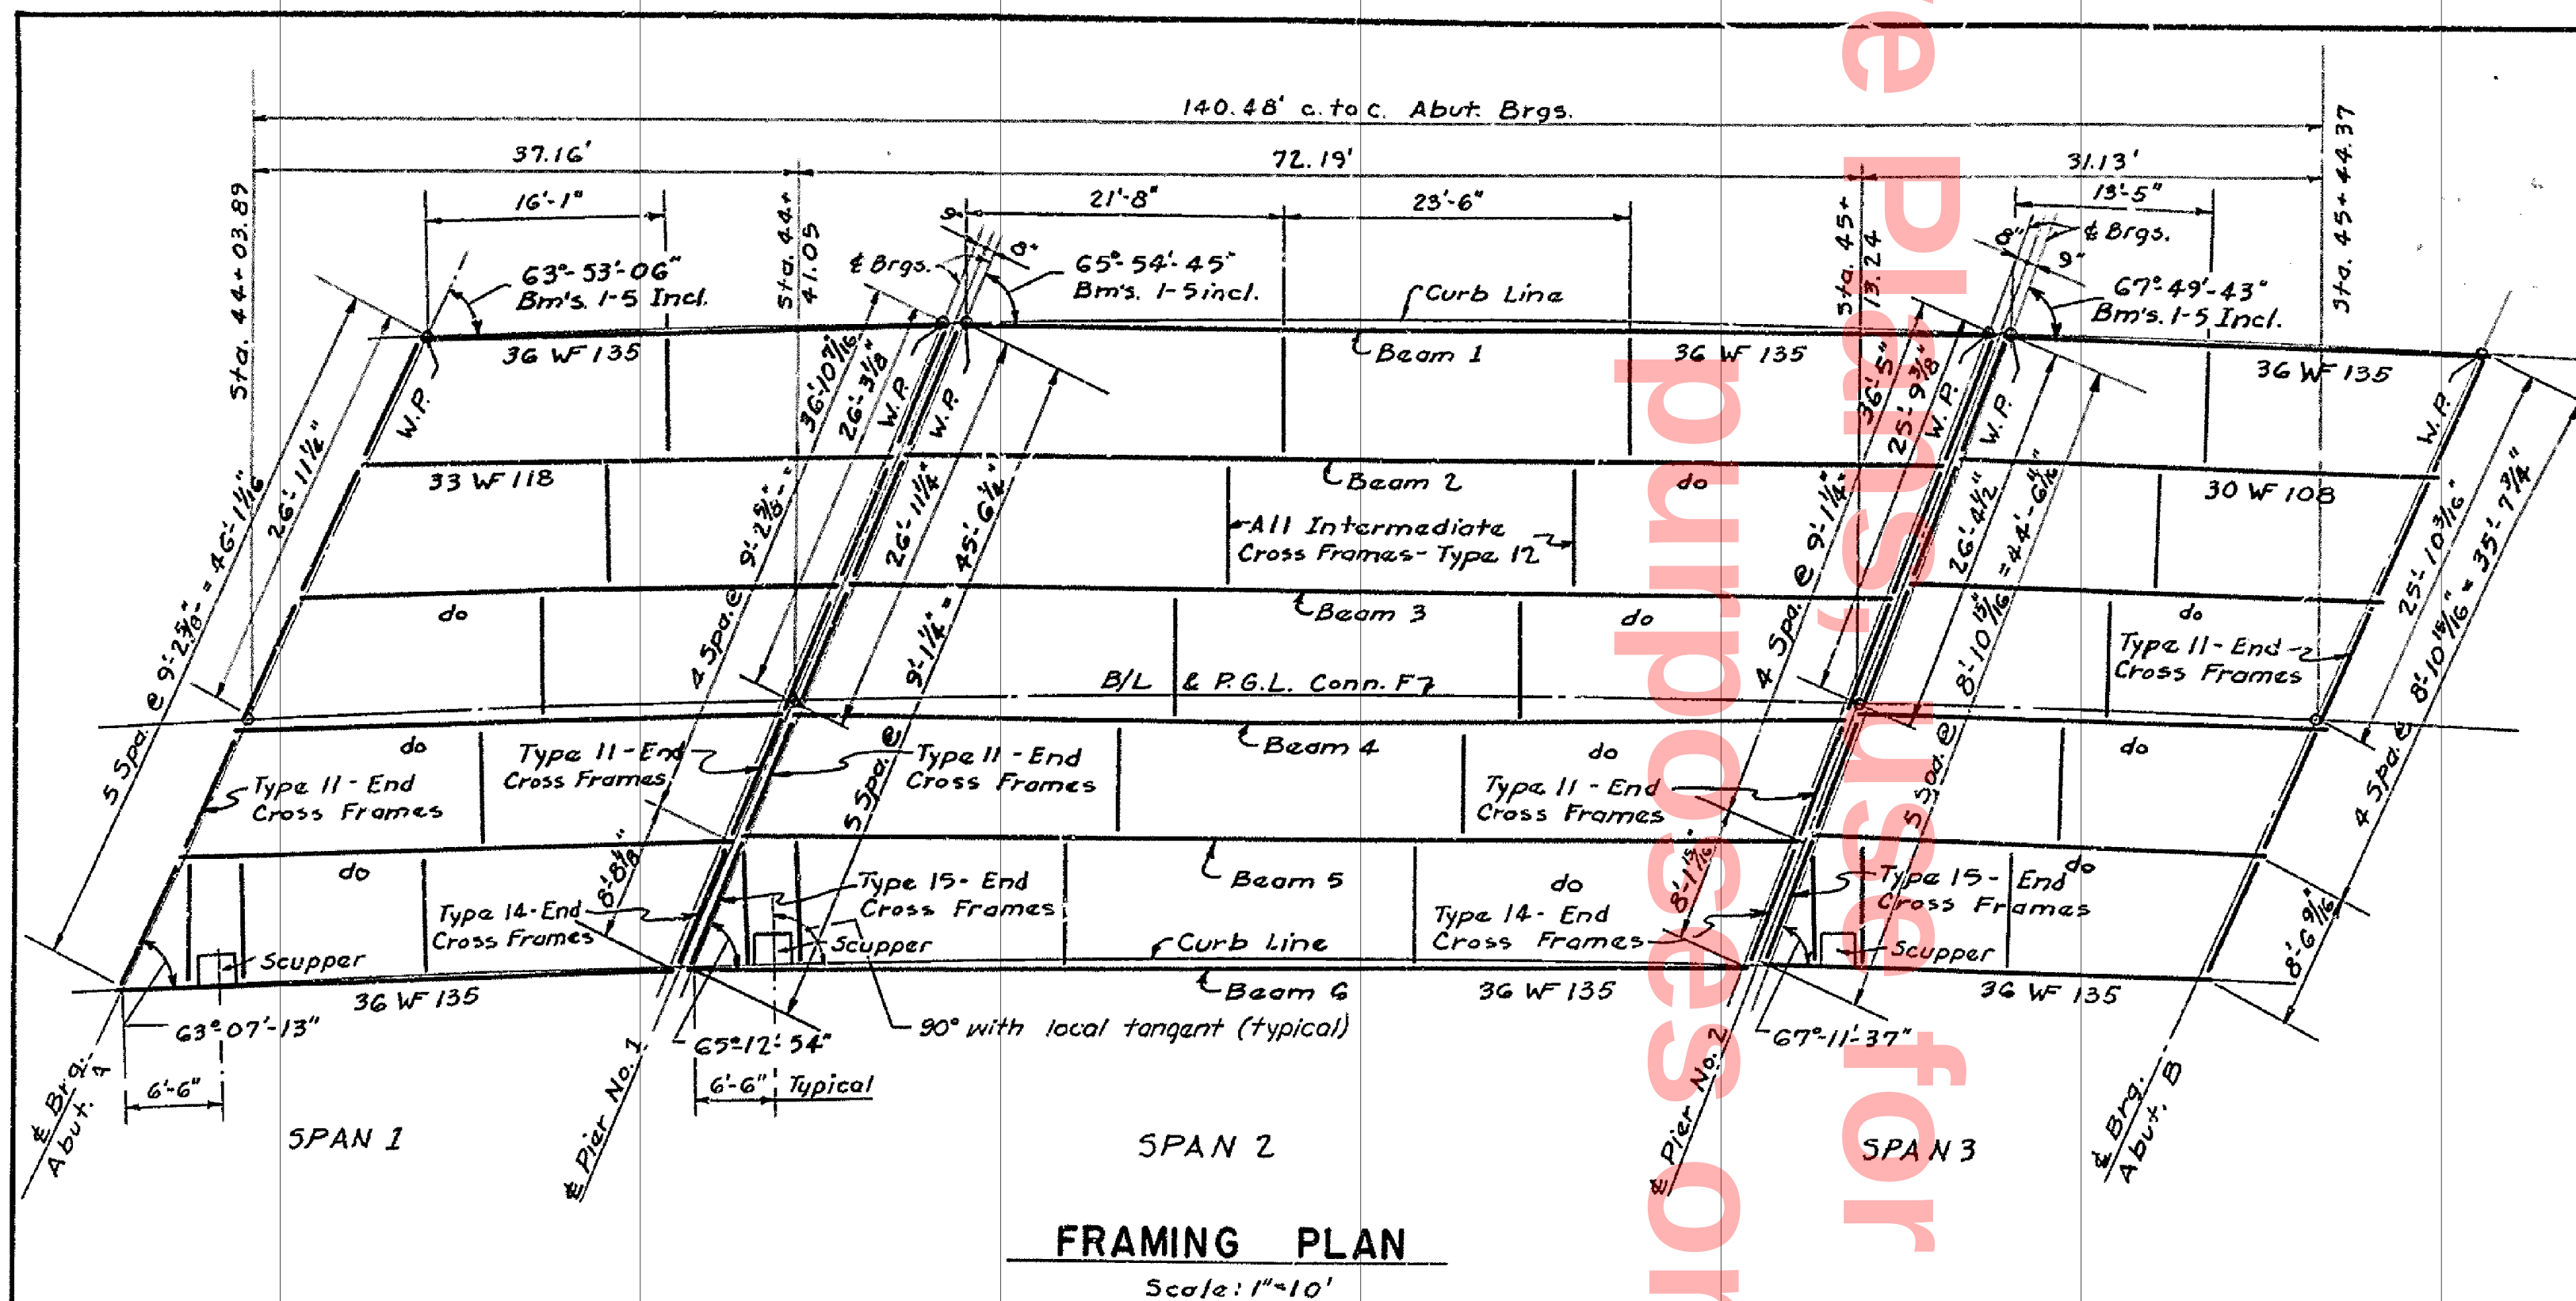


CAMBER INCREMENTS FOR DEAD LOAD
INCHES (VERTICAL CURVE)

	Span 1	Span 2	Span 3
Bms. 1 to 6	Bms. 1 to 6	Bms. 1 & 6	Bms. 2 to 4
	$\frac{1}{4}L_1$	$\frac{1}{4}L_2$	$\frac{1}{4}L_3$
Structural Steel	—	$\frac{1}{4}$	$\frac{5}{16}$
Concrete Deck Slab	$\frac{1}{8}$	$\frac{3}{16}$	$\frac{1}{8}$
Sidewalk and Porapet	$\frac{1}{16}$	$\frac{1}{16}$	$\frac{1}{8}$
2" Wearing Surface	—	$\frac{1}{16}$	$\frac{1}{8}$
Full Dead Load	$\frac{3}{16}$	$\frac{1}{4}$	$\frac{1}{8}$
Vertical Curve	—	$\frac{1}{16}$	$\frac{1}{8}$
Total Camber at $\frac{1}{2}L_n$	Natural Camber	$\frac{2}{3}$	Natural Camber

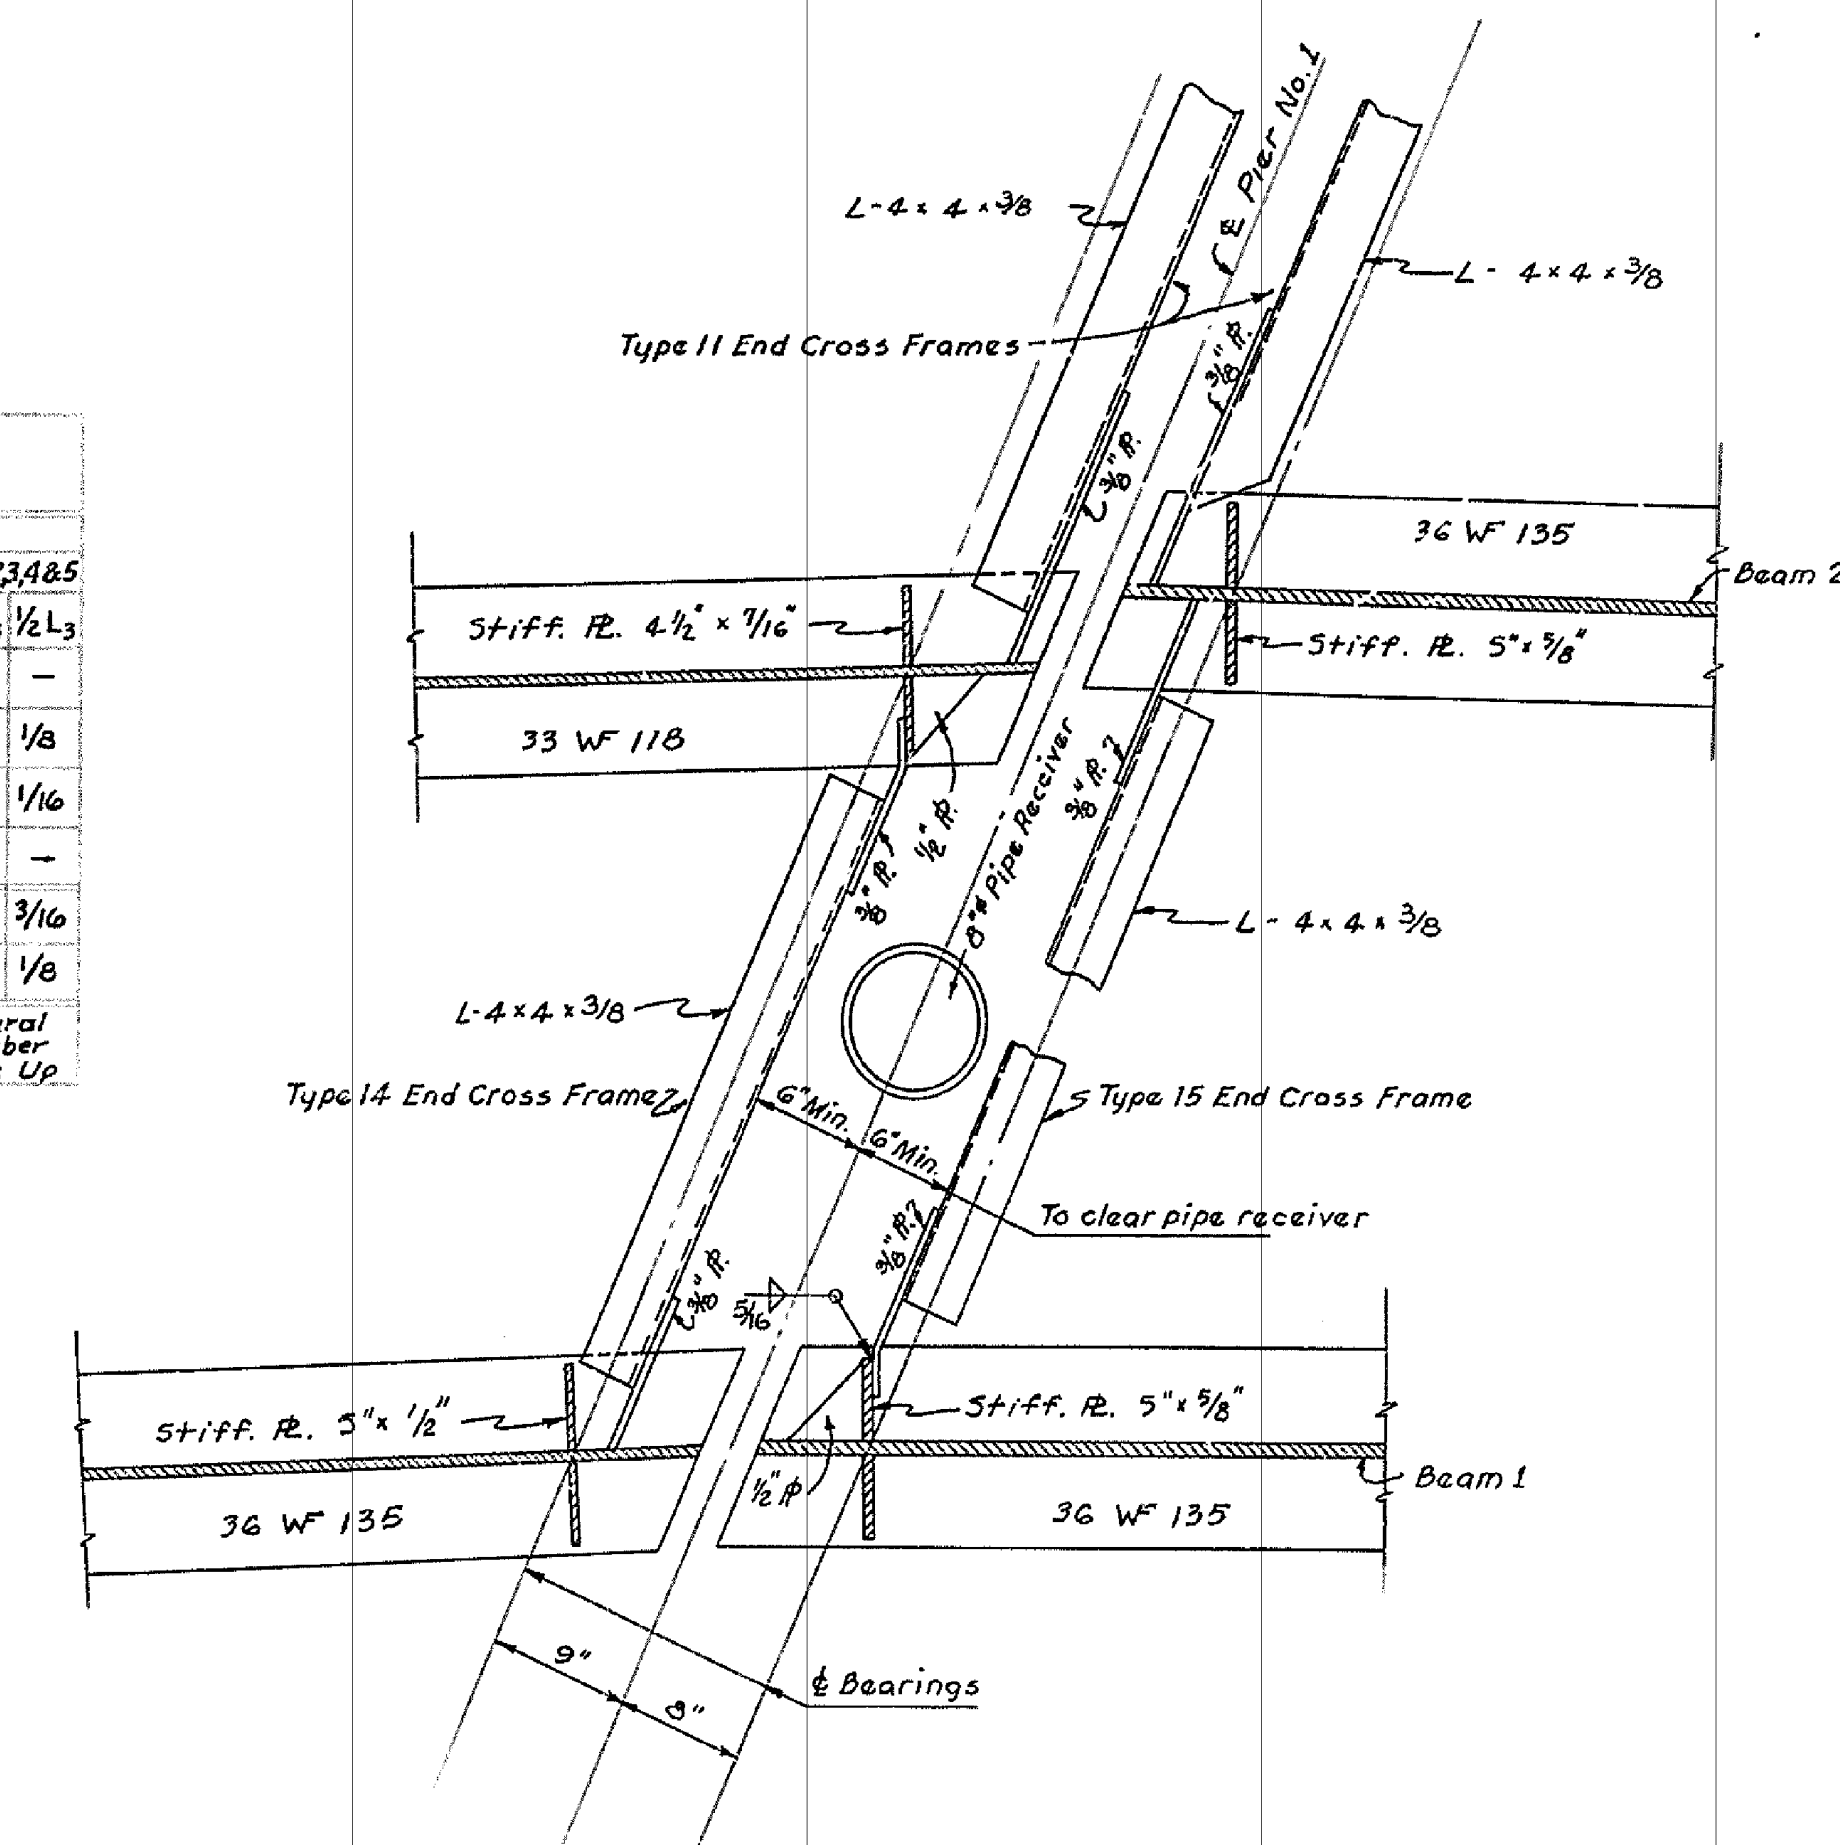


END CROSS FRAME CONNECTION

Scale: $1'' = 1'-0''$

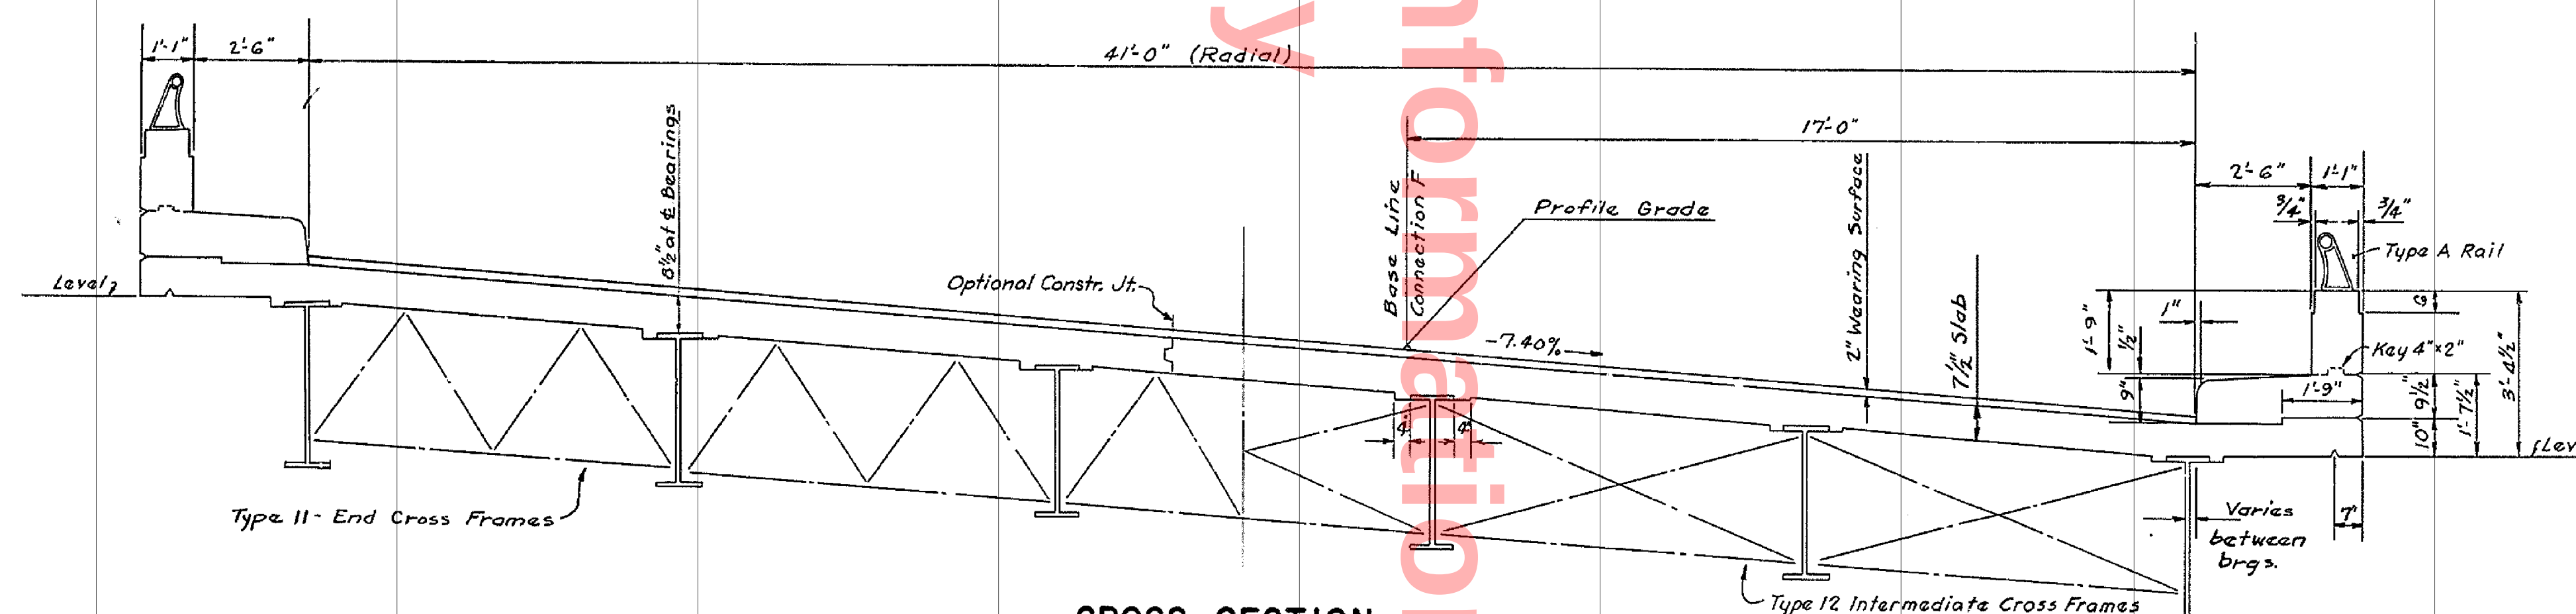


CROSS SECTION
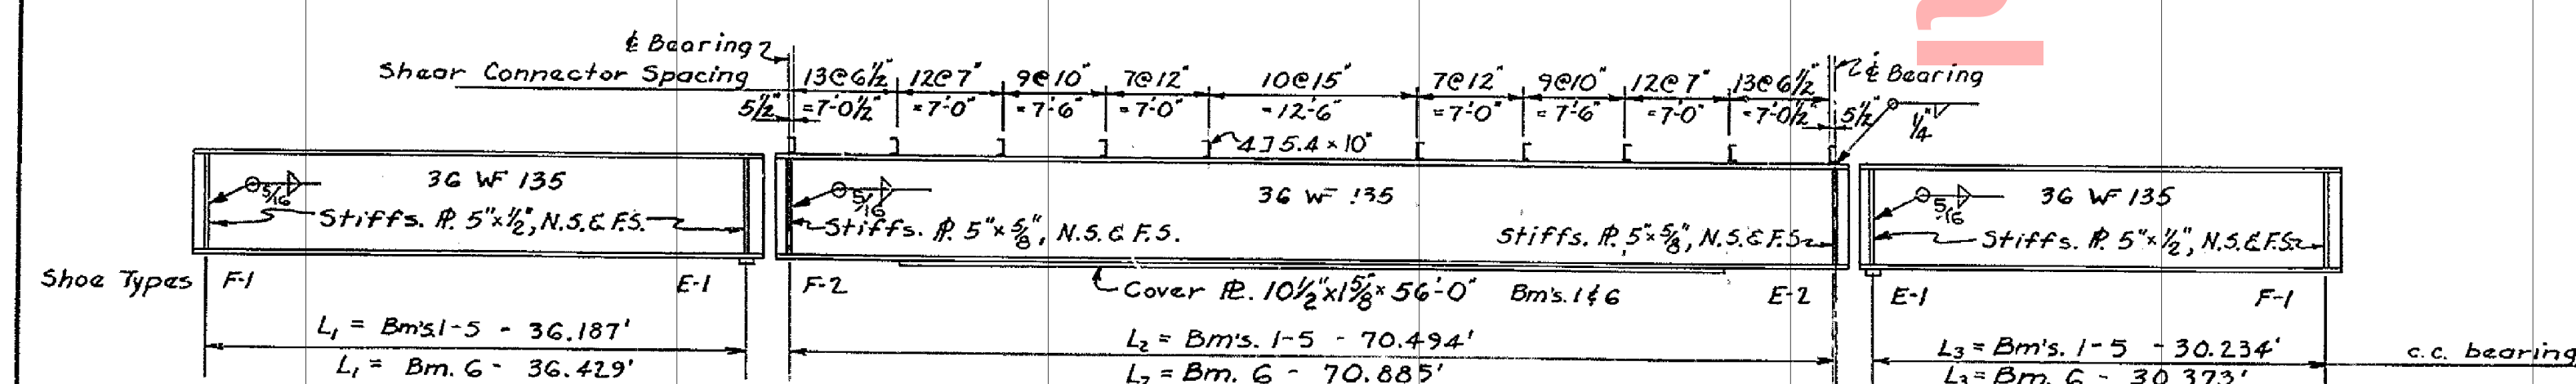
$$5ca/c: \frac{3}{8}'' = 1'-0''$$


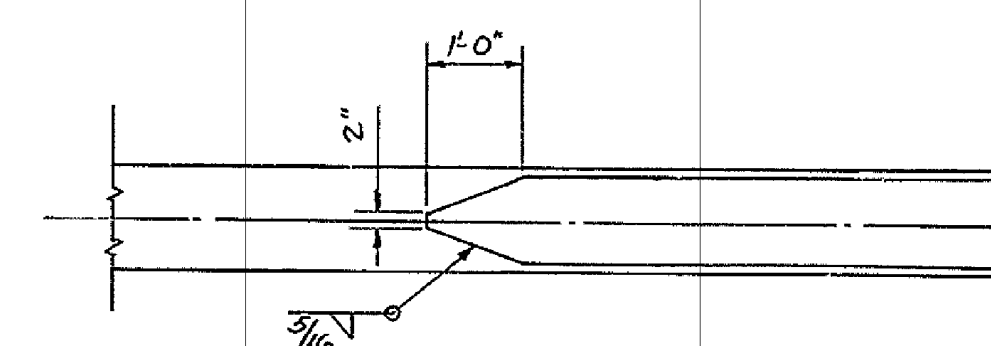
EXTERIOR BEAM

No Scale

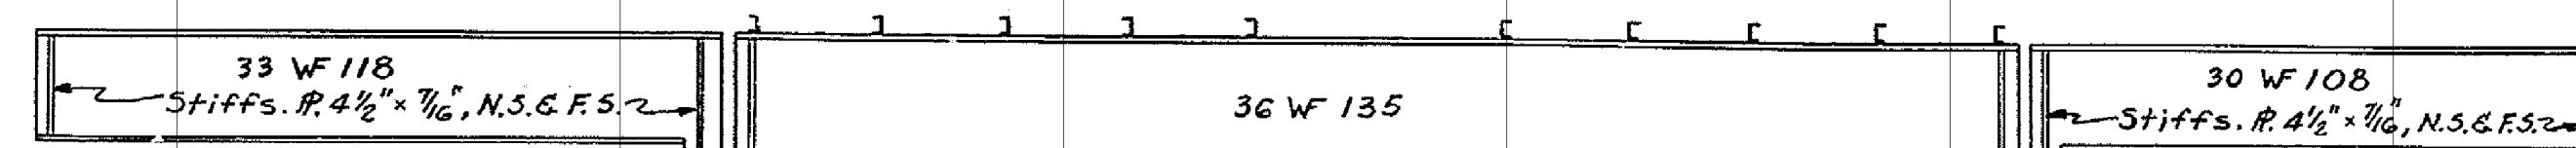

INTERIOR BEAM

No Scale



BOTTOM FLANGE DETAIL

Scale: $\frac{1}{2}" = 1'-0"$

Notes:
For General Notes, see Sheet No. 2
For Cross Frames, dams and bridge
railing, see Superstructure Details
Sheet. No. 22
For Shoes, see Bearing Details
Sheet. No. 23
For Scupper and scupper framing,
see Scupper Details Sheet. No. 24

	DELAWARE	
	STATE HIGHWAY DEPARTMENT	
	INTERSTATE ROUTE F.A.I.-1	
	CHRISTINA RIVER INTERCHANGE	
	CONNECTION F - BRIDGE 6-8	
	SUPERSTRUCTURE - FRAMING	

J.E. GREINER CO.		
MORAN, PROCTOR, MUESER & RUTLEDGE CONSULTING ENGINEERS		
DESIGNED: <u>E.L.L.</u>	CHECKED: <u>F.R.P.</u>	DATE: <u>12-19-63</u>
DRAWN: <u>B.L.M.</u>	IN CHARGE: <u>C.B.M.</u>	SCALE: <u>As Shown</u>

APPROVED _____
BRIDGE ENGINEER




COUNTY	CONTRACT	F.A.D. NO.	STATE	FED. AID PROJECT NO.	FISCAL YEAR	SHEET NO.	TOTAL SHEETS
NEW CASTLE	6401063211	2	DEL.	1-95-1(13)		21	26

REINFORCING SCHEDULE							
Location	Mark	Number Required				Length	Total Weight Lbs.
		Span 1	Span 2	Span 3	Total 3 Spans		
Deck	S604	4	4	4	12	23'-4"	Str.
	S605	4	4	4	12	32'-2"	Str.
	S608	4 Ser. of 25			4 Ser. of 25	Varies 1'-3" to 30'-4"	Str.
	S609	2 Ser. of 13			2 Ser. of 13	Varies 8'-3" to 22'-10"	Str.
	S610	26	26	22	74	24'-10"	Str.
	S611	2 Ser. of 13			2 Ser. of 13	Varies 12'-7" to 26'-11"	Str.
	S612	26	26	22	74	20'-9"	Str.
	S613	23	38	20	81	21'-0"	Str.
	S614	23	38	20	81	28'-6"	Str.
	S615	46	76	40	162	24'-9"	Str.
	S616	39		39	78	26'-2"	10
	S617	20		20	40	25'-5"	10
	S618		19		19	25'-1"	10
	S619	12	12	12	36	7'-3"	Str.
Safety Walk and Parapet	R501	68			68	9'-0"	Str.
	R502		134		134	9'-10"	Str.
	R503			46	46	10'-2"	Str.
	R504	2 Ser. of 5			2 Ser. of 5	Varies 9'-0" to 10'-2"	Str.
	R505	2 Ser. of 5			2 Ser. of 5	Varies 7'-10" to 9'-0"	Str.
	R506	2 Ser. of 5			2 Ser. of 5	Varies 9'-10" to 10'-10"	Str.
	R507	2 Ser. of 5			2 Ser. of 5	Varies 8'-10" to 9'-10"	Str.
	R508		2 Ser. of 5	2 Ser. of 5	4 Ser. of 5	Varies 10'-2" to 11'-2"	Str.
	R509		2 Ser. of 5	2 Ser. of 5	4 Ser. of 5	Varies 9'-2" to 10'-2"	Str.
	R510	78	146	66	290	6'-9"	12
	R511	78	146	66	290	6'-6"	13
	S501	82	164		246	36'-9"	Str.
	S502			82	82	30'-11"	Str.
	S503	10	10	10	30	8'-0"	11
	S507	3	3	3	9	6'-7"	11

Note:
Cut top bars at scupper as may be required
Fit of bars due to cross slope of roadway shall be accomplished in the field.
Where sets are composed of bars of different lengths, except for series bars, splices are to be staggered in adjacent sets

REINFORCING SCHEDULE							
Location	Mark	Number Required				Length	Total Weight Lbs.
		Span 1	Span 2	Span 3	Total 3 Spans		
Safety Walk and Parapet	R501	68			68	9'-0"	Str.
	R502		134		134	9'-10"	Str.
	R503			46	46	10'-2"	Str.
	R504	2 Ser. of 5			2 Ser. of 5	Varies 9'-0" to 10'-2"	Str.
	R505	2 Ser. of 5			2 Ser. of 5	Varies 7'-10" to 9'-0"	Str.
	R506	2 Ser. of 5			2 Ser. of 5	Varies 9'-10" to 10'-10"	Str.
	R507	2 Ser. of 5			2 Ser. of 5	Varies 8'-10" to 9'-10"	Str.
	R508		2 Ser. of 5	2 Ser. of 5	4 Ser. of 5	Varies 10'-2" to 11'-2"	Str.
	R509		2 Ser. of 5	2 Ser. of 5	4 Ser. of 5	Varies 9'-2" to 10'-2"	Str.
	R510	78	146	66	290	6'-9"	12
	R511	78	146	66	290	6'-6"	13
	S501	82	164		246	36'-9"	Str.
	S502			82	82	30'-11"	Str.
	S503	10	10	10	30	8'-0"	11
	S507	3	3	3	9	6'-7"	11

Total Weight = 51,321 Lbs

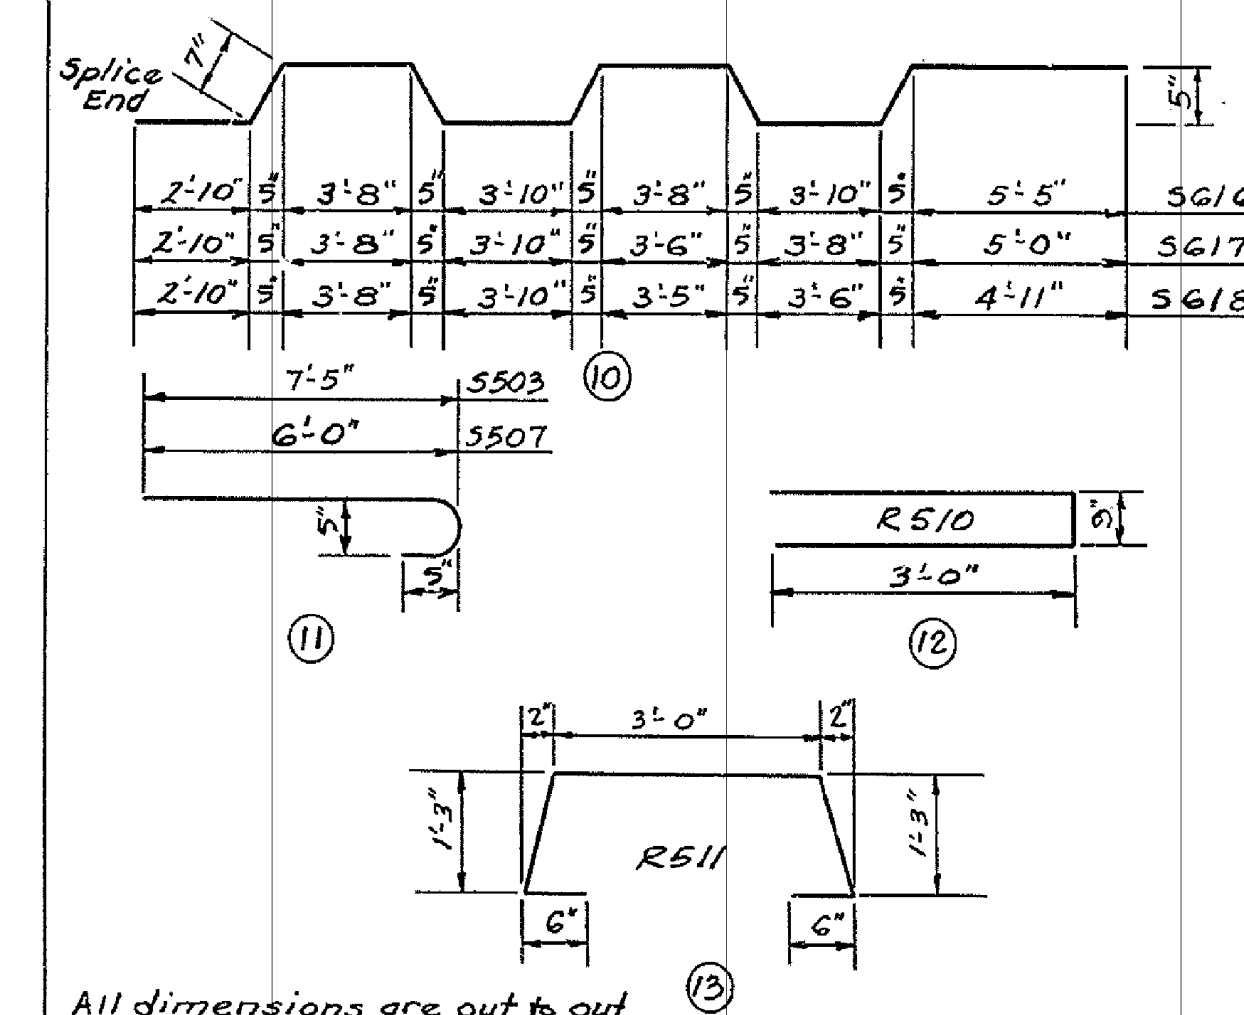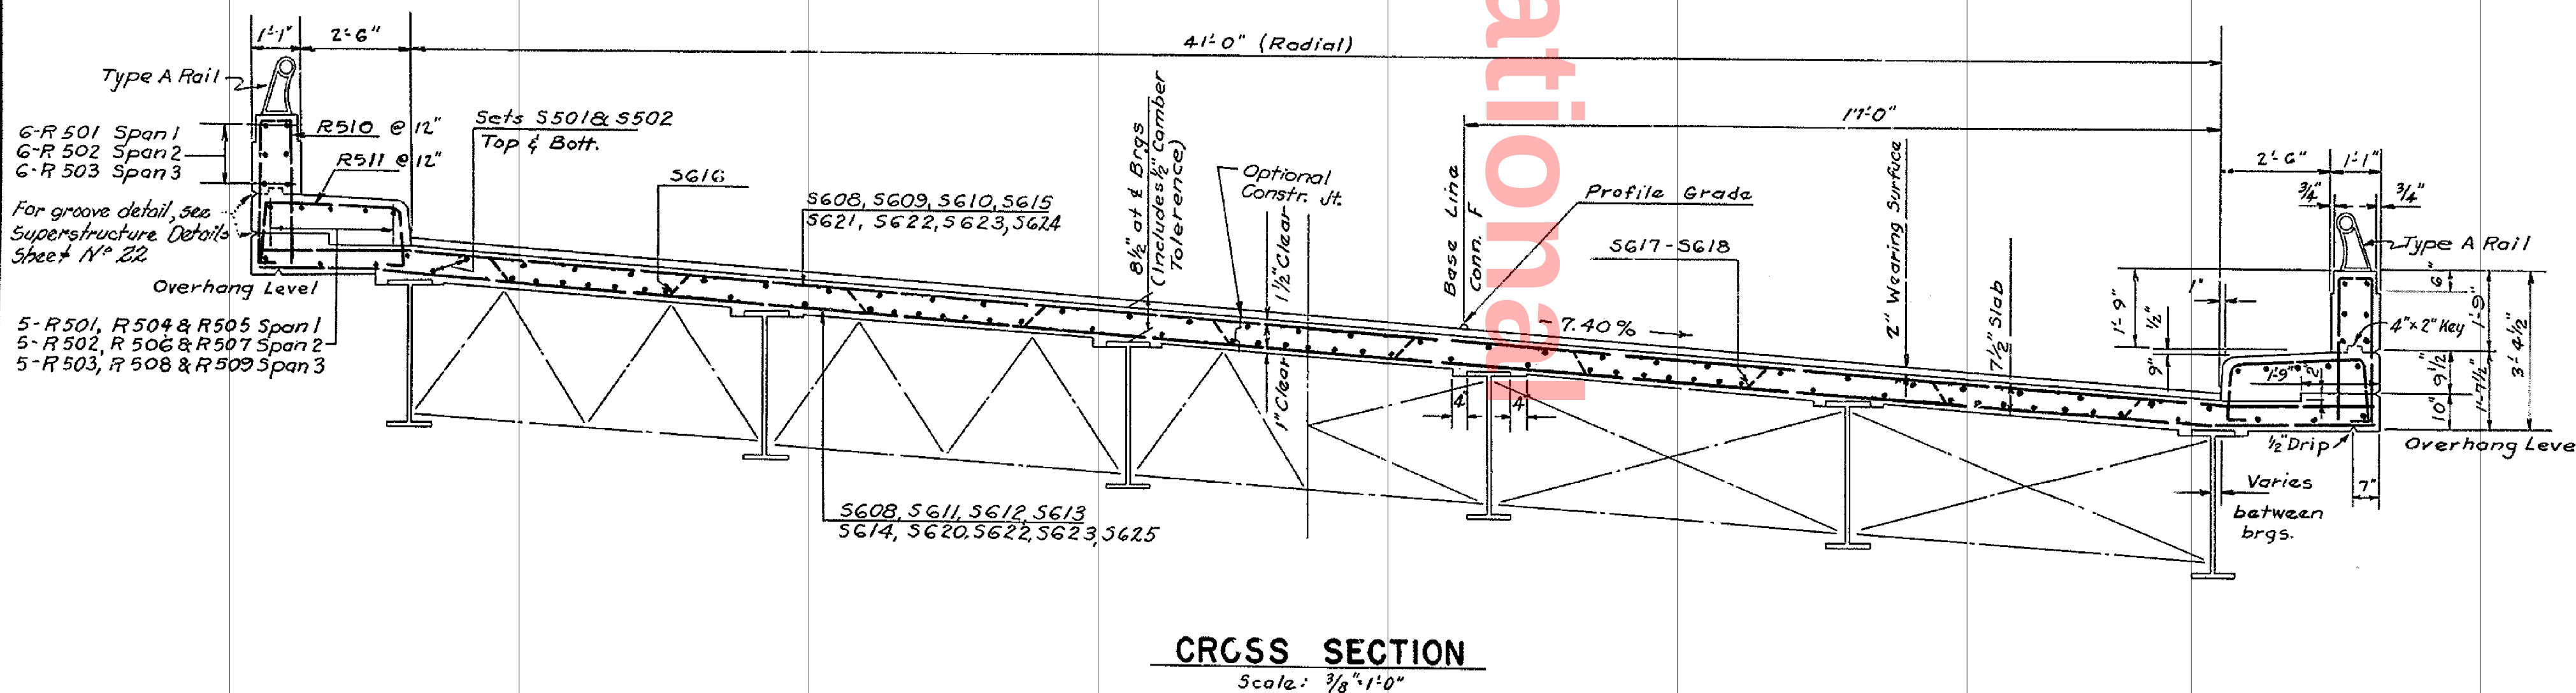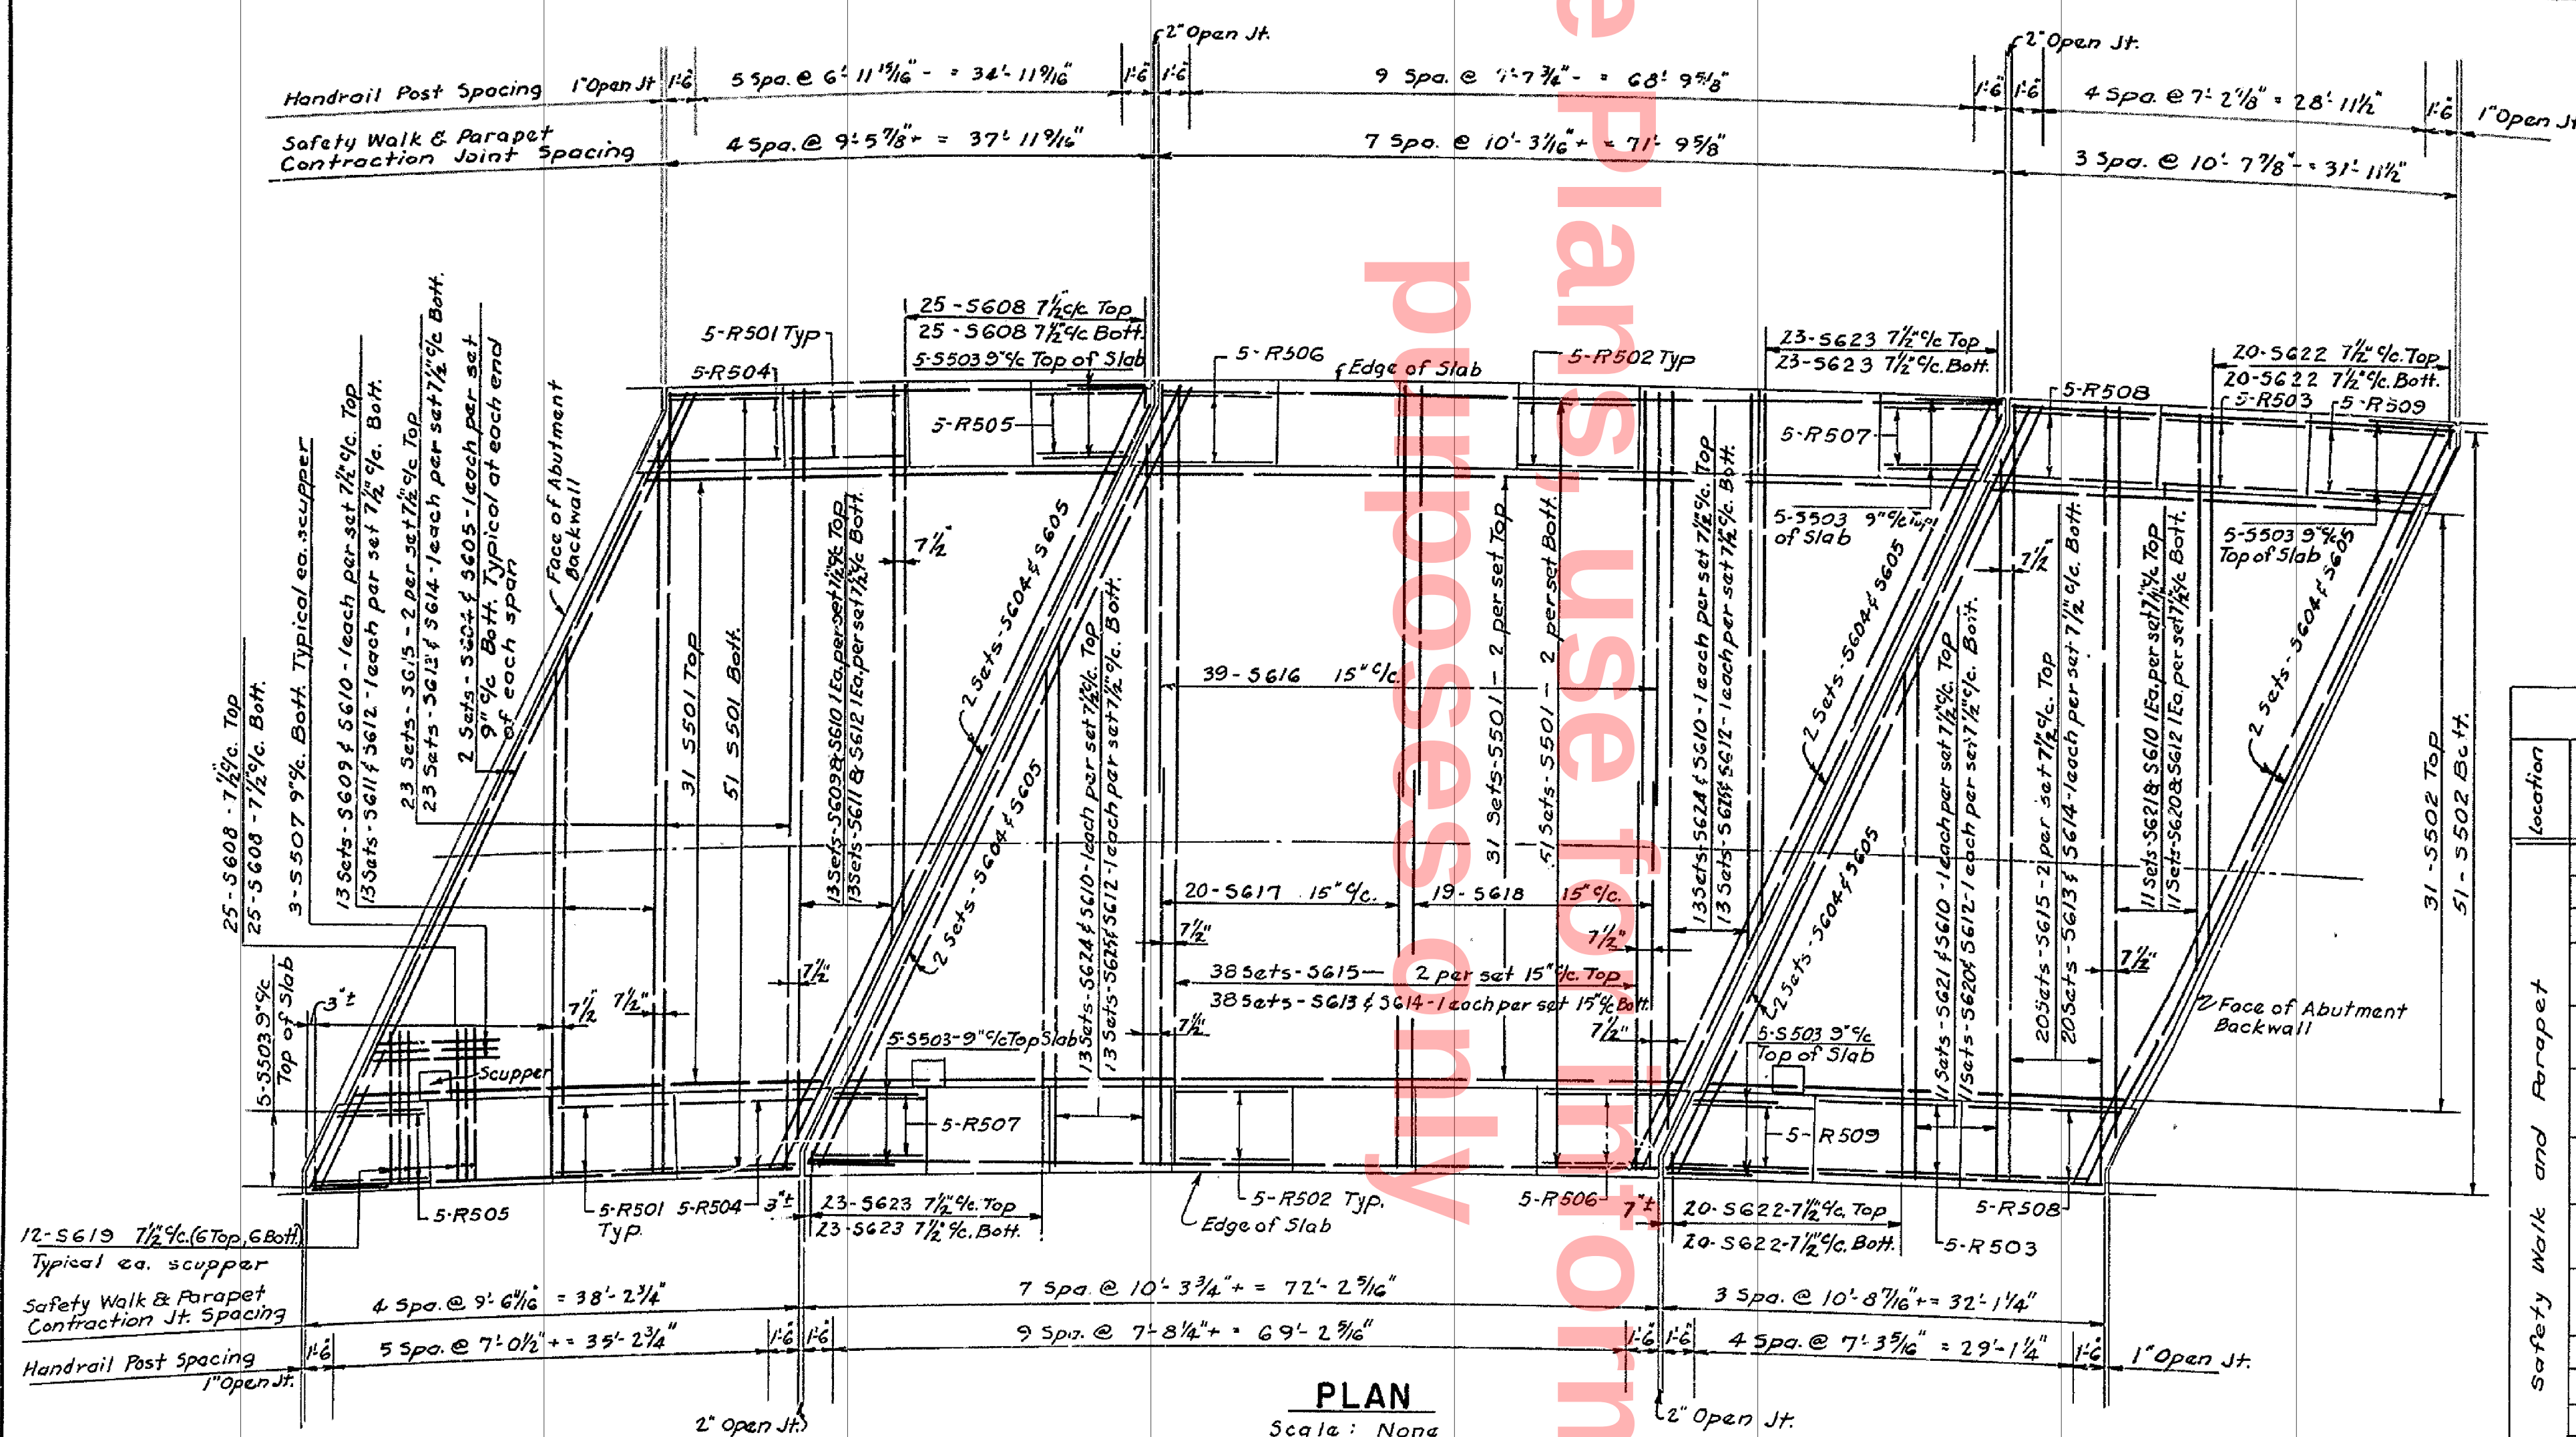


For General Notes, see Sheet No. 2
For railing details, roadway and safety walk details, see Superstructure Details sheet No. 22.
For details of roadway slab construction joints and parapet contraction joints, see Superstructure Details sheet No. 22.


APPROVED _____
BRIDGE ENGINEER

DELAWARE
STATE HIGHWAY DEPARTMENT
INTERSTATE ROUTE F.A.I.-1
CHRISTINA RIVER INTERCHANGE
CONNECTION F- BRIDGE 6-8
SUPERSTRUCTURE-DECK
J.E. GREINER CO.
MORAN, PROCTOR, MUESER & RUTLEDGE
CONSULTING ENGINEERS
DESIGNED: E.L.L. CHECKED: M.H.P. DATE: 12-19-63
DRAWN: R.A.W. IN CHARGE: G.B.M. SCALE: As Shown.


COUNTY	CONTRACT	P.A.D. NO.	STATE	FED. AID PROJECT NO.	FISCAL YEAR	SHEET NO.	TOTAL SHEETS
NEW CASTLE	6A8063211	2	DEL.	1-95-1(13)		22	26

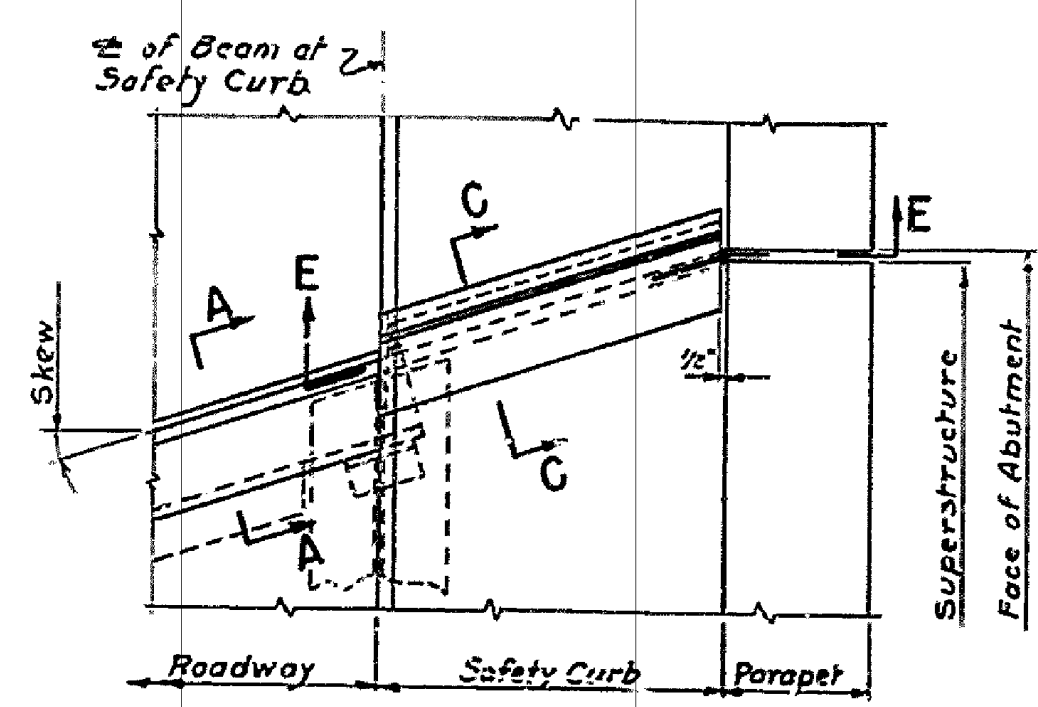



AT ABUTMENTS

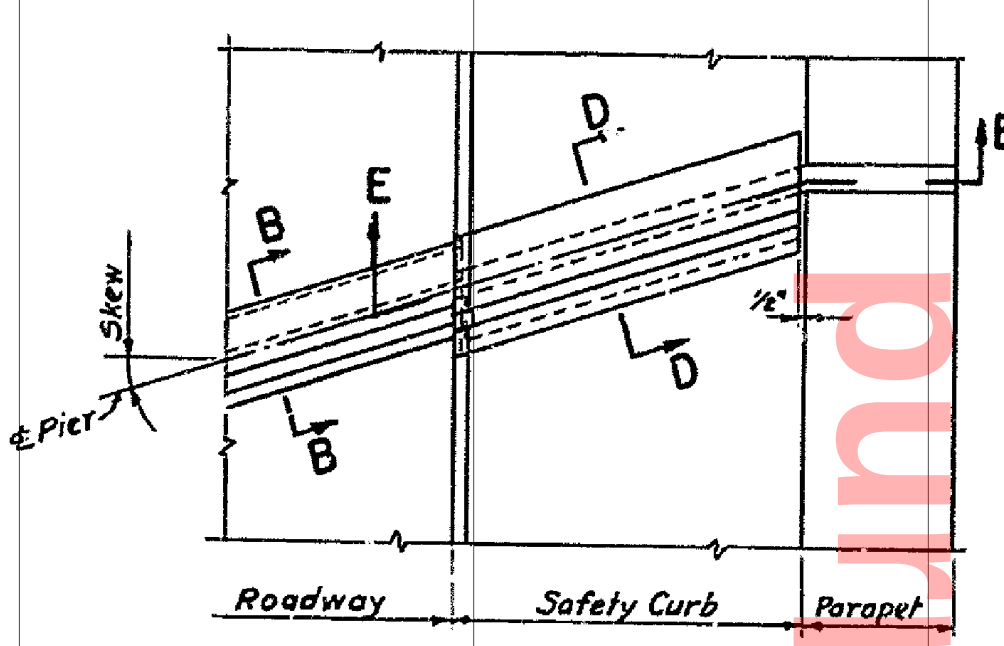


AT PIERS

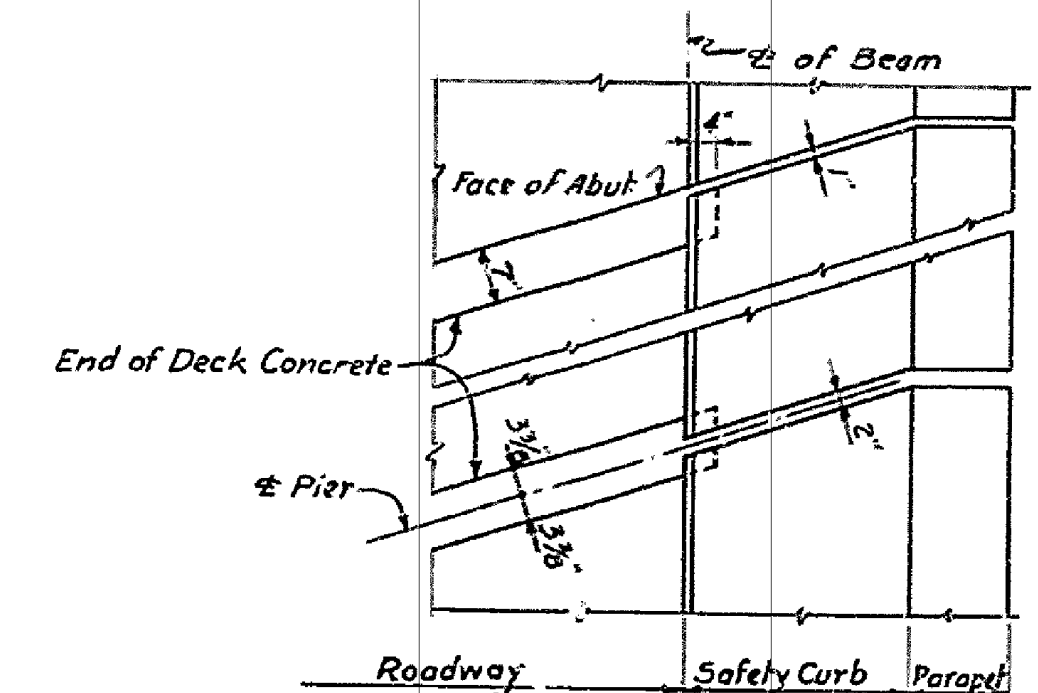


VIEW F-F

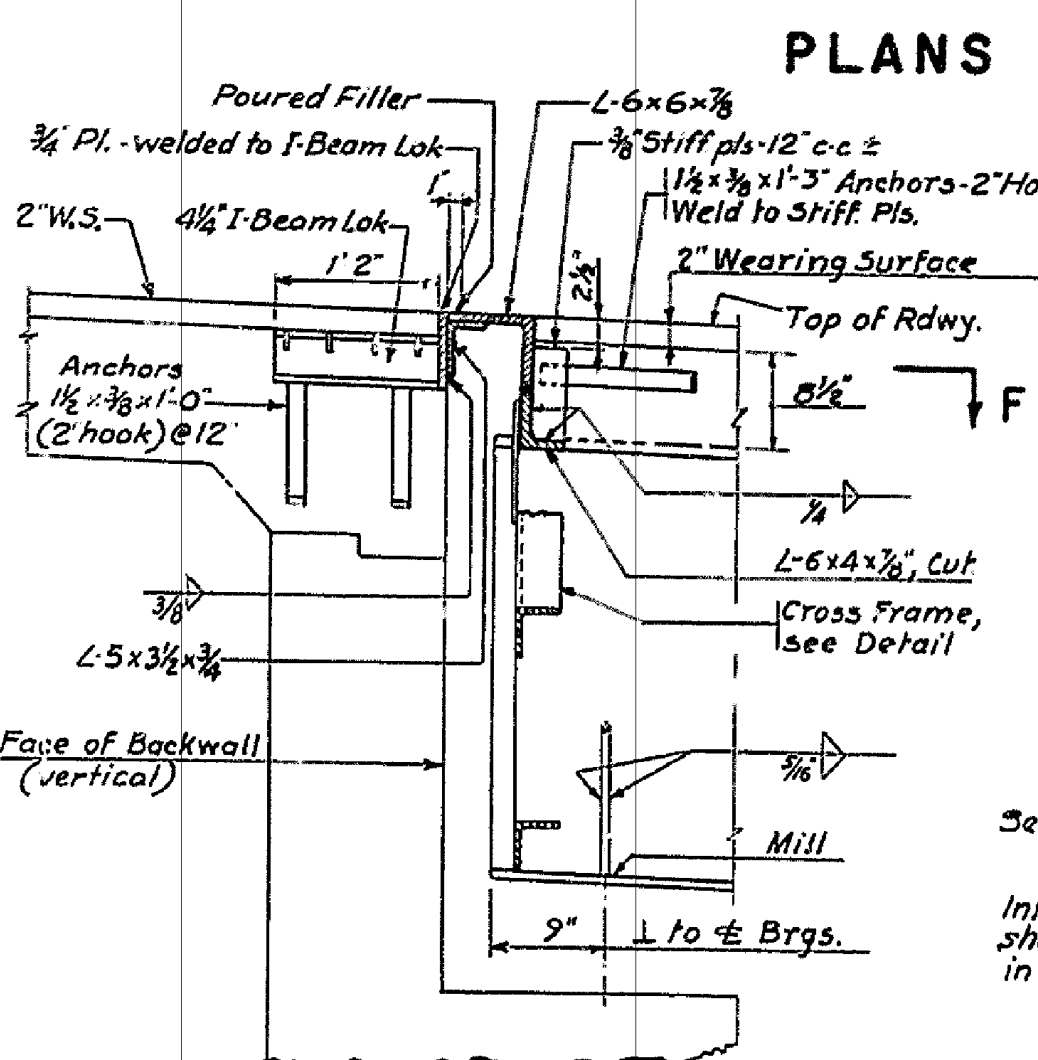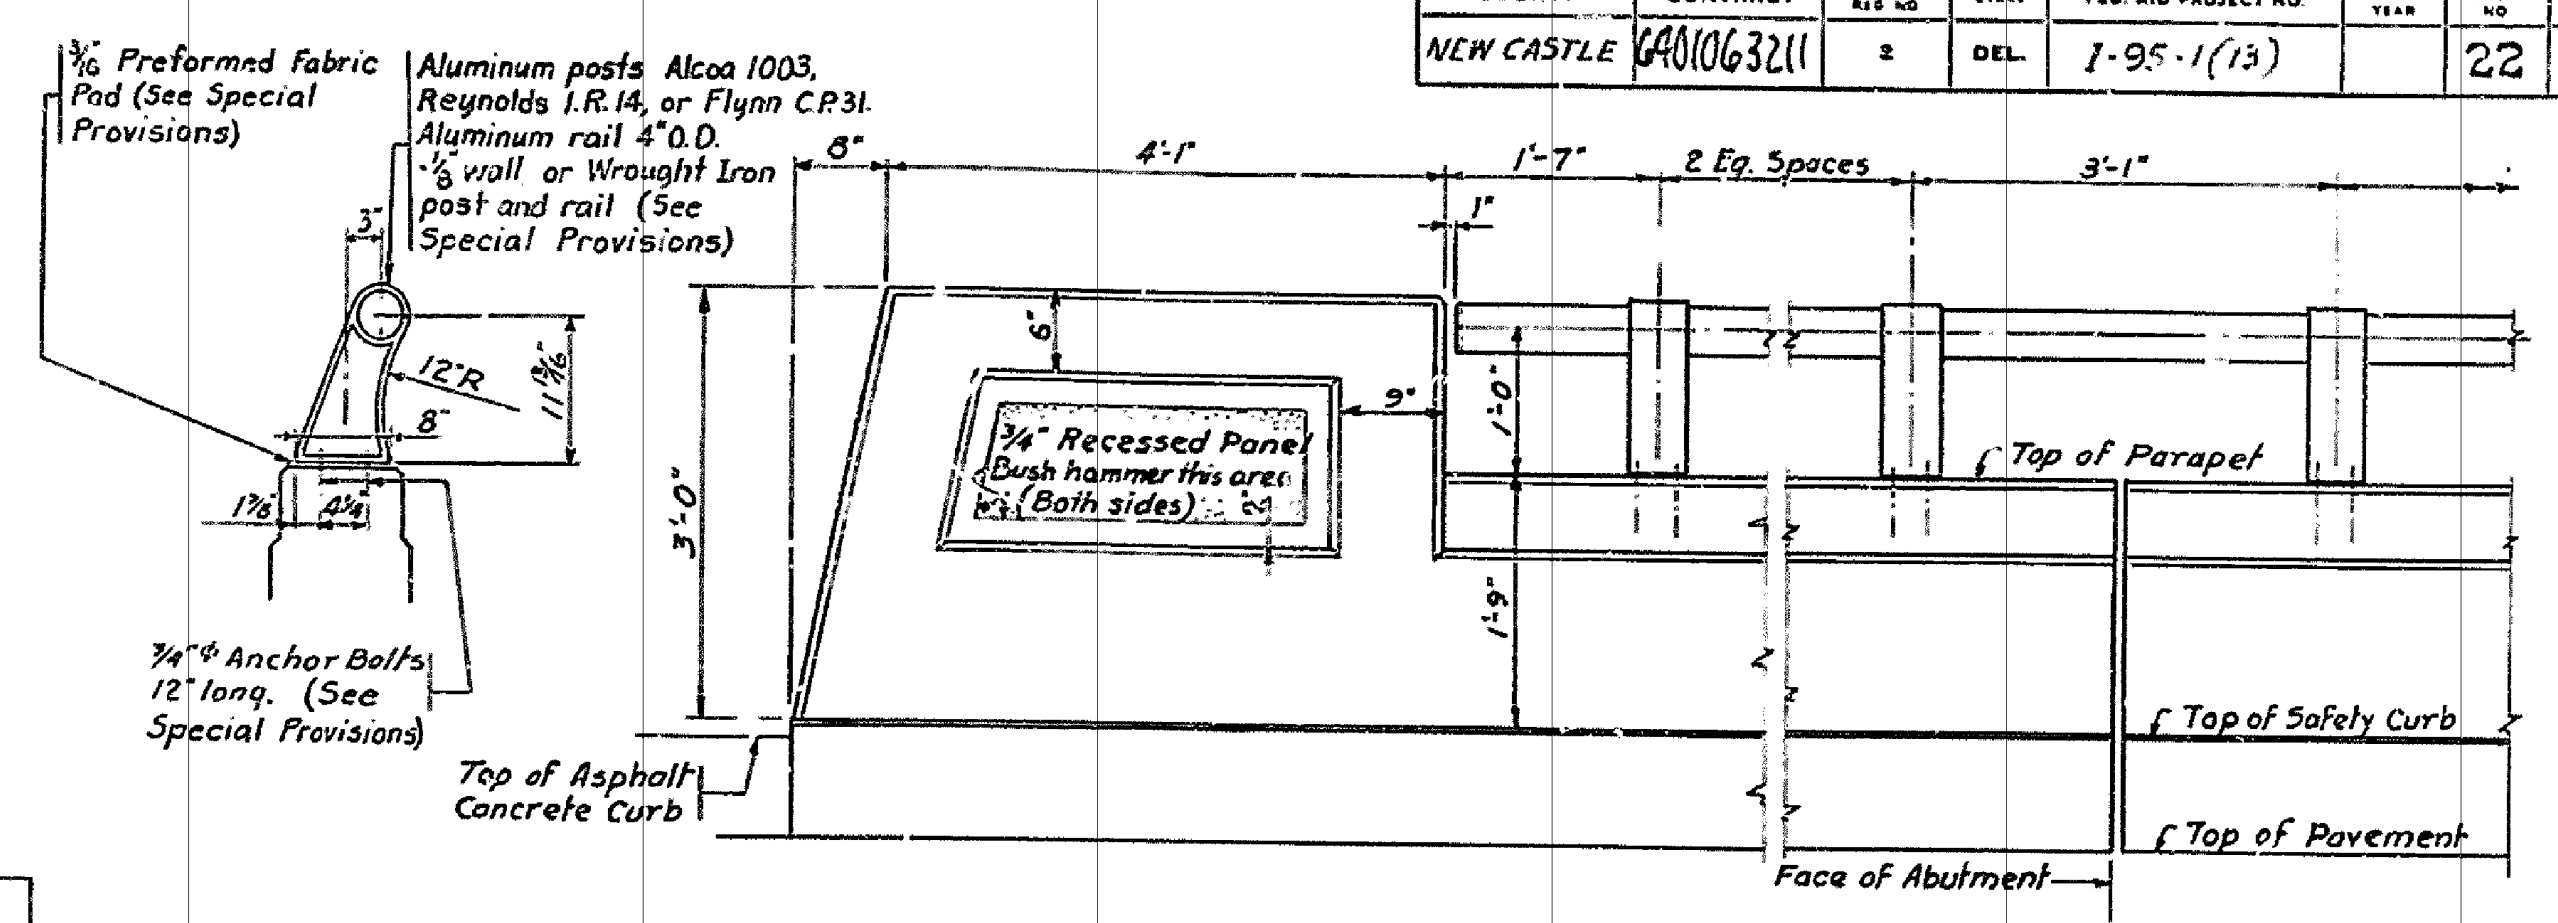


SECTION A-A

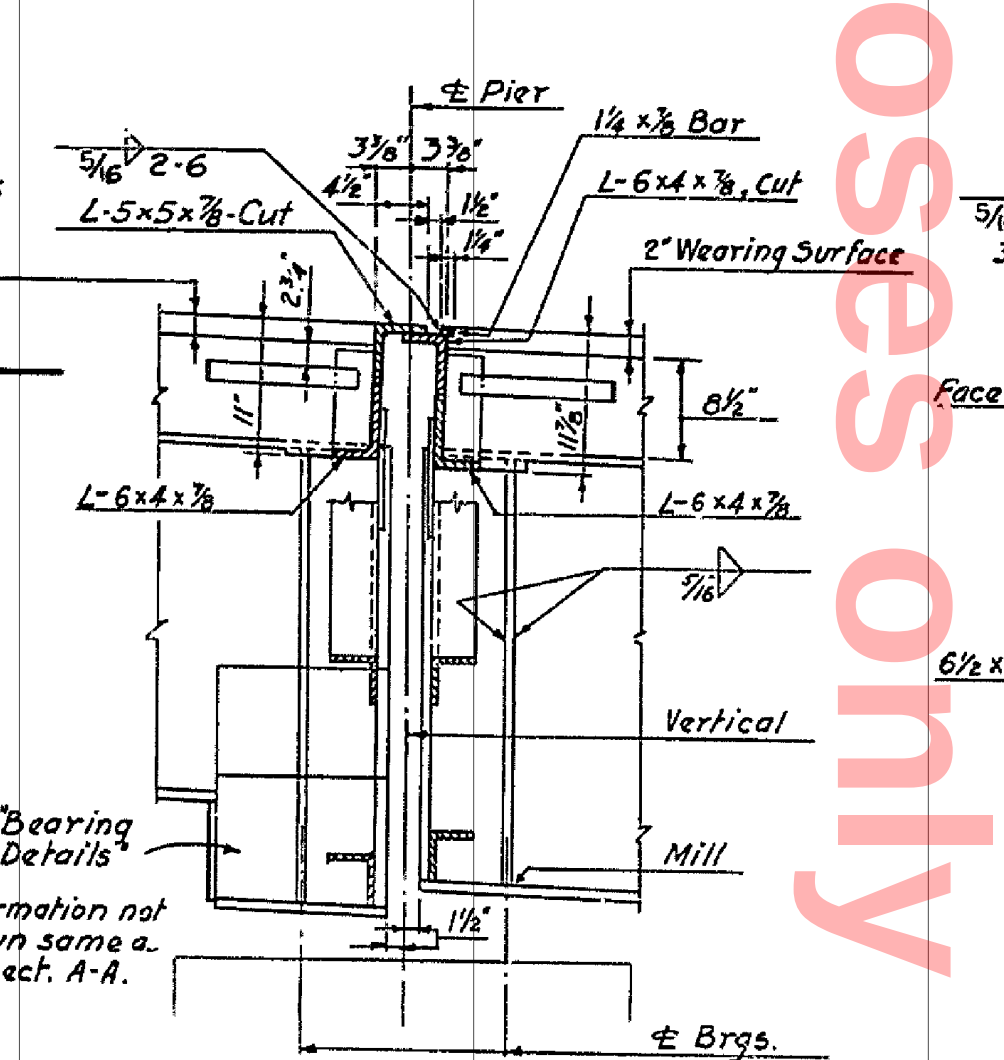


SECTION B-B

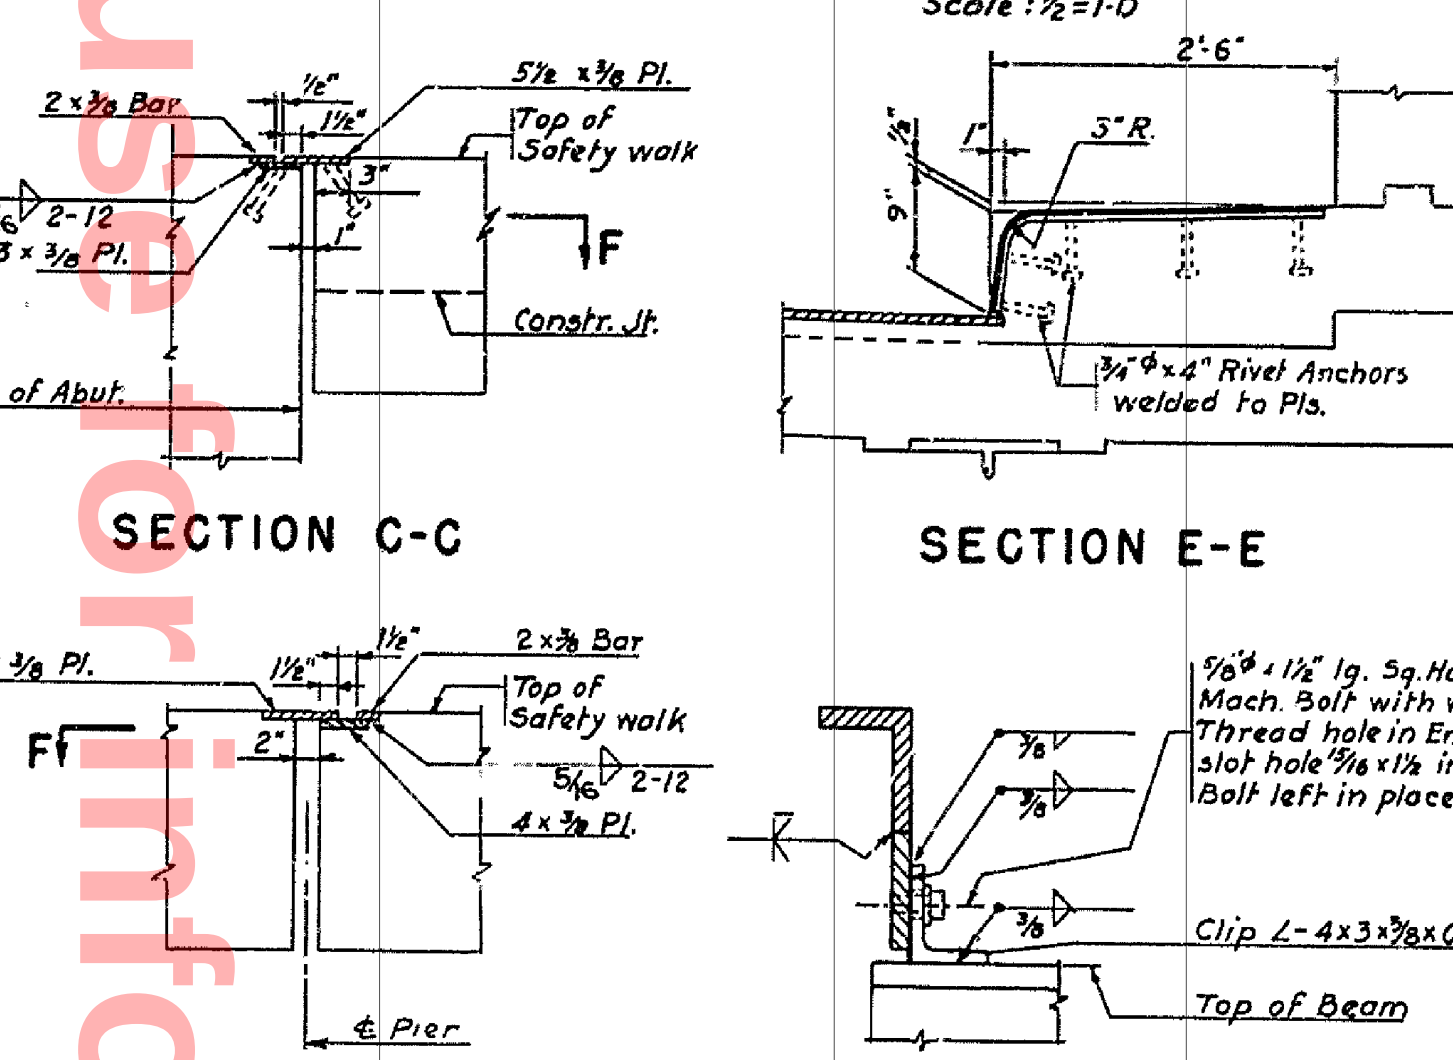

SECTION C-C

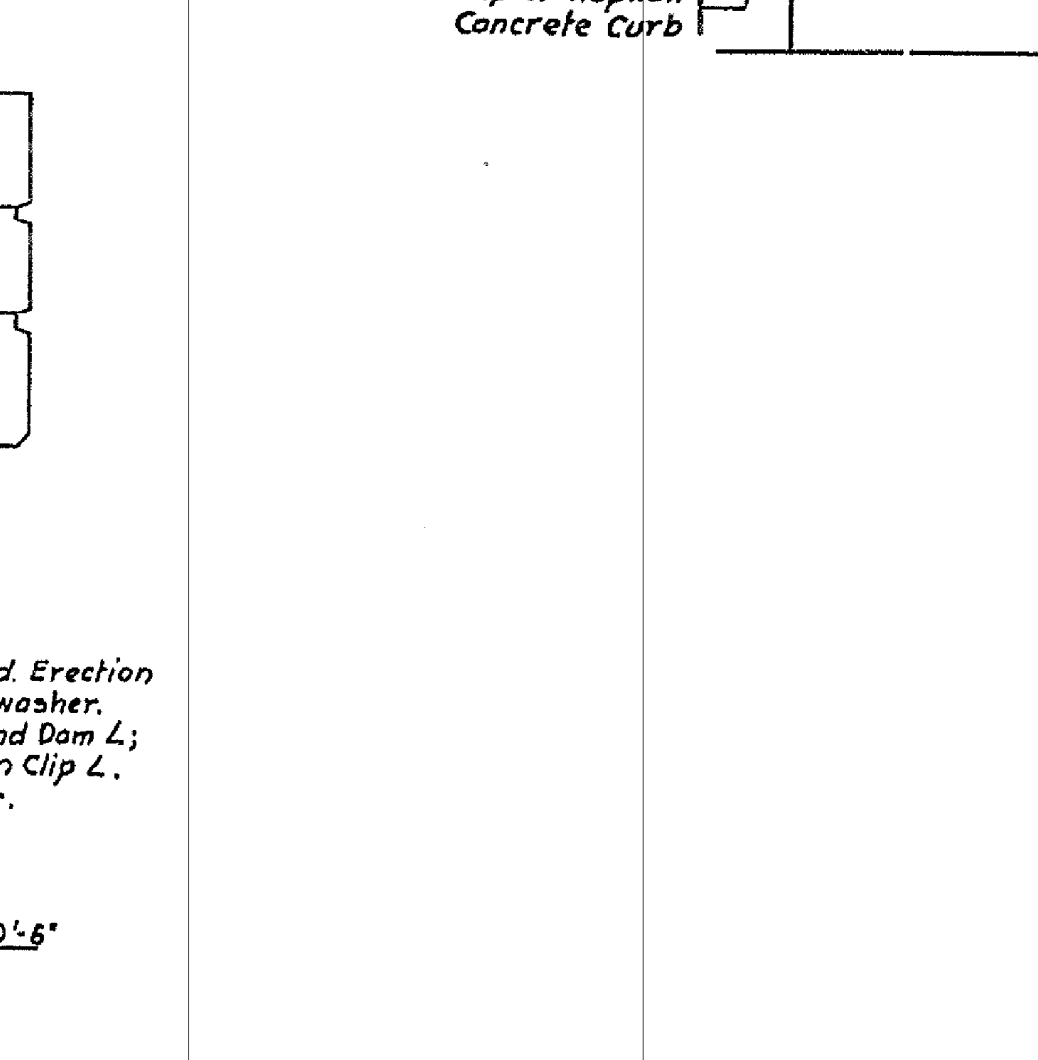


SECTION D-D

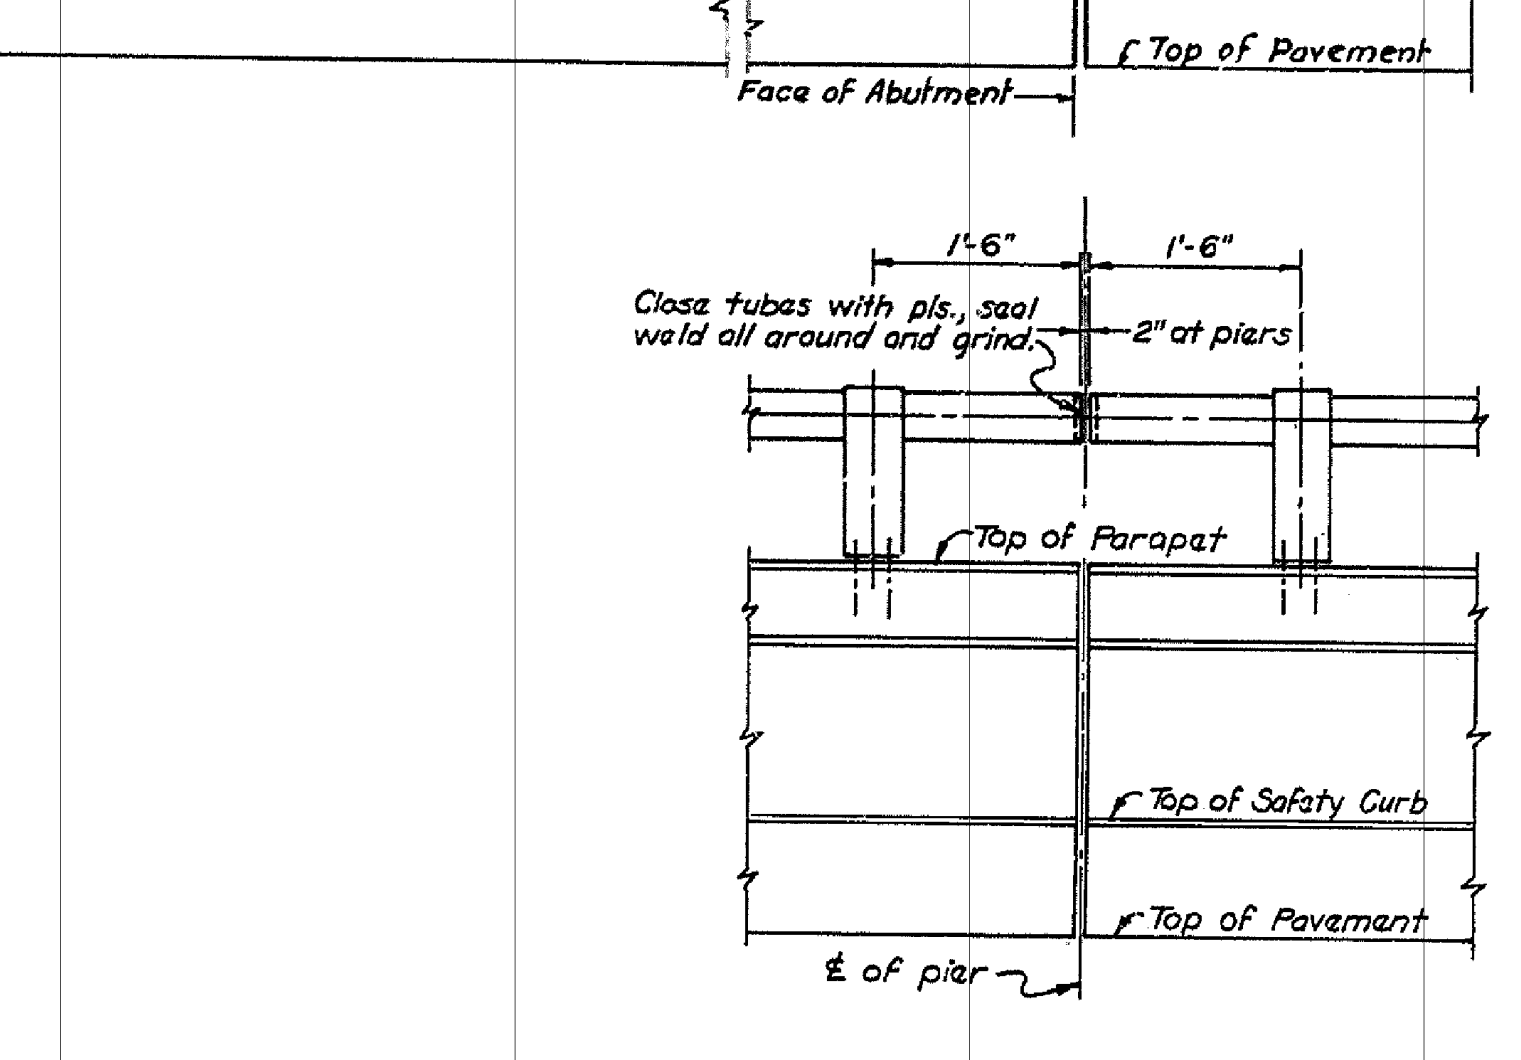


SECTION E-E


ROADWAY AND SIDEWALK DAMS

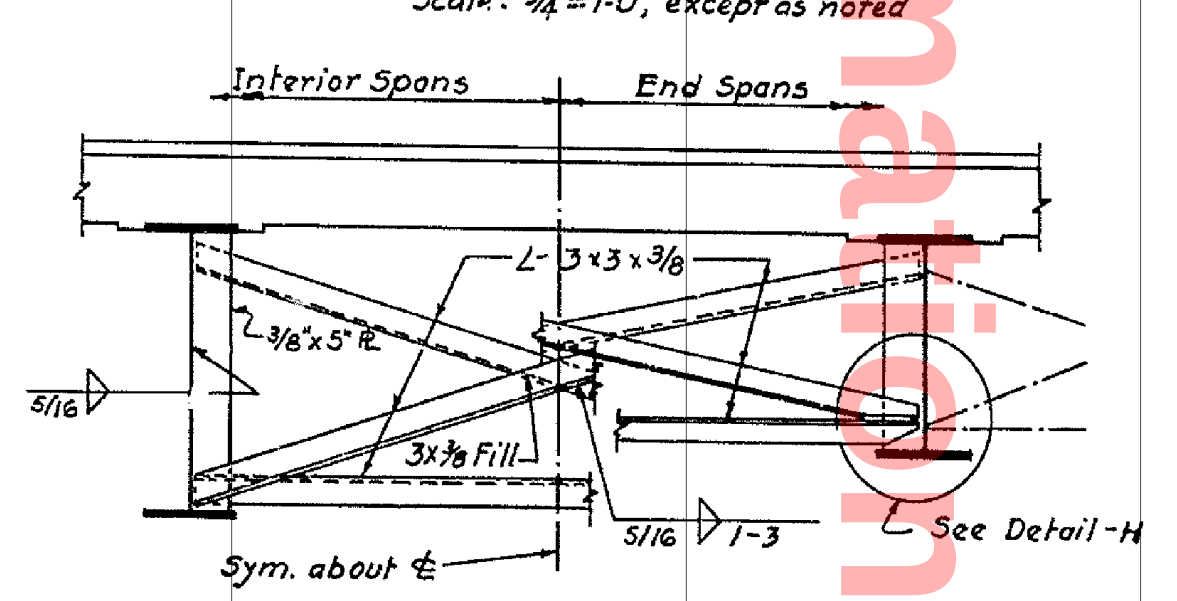

INTERMEDIATE-TYPE 12

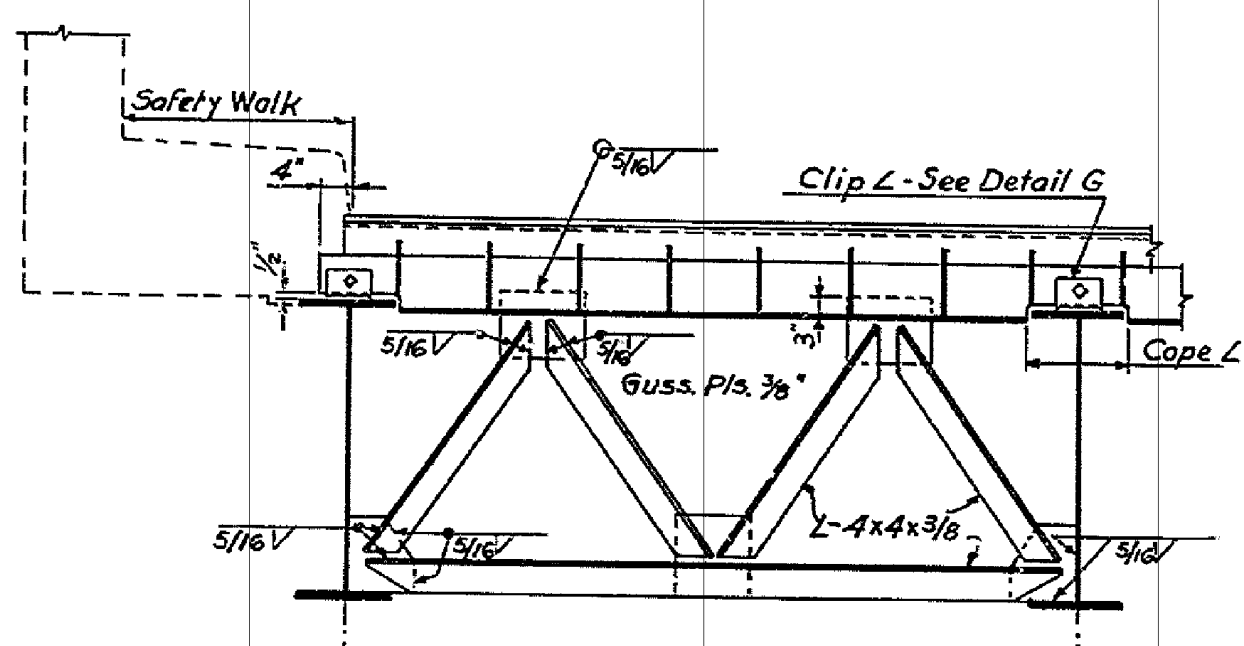


END-TYPES 11 & 14

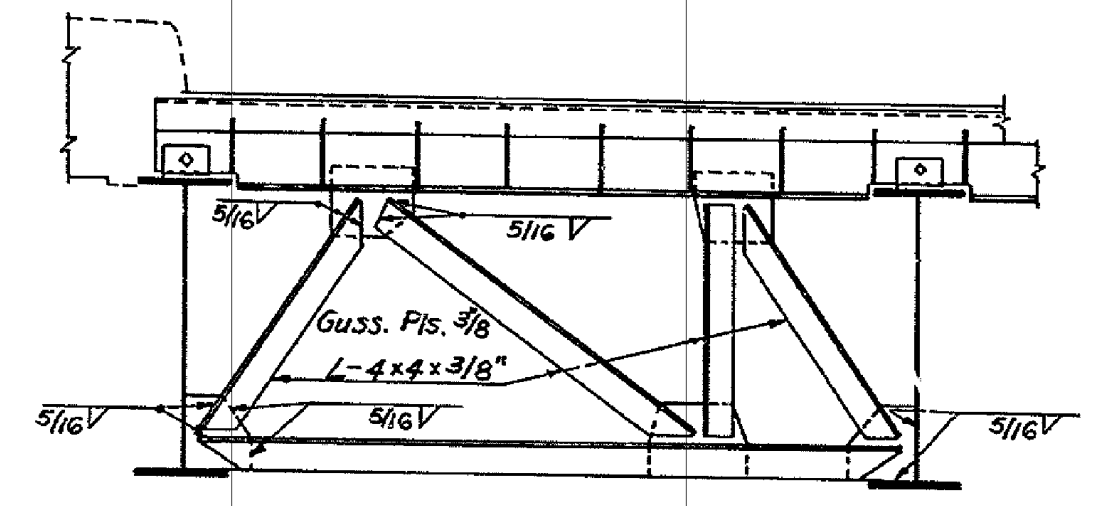

END-TYPE 15


CROSS FRAMES

Scale: 1/2"=1'-0"
Note: Types 14 and 15 are in sloping planes at downspouts.

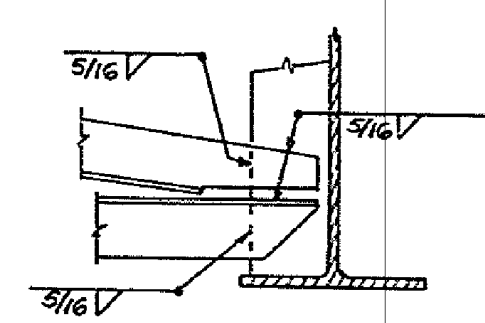


DETAIL-H

DETAIL-G

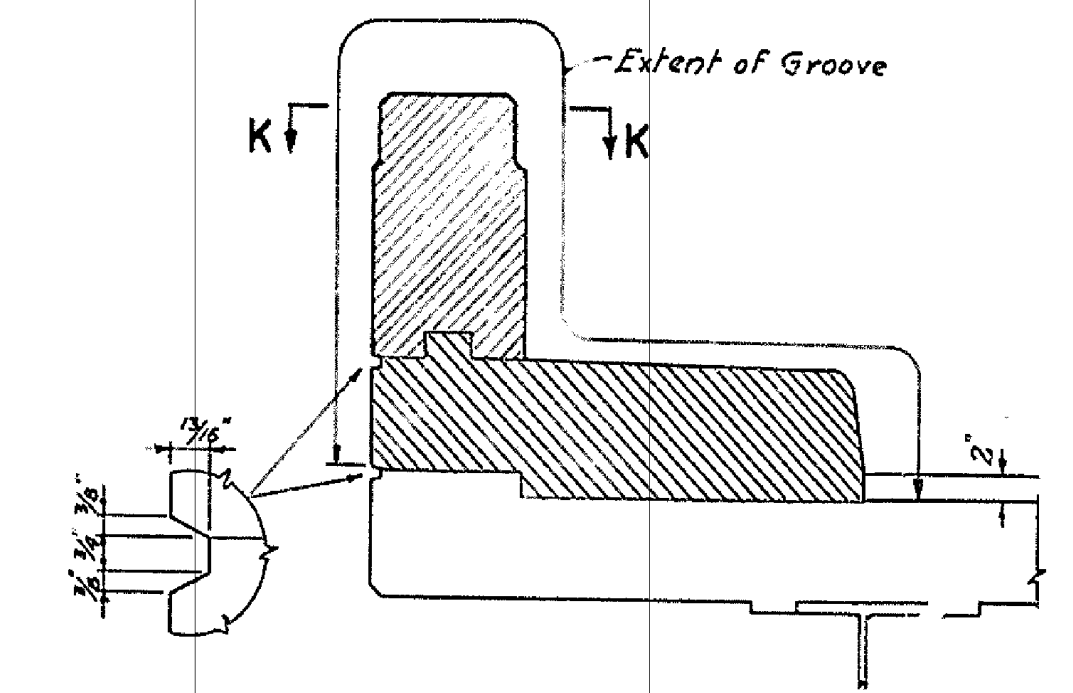

PARAPET CONTRACTION JOINT

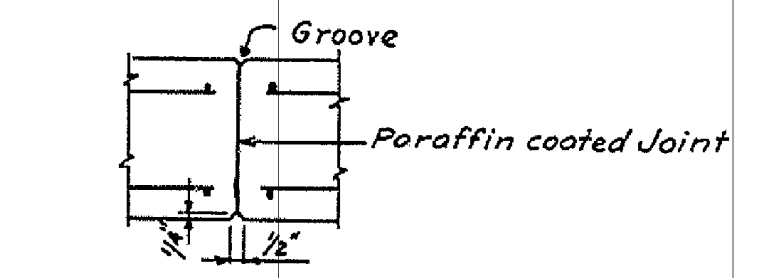

SECTION K-K

SLAB CONSTRUCTION JOINT

NOTE:
At all points of change in roadway cross-slope, cut, fit and butt weld expansion dam sections.

DELAWARE
STATE HIGHWAY DEPARTMENT
INTERSTATE ROUTE F.A.I.-1
CHRISTINA RIVER INTERCHANGE
BRIDGES NO. 6-6, 6-7, 8 6-8
SUPERSTRUCTURE DETAILS


J. E. GREINER CO.
MORAN, PROCTOR, MUESER & RUTLEDGE
CONSULTING ENGINEERS

DESIGNED: U.S. CHECKED: F.F.W. DATE: 12-19-63
DRAWN: IN CHARGE: S.M. SCALE: AS SHOWN



APPROVED: [Signature] BRIDGE ENGINEER






COUNTY	CONTRACT	F. & M. NO.	STATE	FED. AID PROJECT NO.	FISCAL YEAR	SHEET NO.	TOTAL SHEETS
NEW CASTLE	6401063211	2	DEL.	1-95-1(13)		25	26

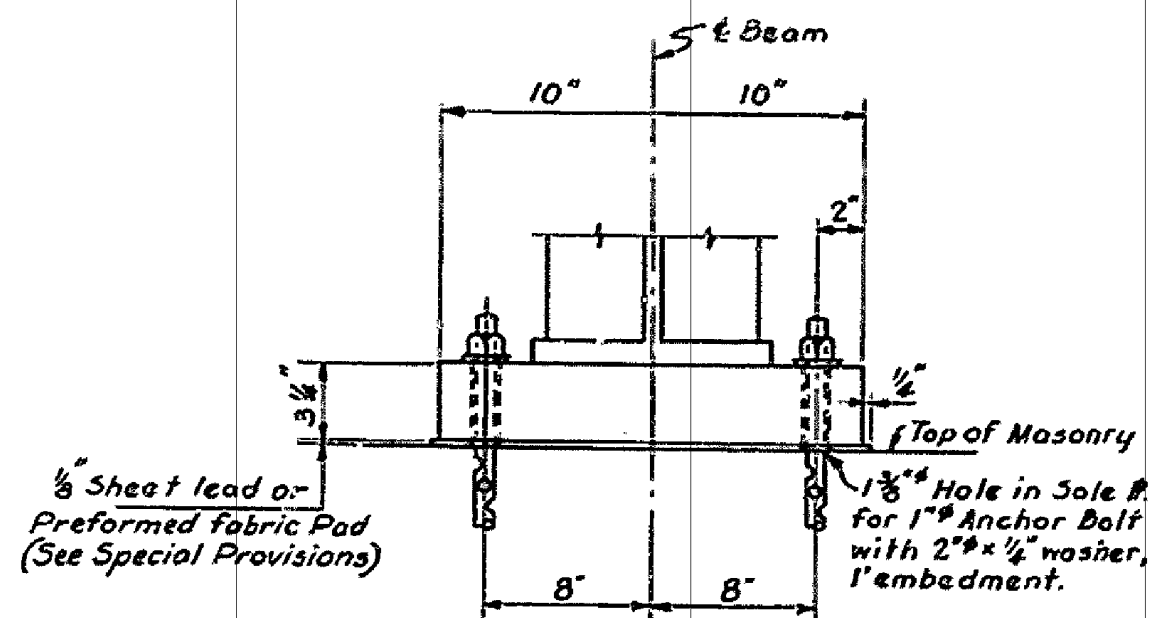

TYPE F1

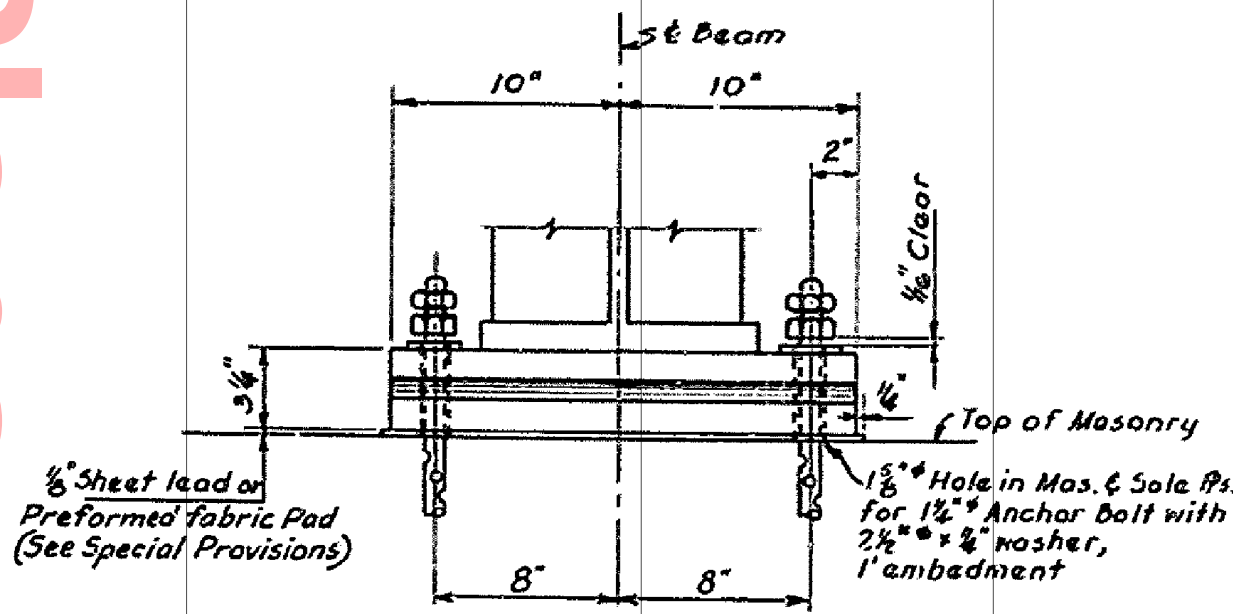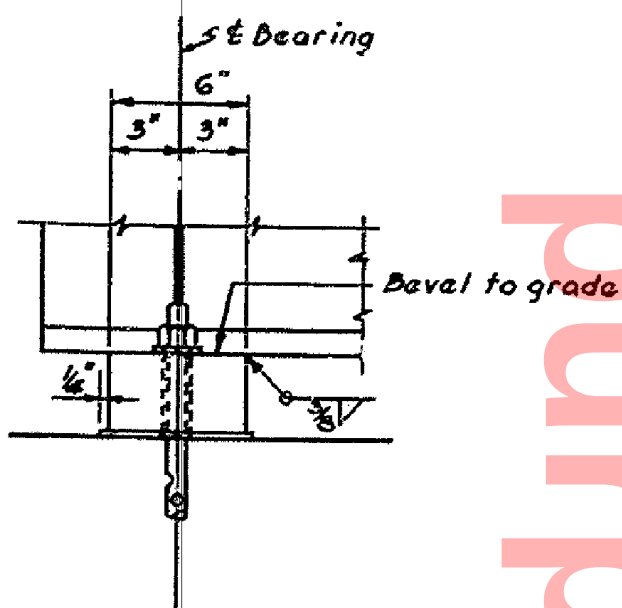


TYPE F2

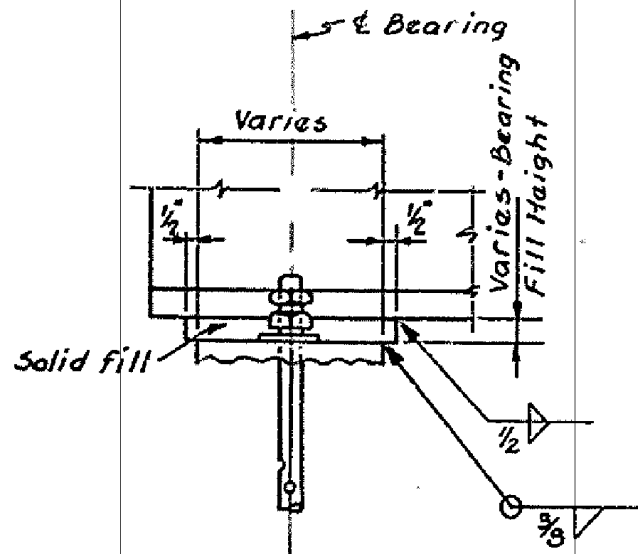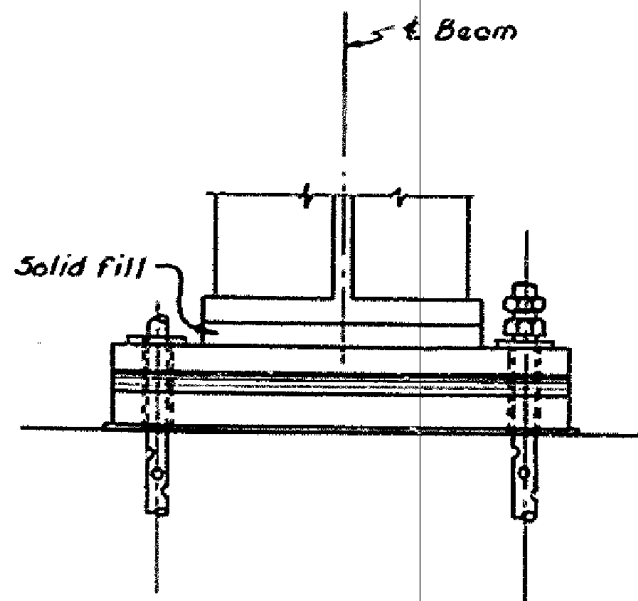
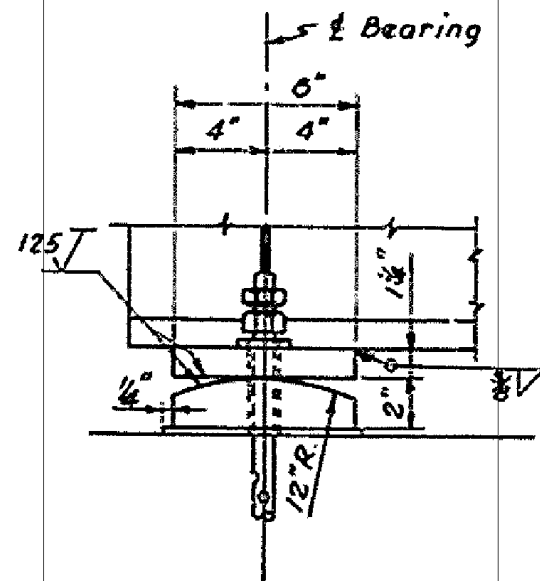


SOLID FILL
1 1/2" = 1'-0"



Where bearing fill is 1/2" or less in thickness it shall be made the same width as the sole plate. The bearing fill and sole plate shall be welded to the bottom flange of the beam with a fillet weld the size of which shall be 3/8" plus the thickness of the bearing fill.

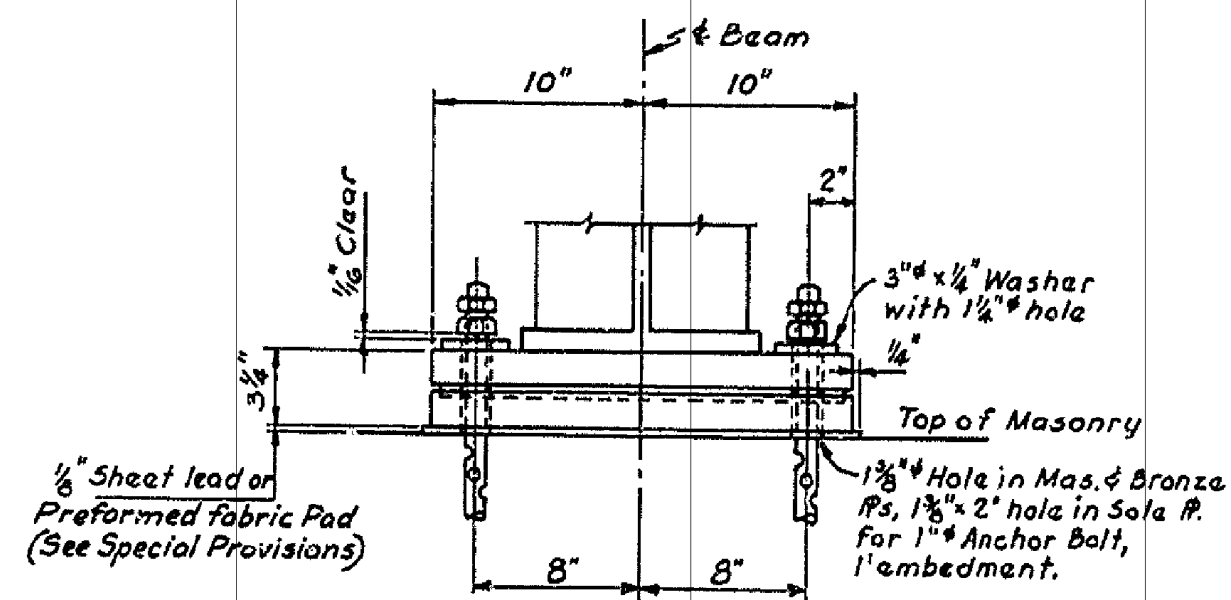

TYPE E1

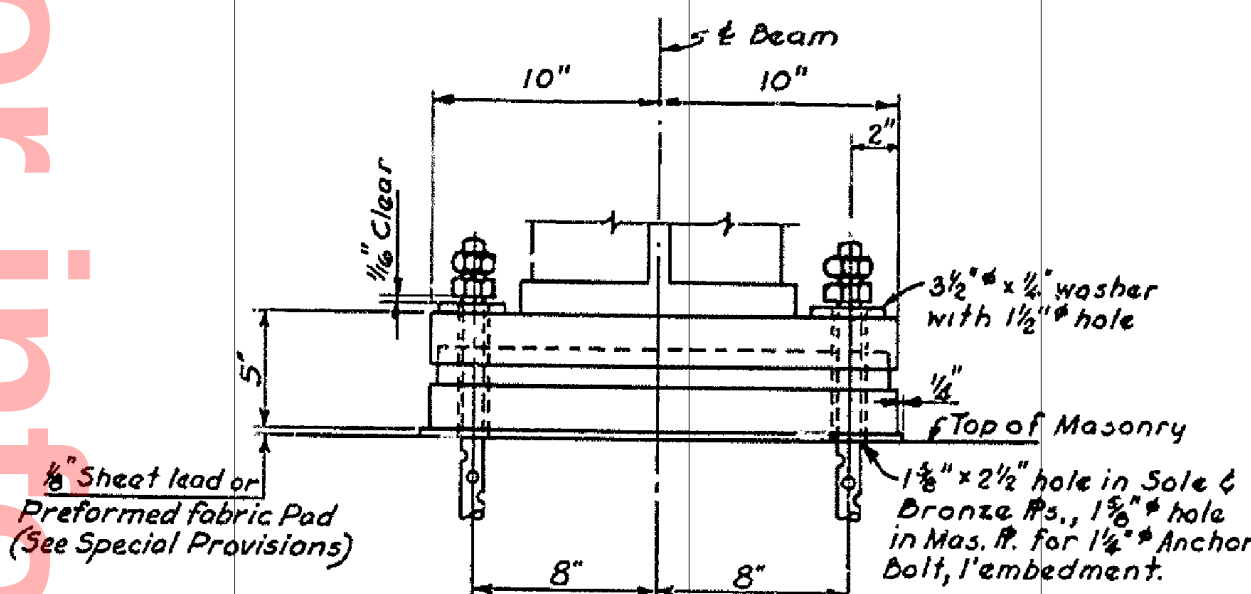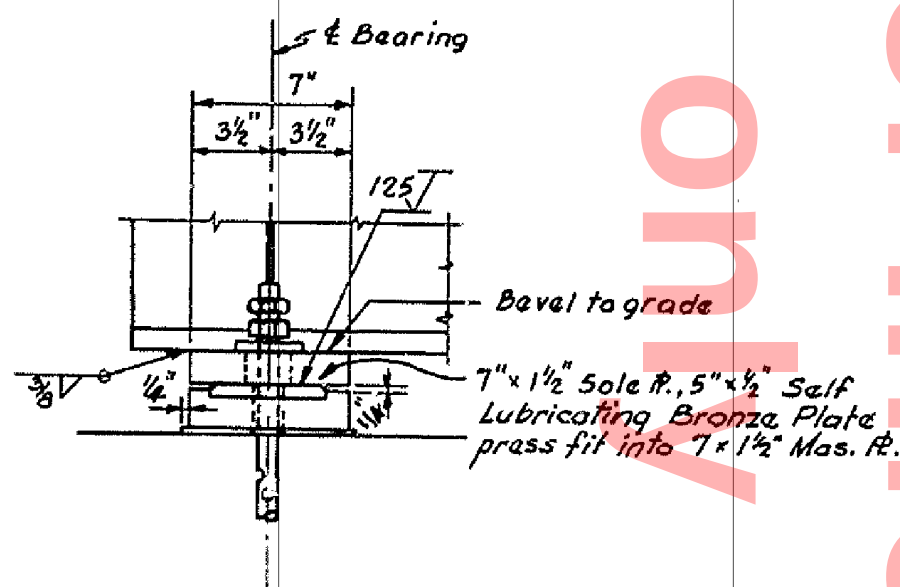

TYPE E2

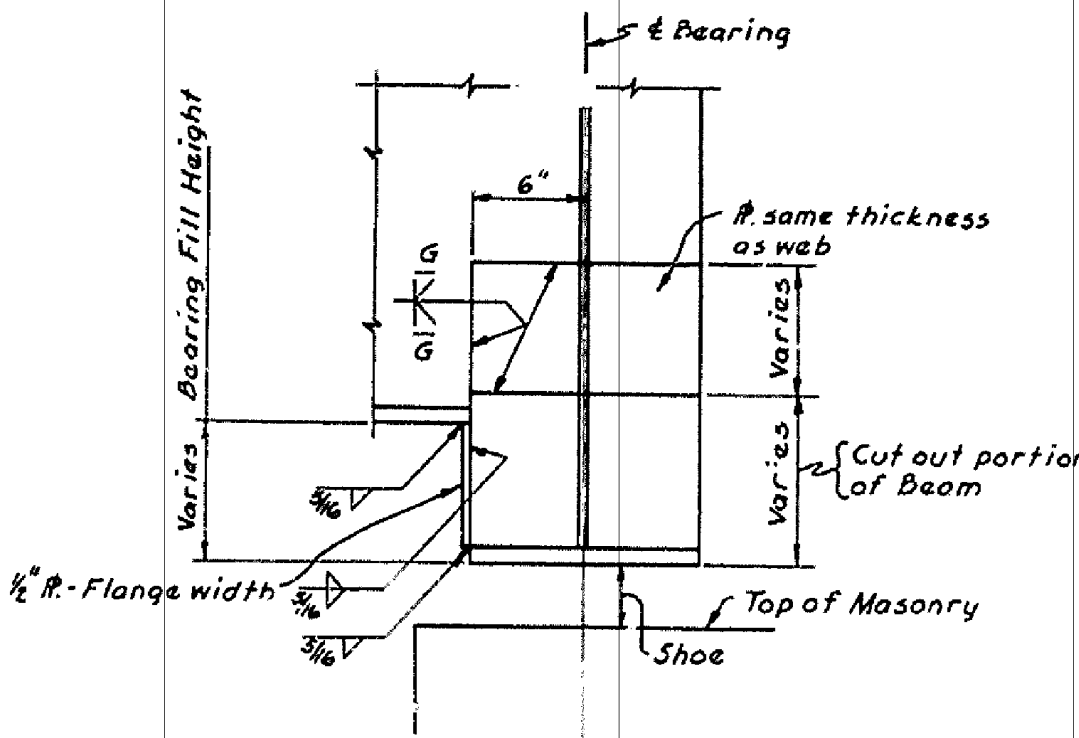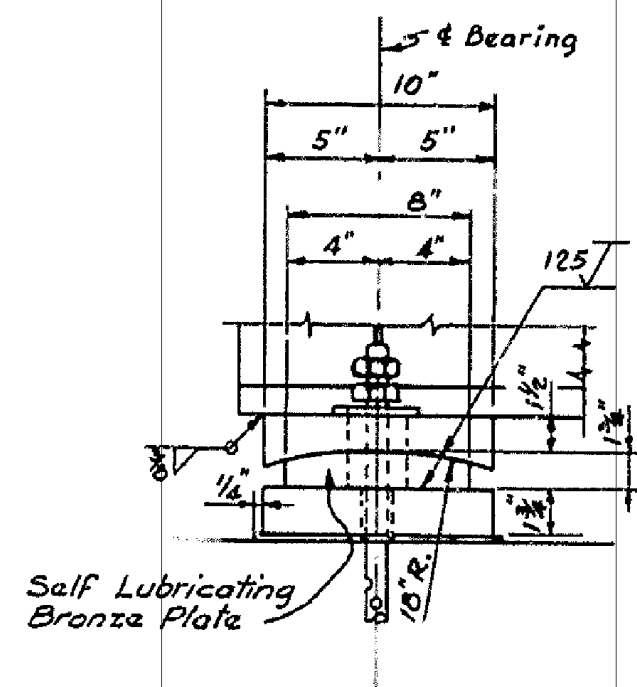


STOOl
1" = 1'-0"

BEARING FILLS

NOTES:
Corners of masonry plates shall be cut where necessary to provide a minimum of 3/8" to the edge of pier cap.
The surface finish of metal in contact indicated by the symbol V shall meet the requirements as defined in American Standard Association Specification ASD-461.
All sliding surfaces to be finished in the direction of expansion or rotation.

ANCHOR BOLT DETAILS
1 1/2" = 1'-0"

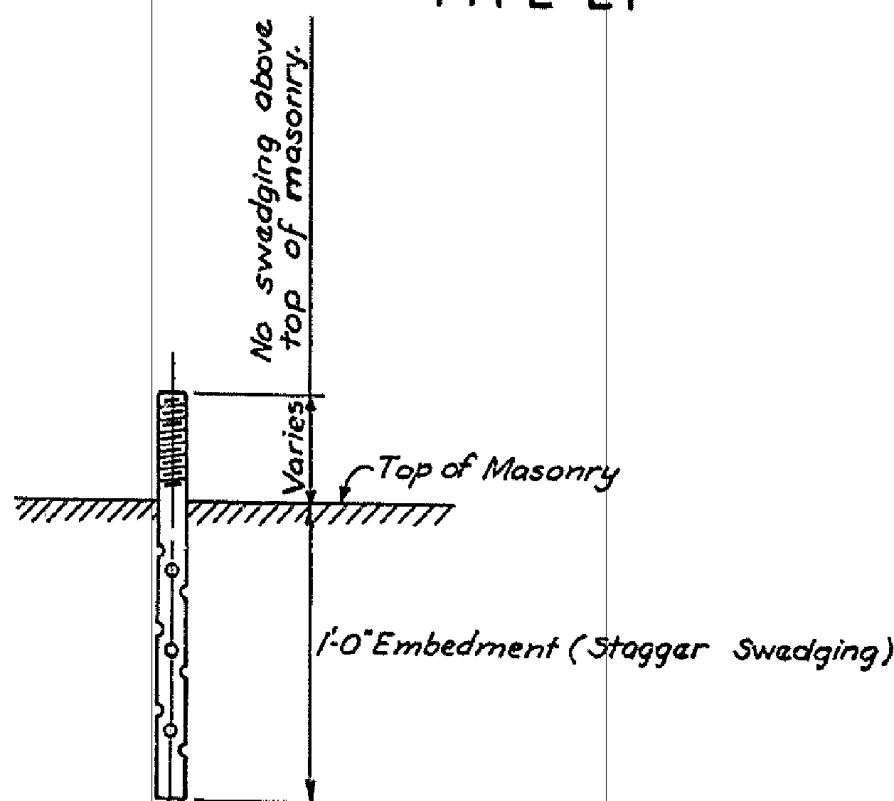

EXPANSION SHOES
1 1/2" = 1'-0"

DELAWARE
STATE HIGHWAY DEPARTMENT

INTERSTATE ROUTE F.A.I.-1
CHRISTINA RIVER INTERCHANGE





BRIDGES NO. 6-6, 6-7, & 6-8
BEARING DETAILS

J.E. GREINER CO.
MORAN, PROCTOR, MUESER & RUTLEDGE
CONSULTING ENGINEERS




DESIGNED: S.J.S. CHECKED: F.F.W. DATE: 12-18-63
DRAWN: K.V.W. IN CHARGE: C.B.M. SCALE: AS SHOWN

APPROVED _____
BRIDGE ENGINEER

COUNTY	CONTRACT	P. & S. NO.	STATE	FED. AID PROJECT NO.	FISCAL YEAR	SHEET NO.	TOTAL SHEETS
NEW CASTLE	6A01063211	2	DEL.	1-95-1(13)		24	26

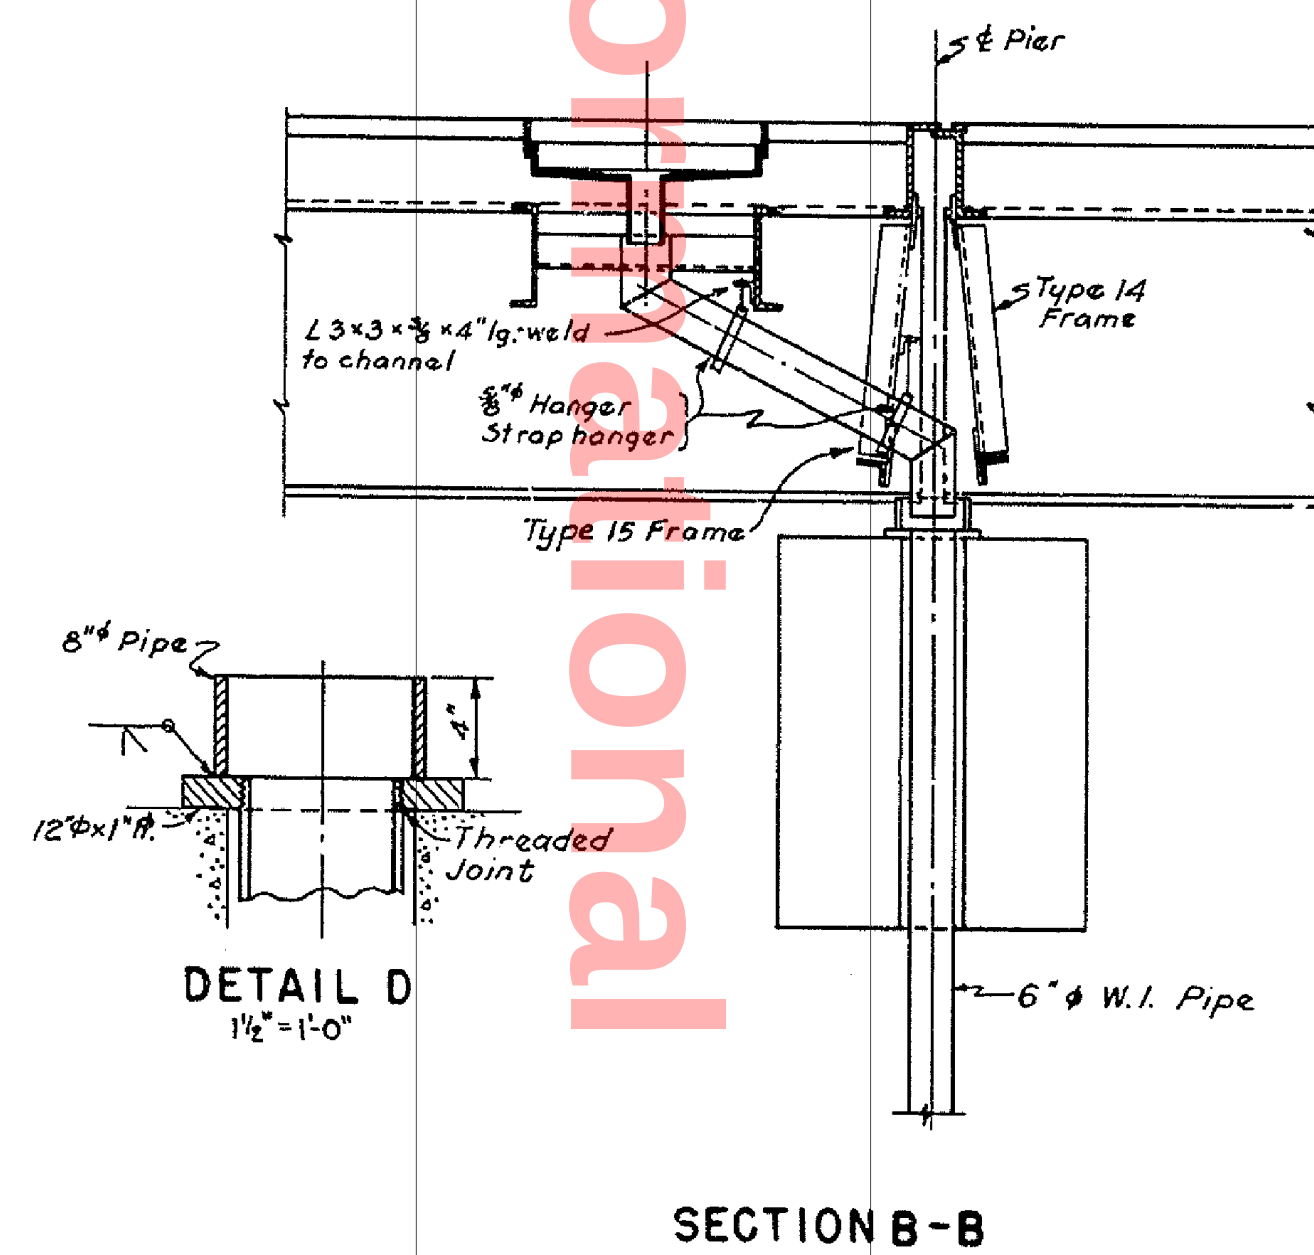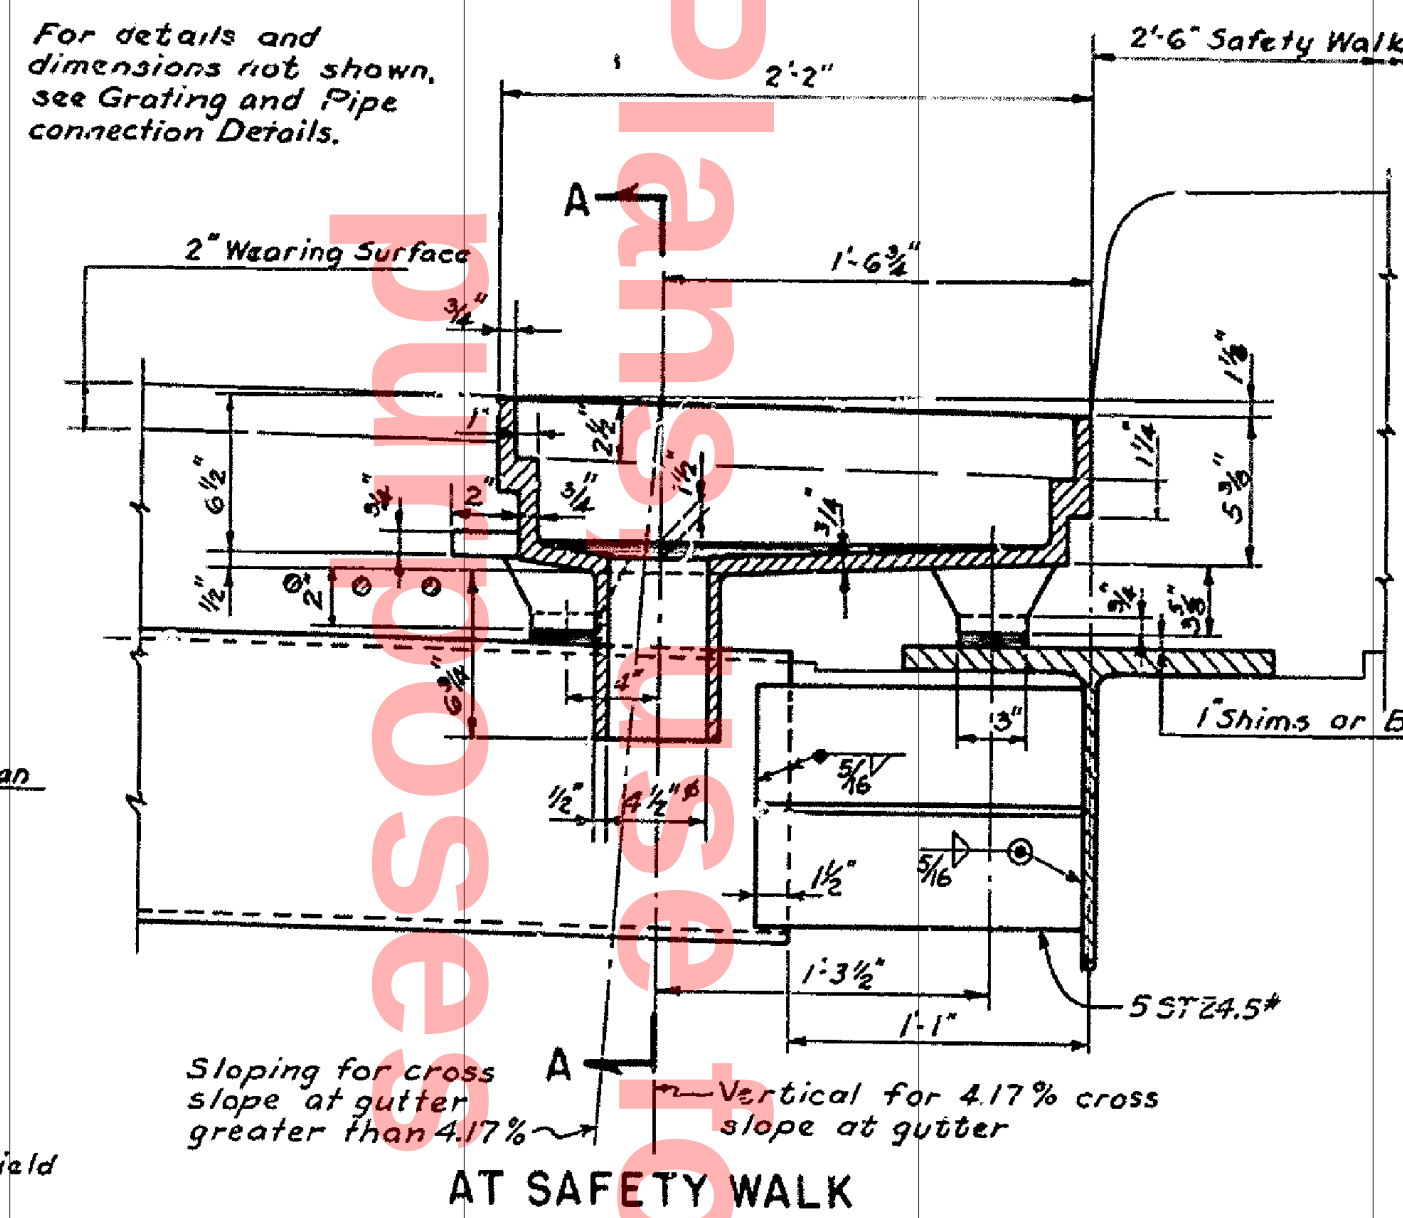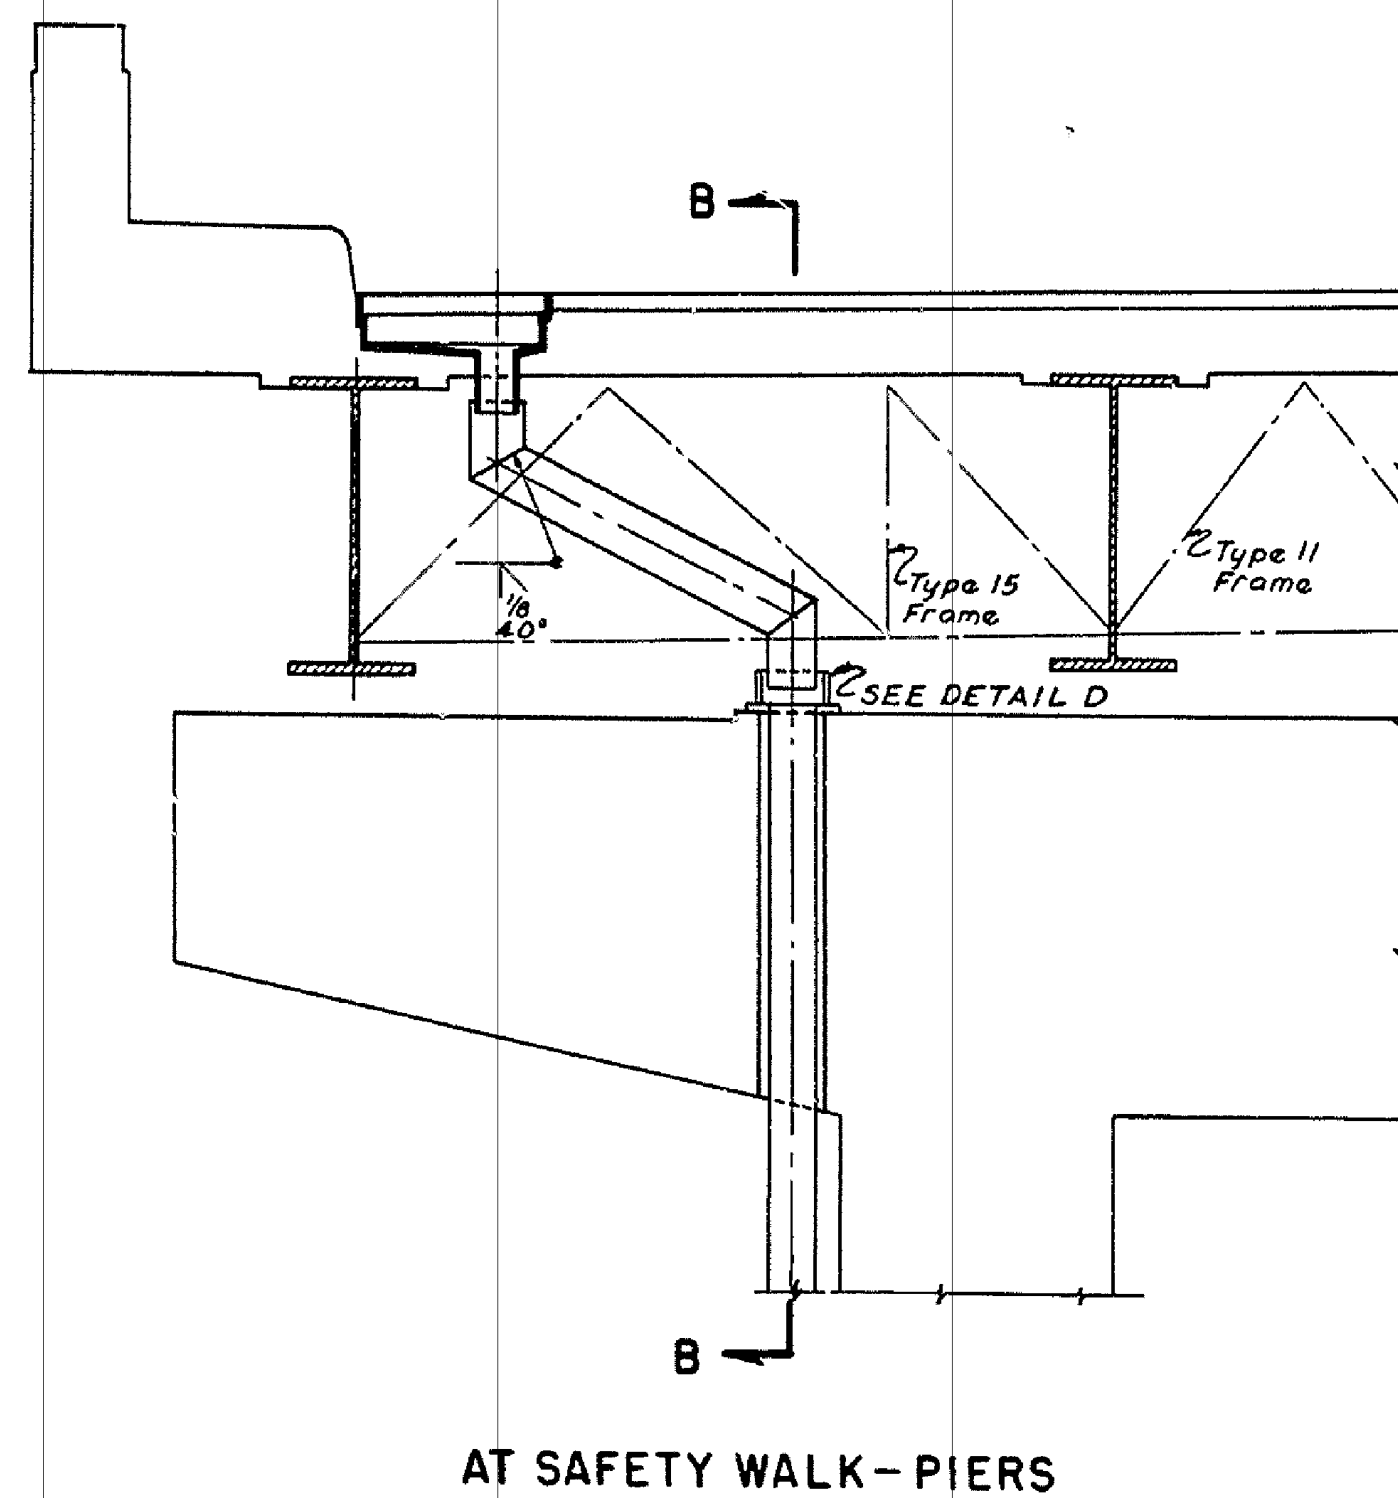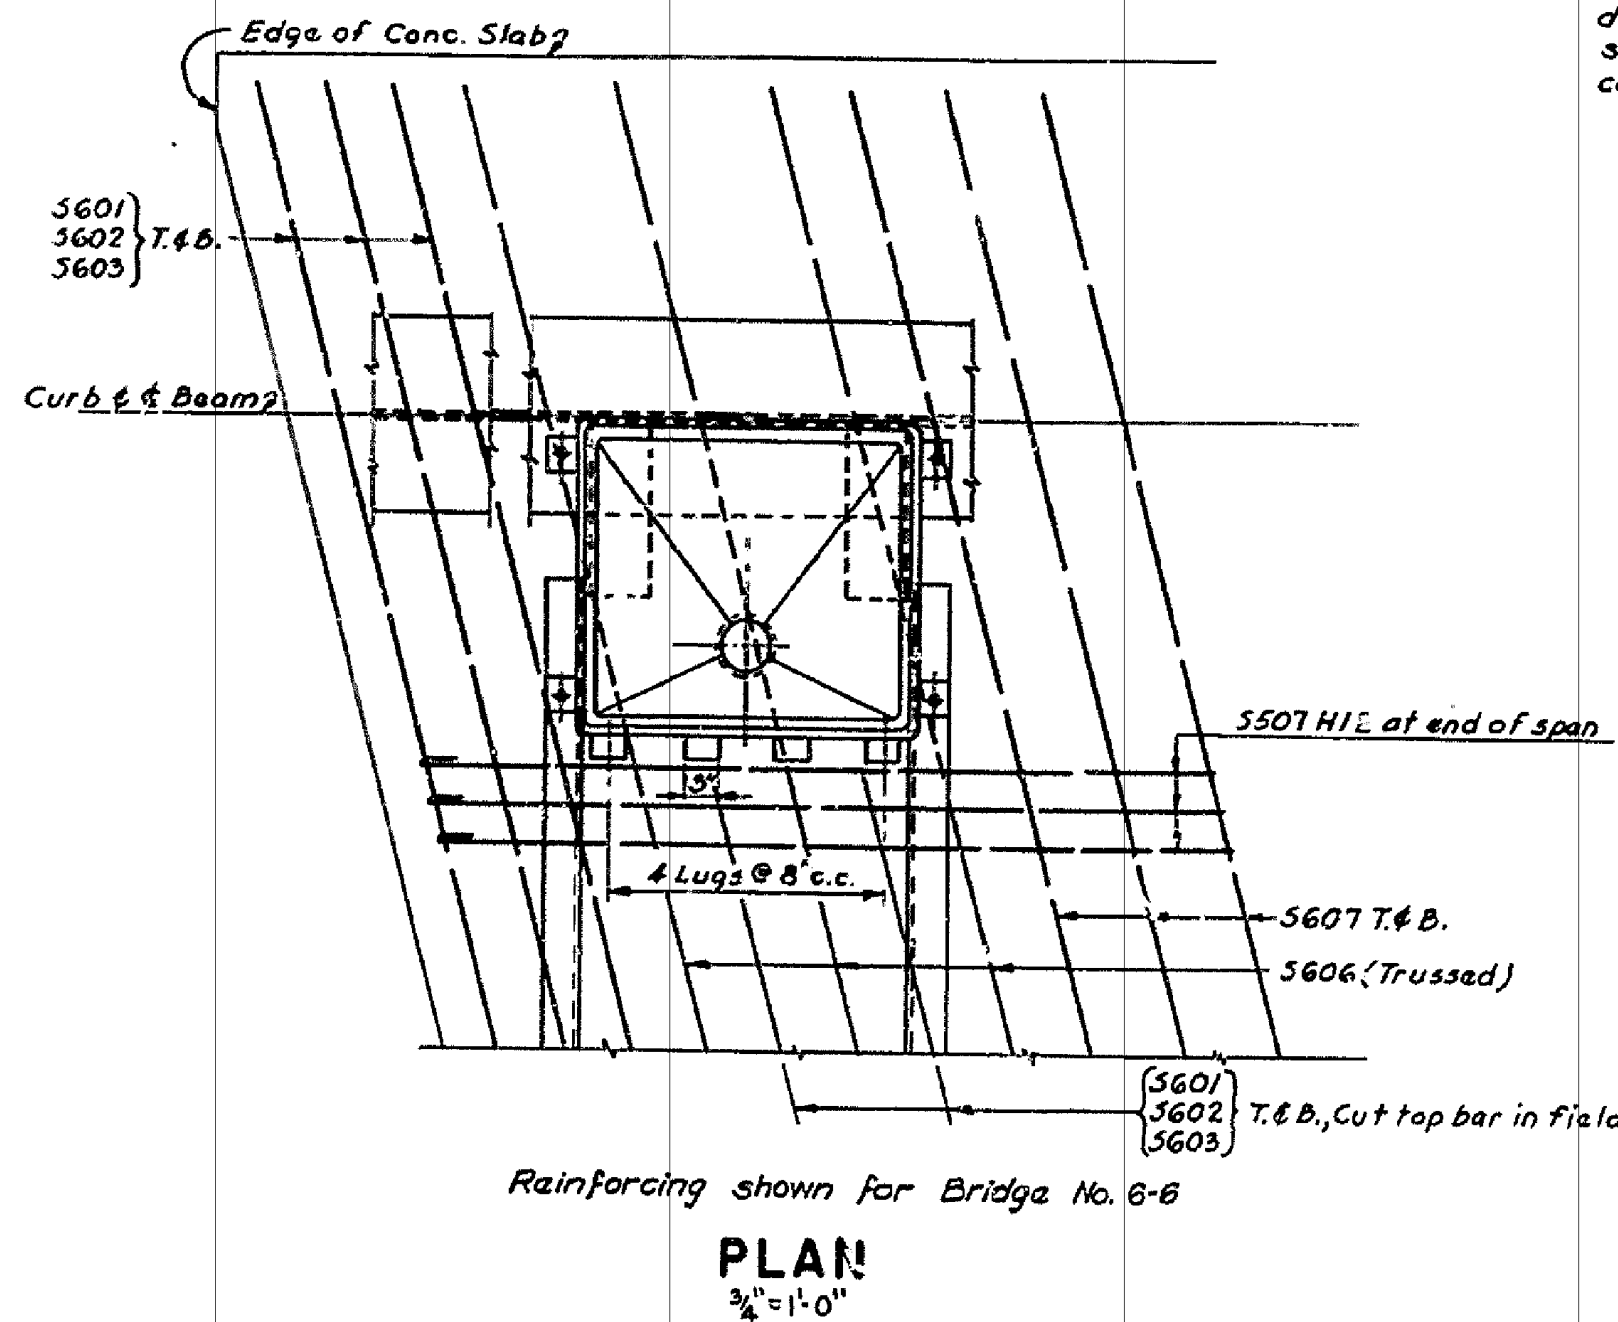

PIPE CONNECTIONS
1/2" = 1'-0"

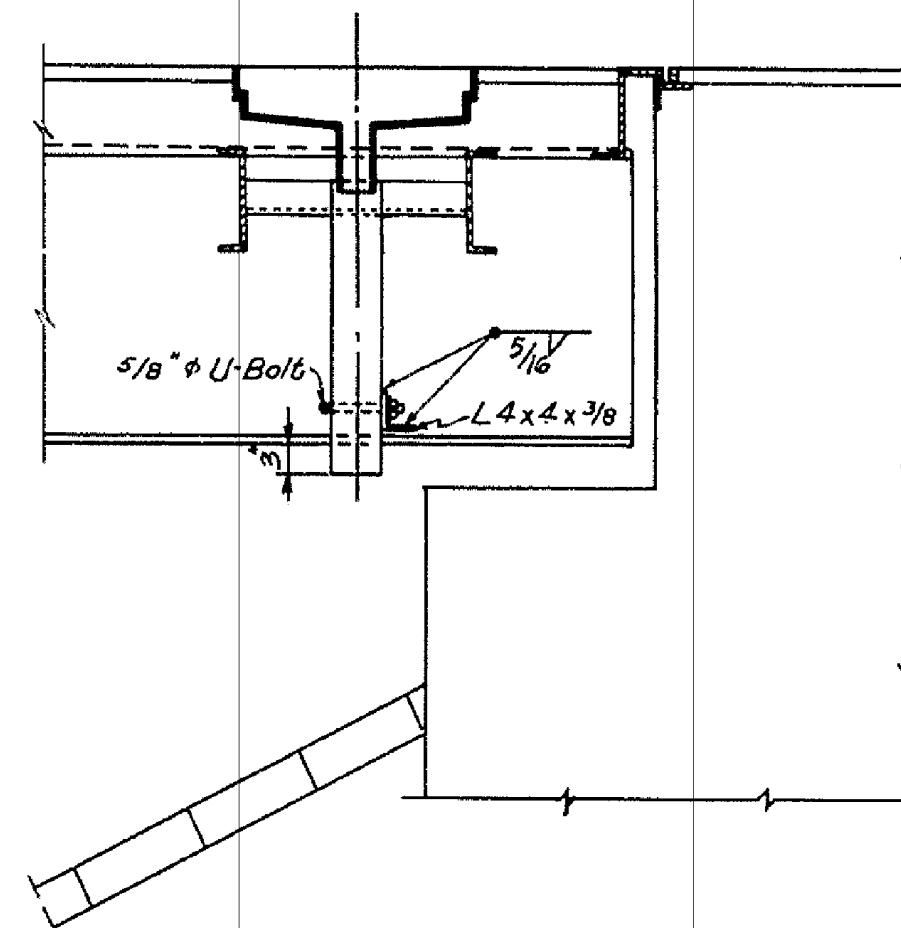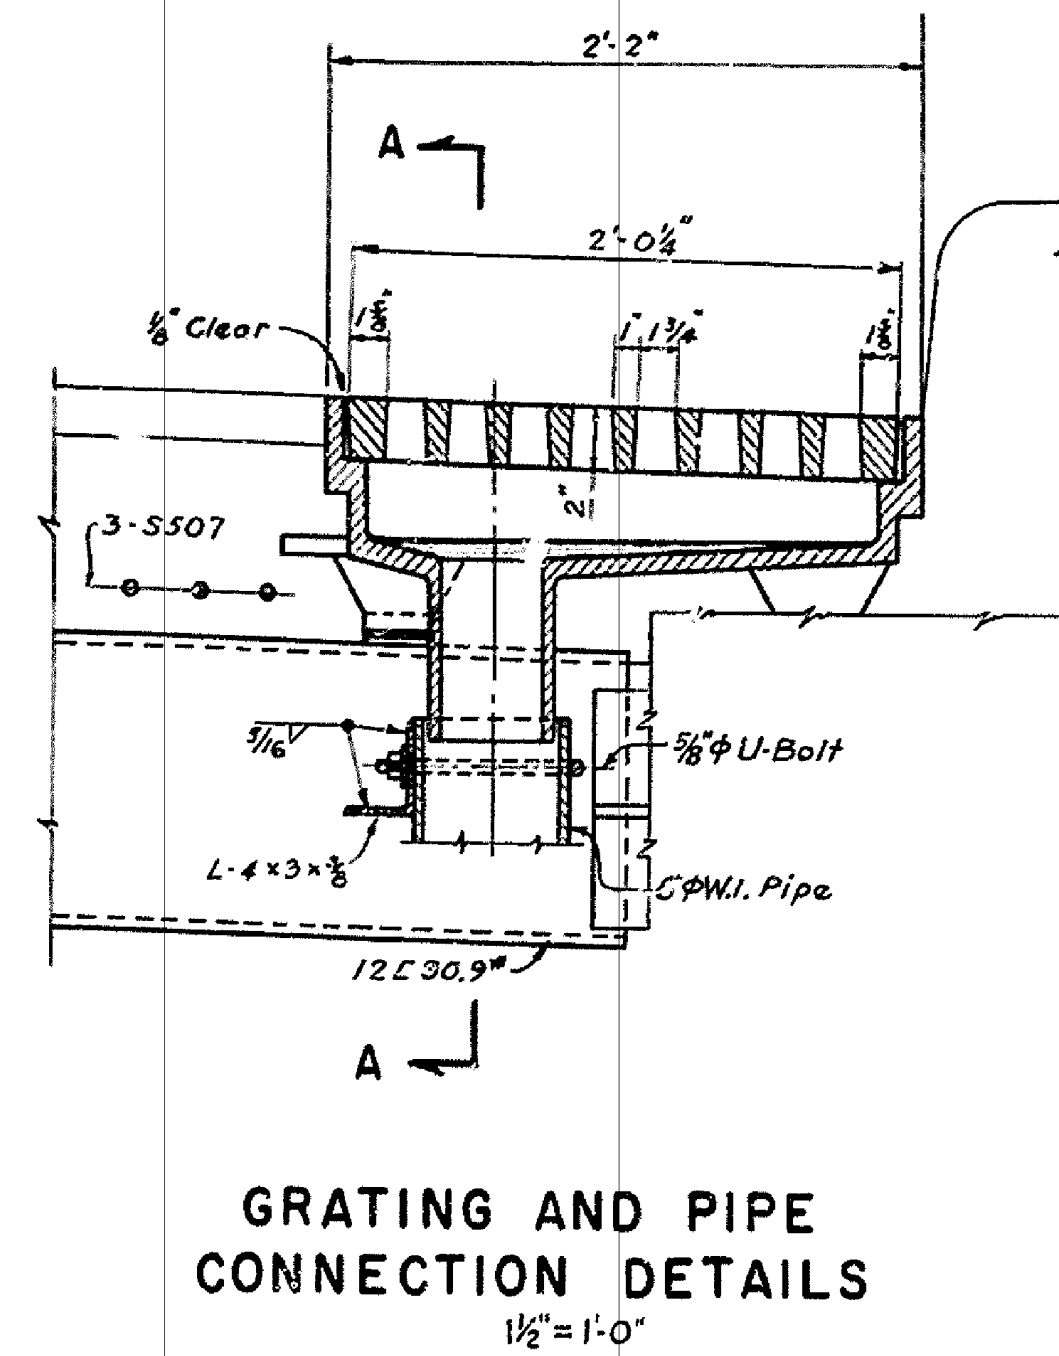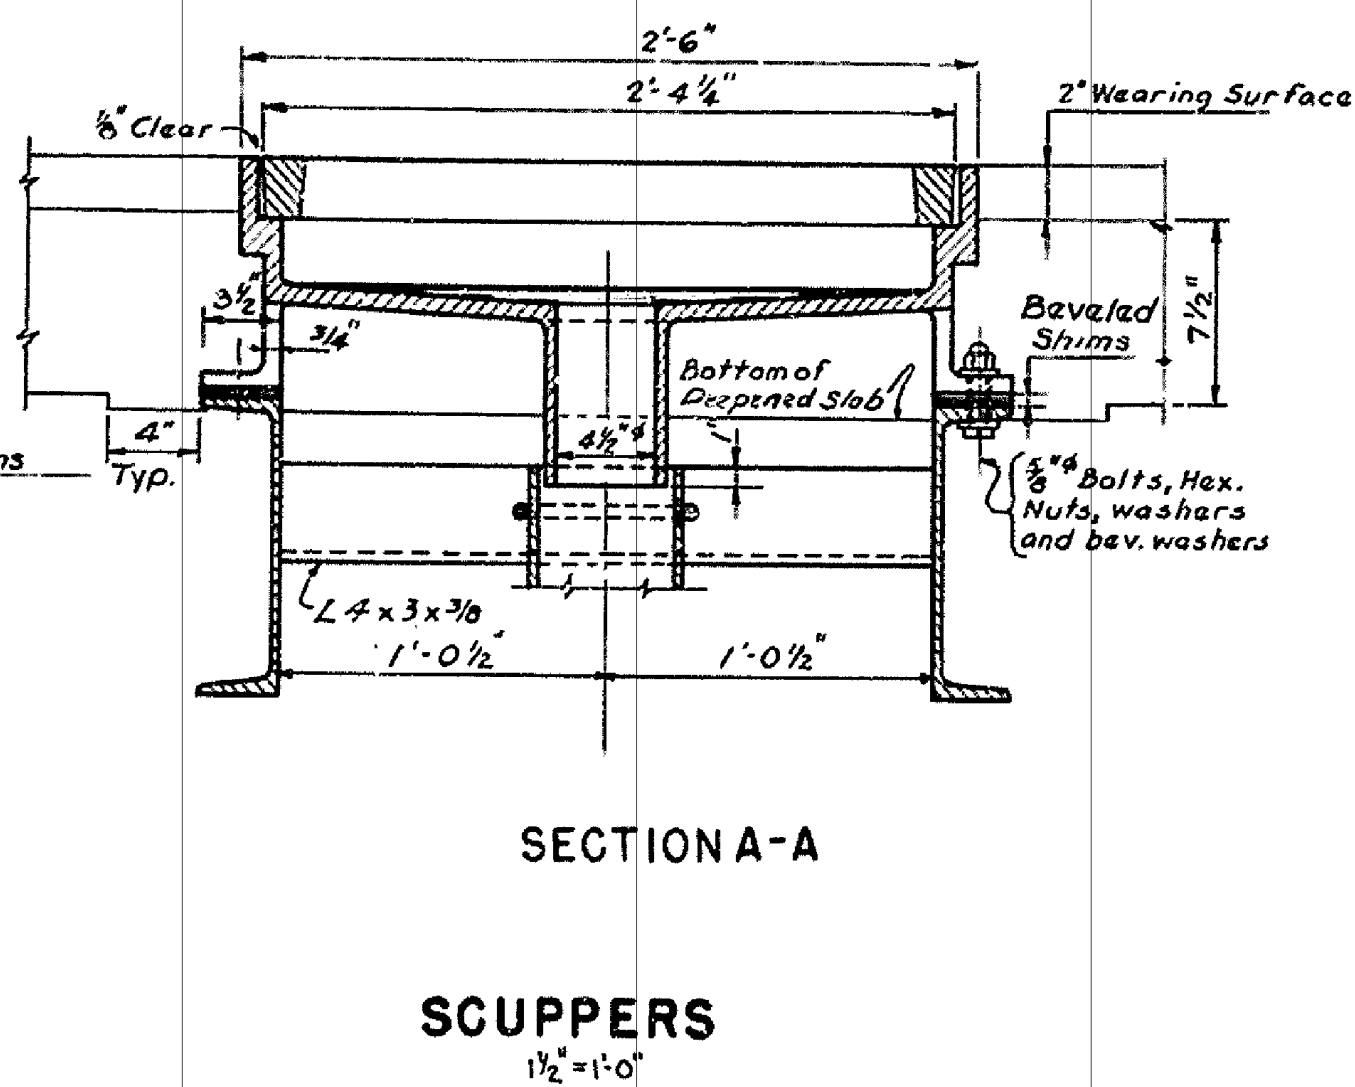


Notes:
 AT ABUTMENT
 For General Notes see Sheet No. 2.
 All gratings to be cast steel in accordance with A.S.T.M. A-27, Grade 65-35, galvanized.
 All frames to be cast iron in accordance with A.S.T.M. A-48, Class N° 30, galvanized. (See Special Provisions.)
 All drain pipe to be 6" W.I.
 Pipe supports shall be spaced 12' maximum.
 For details of pipe outlet and pipe supports, see Slope Protection and Drainage Details sheet No. 25


DELAWARE STATE HIGHWAY DEPARTMENT	
INTERSTATE ROUTE F.A.I.-1 CHRISTINA RIVER INTERCHANGE	
BRIDGES NO. 6-6, 6-7, 8 6-8 SCUPPER DETAILS	
J. E. GREINER CO. MORAN, PROCTOR, MUESER & RUTLEDGE CONSULTING ENGINEERS	
DESIGNED: J.E.G.	CHECKED: A.L.N. DATE: 12/18/63
DRAWN: M.V.V.	IN CHARGE: G.B.M. SCALE: AS SHOWN

APPROVED: *[Signature]*
BRIDGE ENGINEER


COUNTY	CONTRACT	S. & R. NO.	STATE	FED. AID PROJECT NO.	FISCAL YEAR	EST. NO.	TOTAL SHEETS
NEW CASTLE	6401068211	2	DEL.	1-95-1(13)		25	26

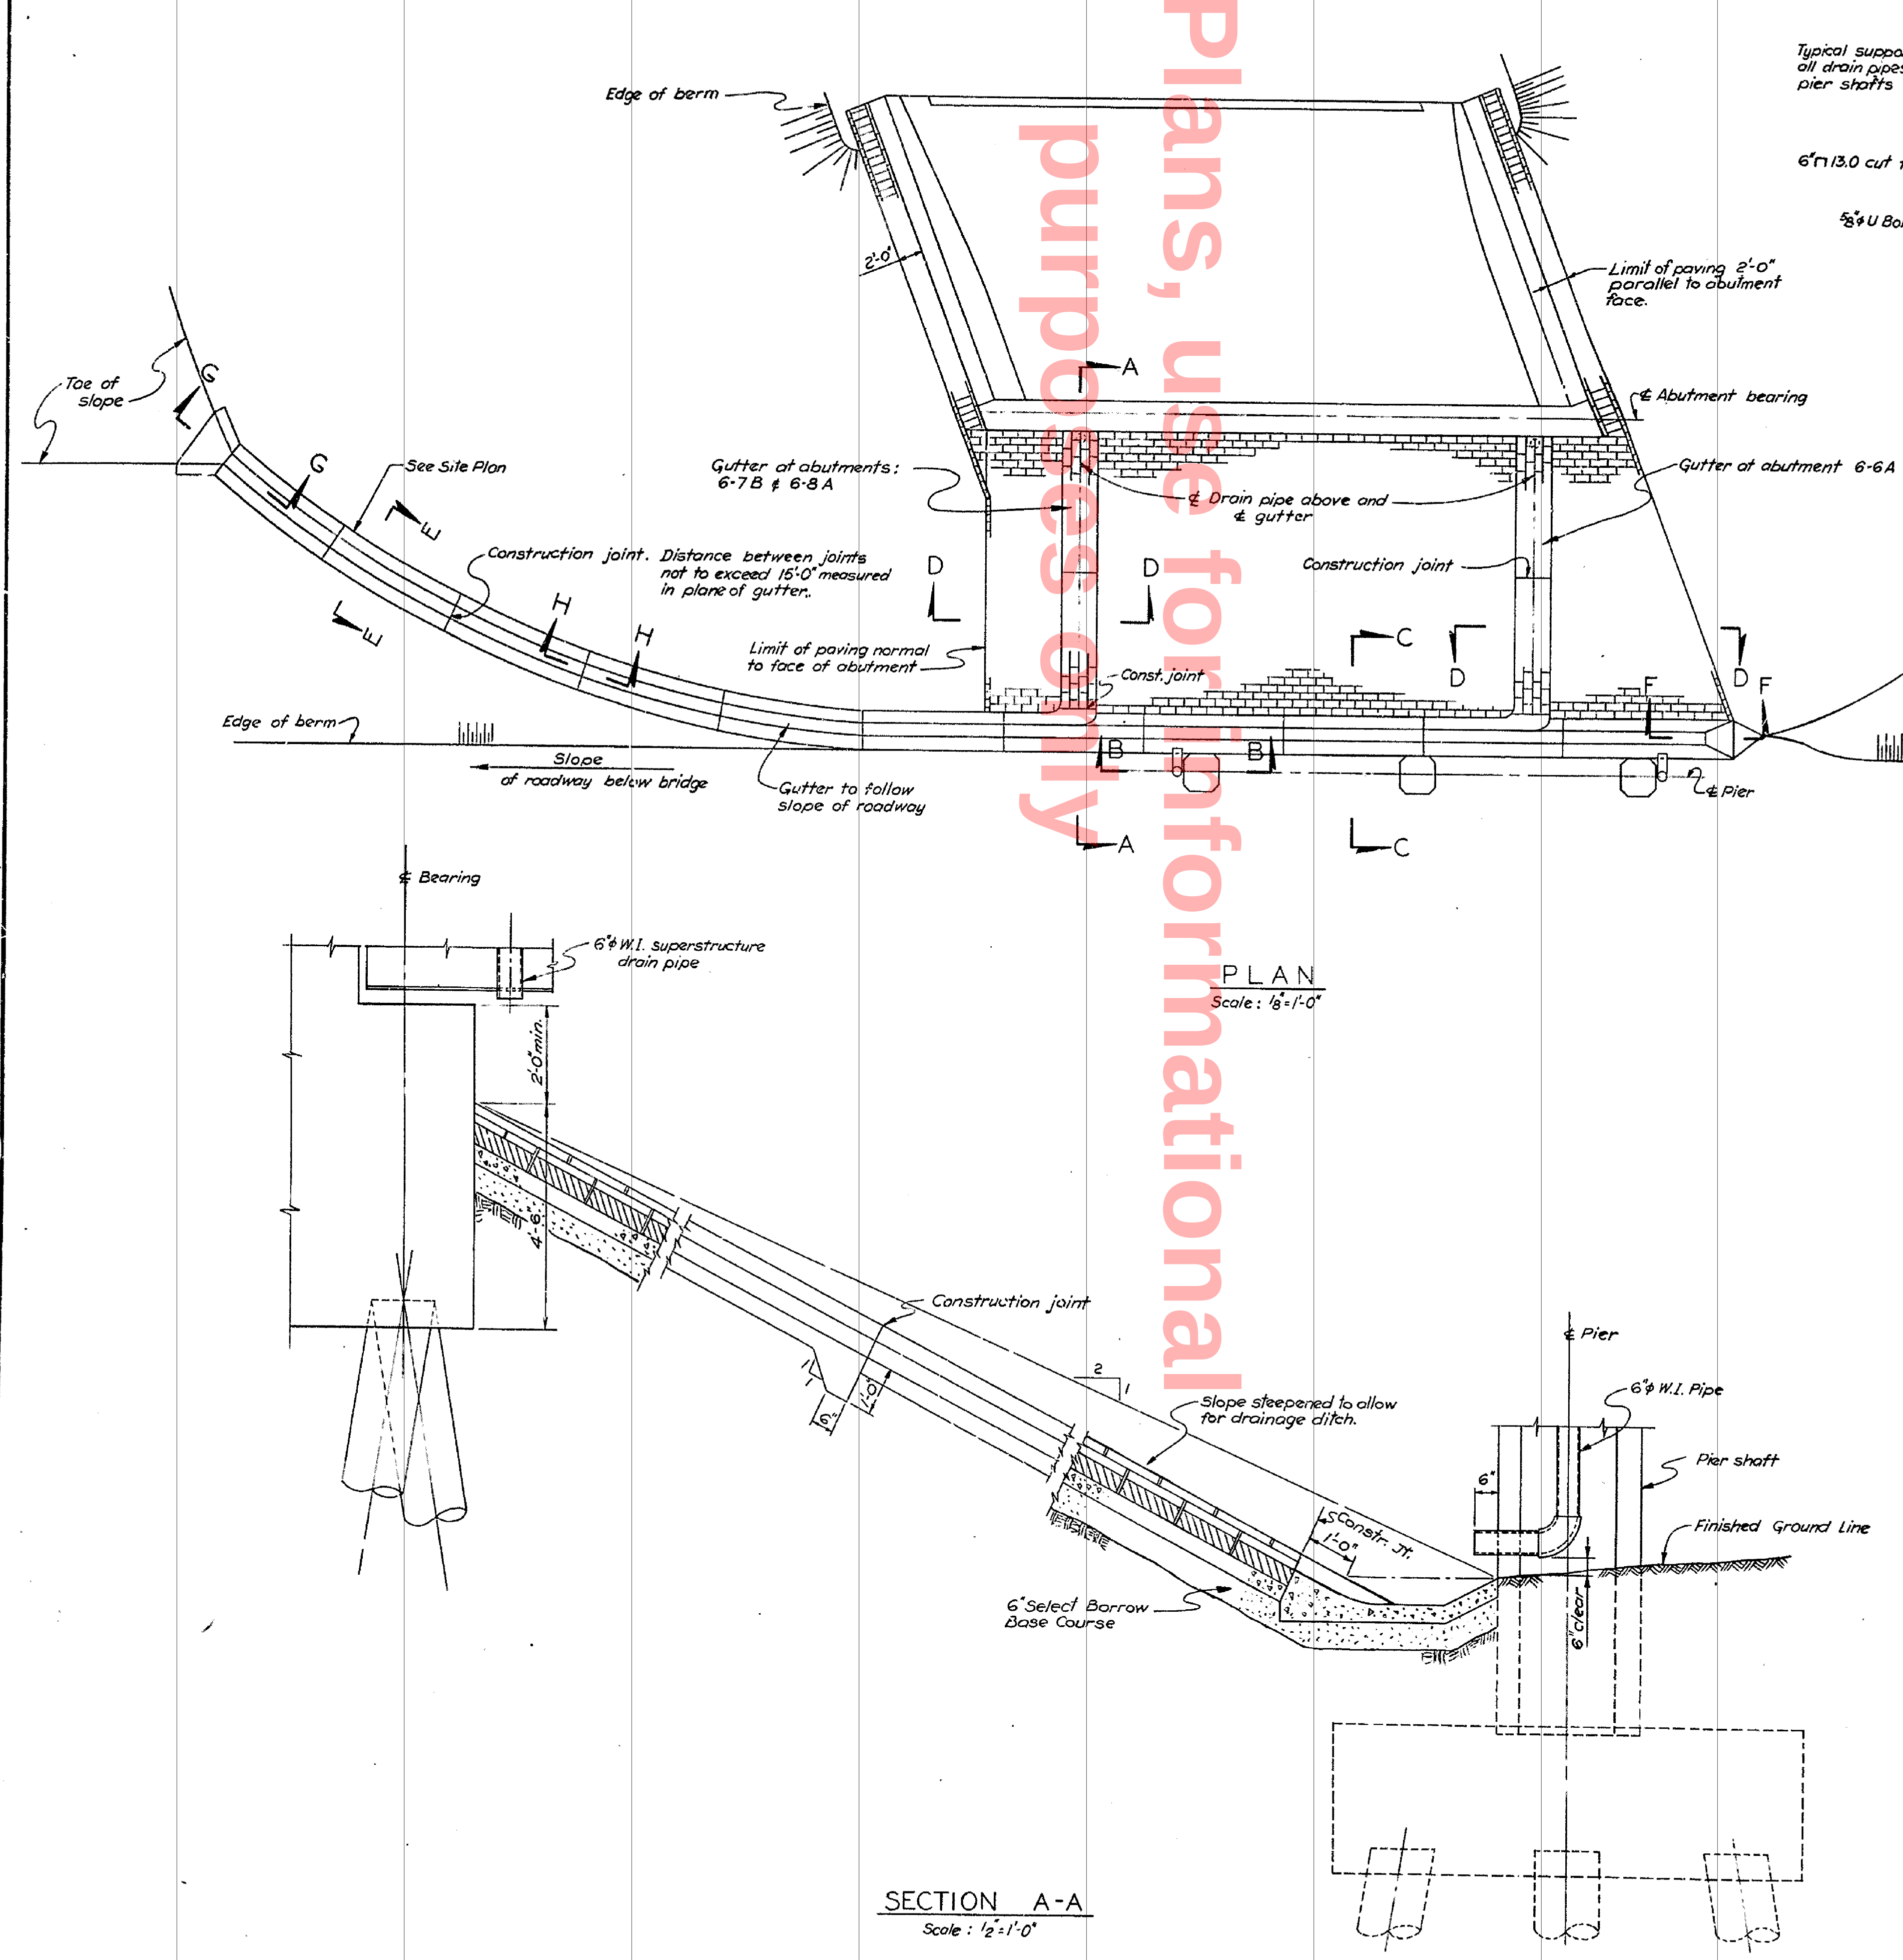


PLAN
Scale: 1/8" = 1'-0"

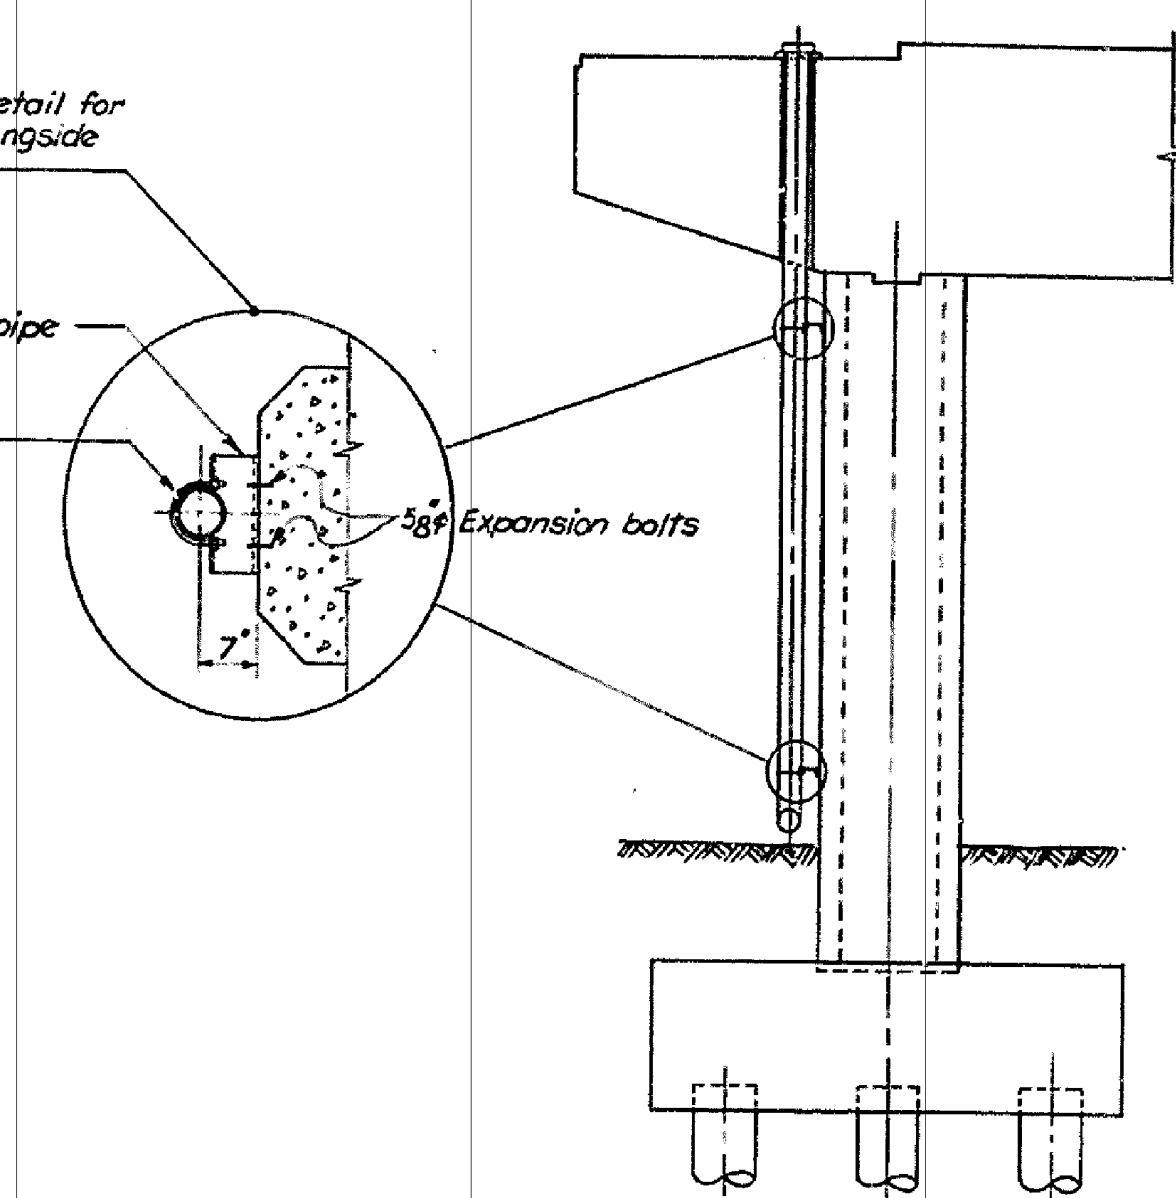


SECTION B-B
Scale: 1/4" = 1'-0"

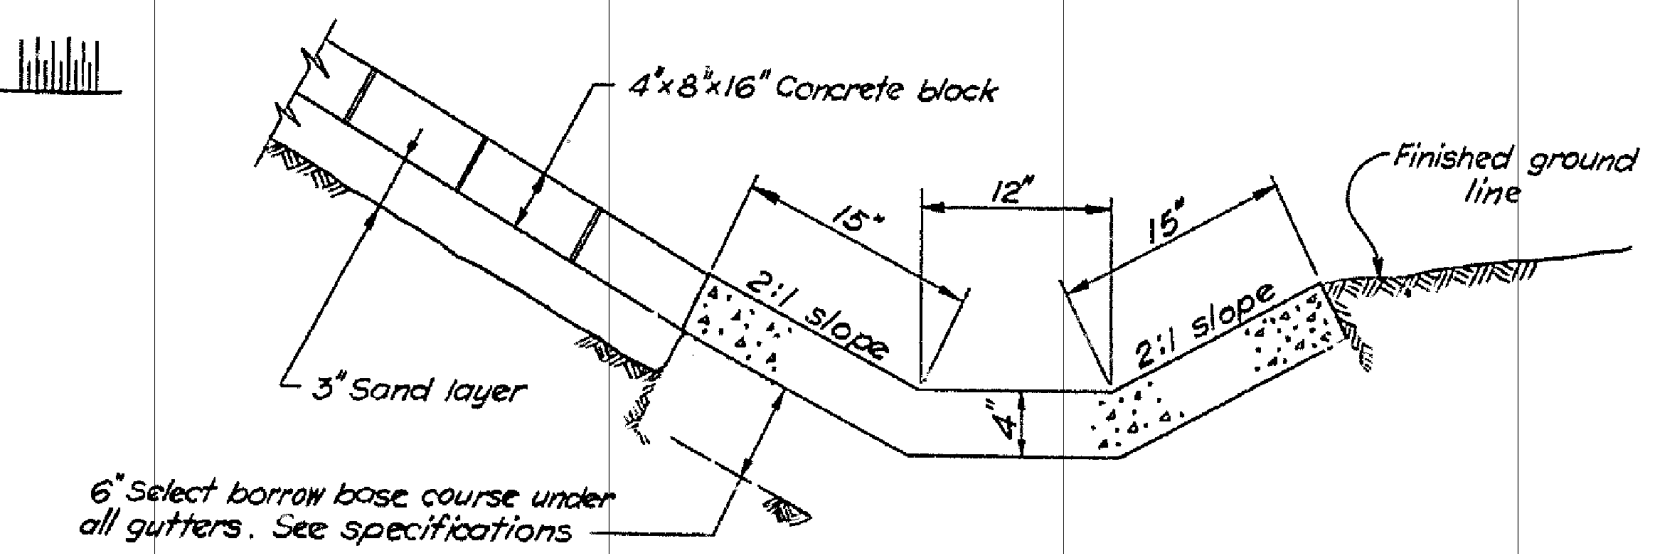


SECTION C-C
Scale: 1" = 1'-0"

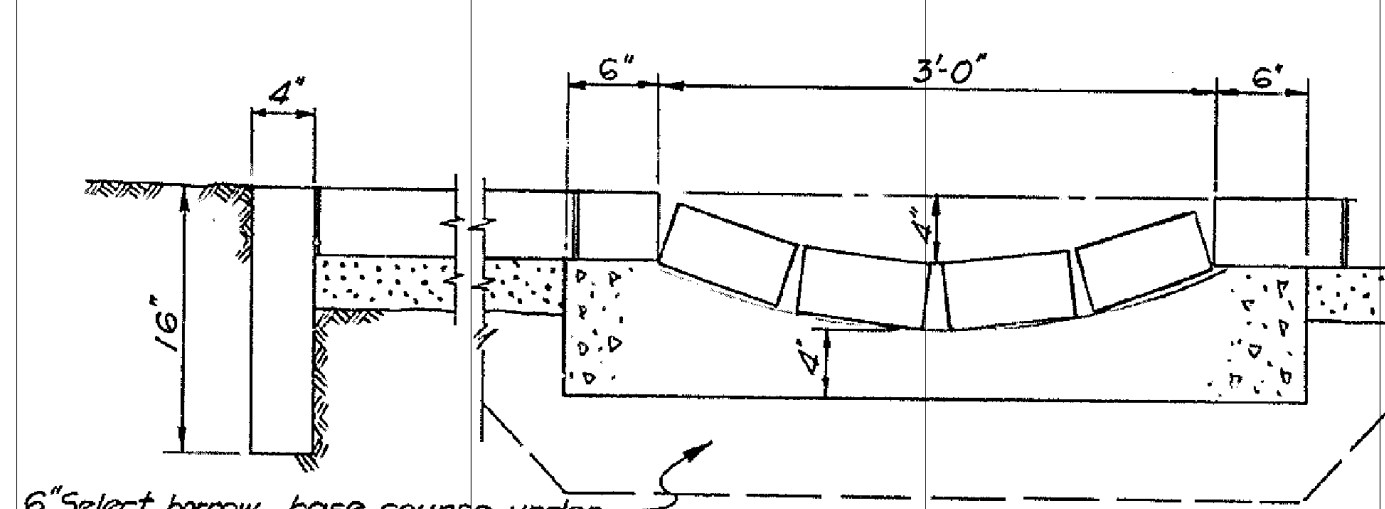


SECTION D-D
Scale: 1" = 1'-0"

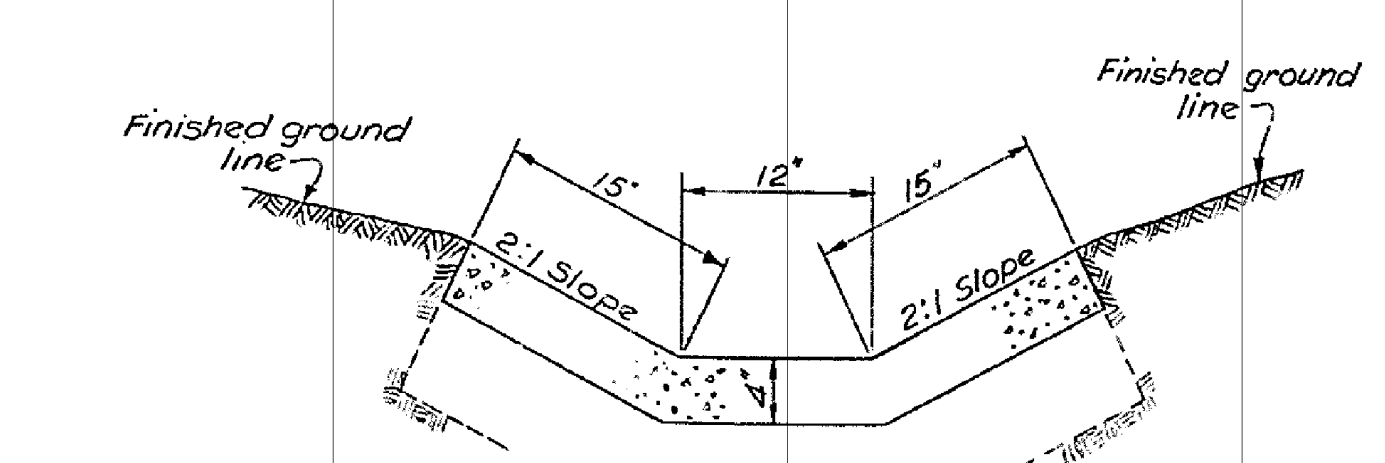


SECTION E-E
Scale: 1" = 1'-0"

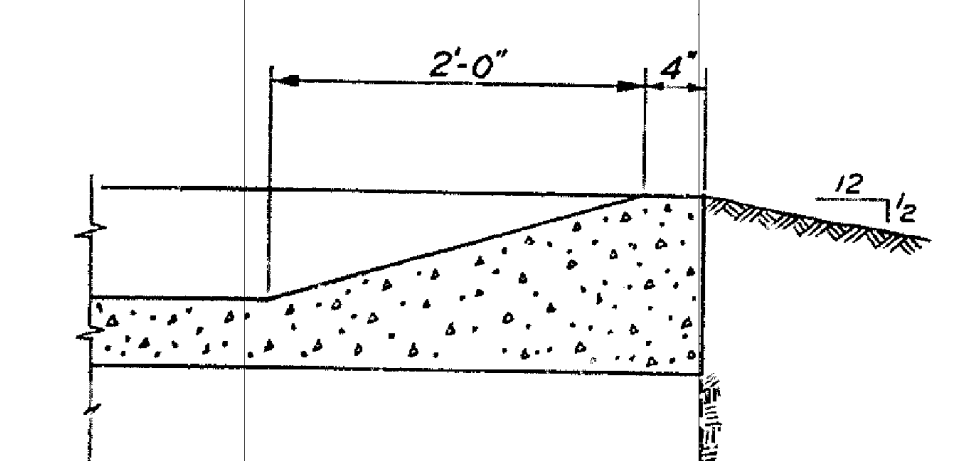

SECTION F-F
Scale: 1/2" = 1'-0"

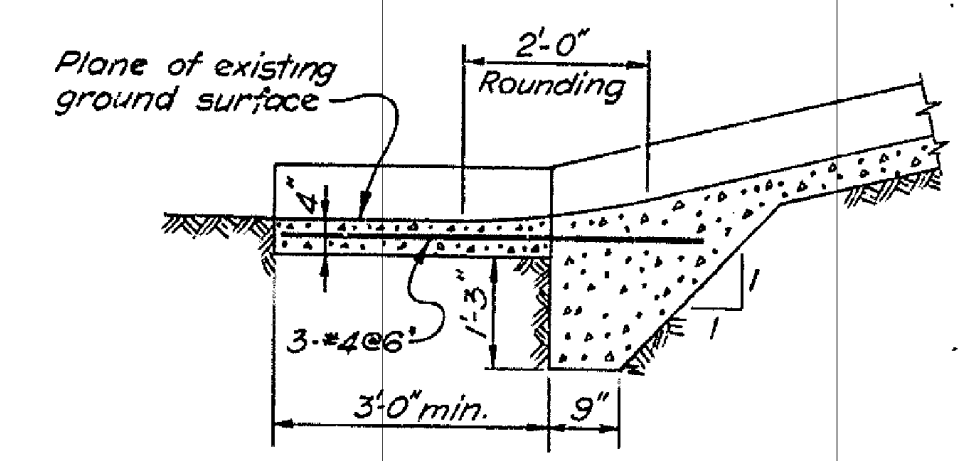

SECTION G-G
Scale: 1/2" = 1'-0"

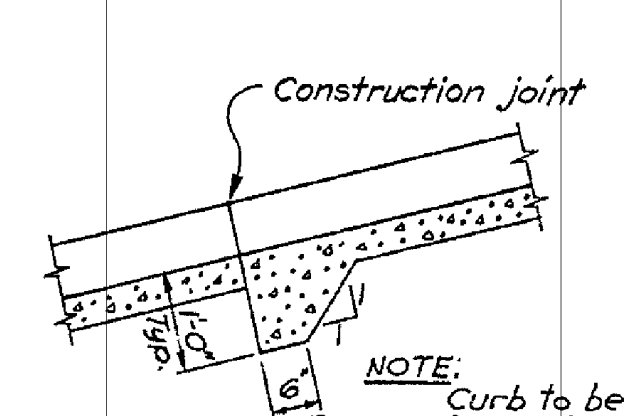


SECTION H-H
Scale: 1/2" = 1'-0"


- NOTES:
1. For General Notes see Sheet No. 2
 2. For lengths and locations of concrete gutters see Site Plans for Bridges Nos. 6-6, 6-7 and 6-8.
 3. For location of drain pipes see Superstructure Framing for Bridges Nos. 6-6, 6-7 and 6-8.
 4. For details of drain pipes see Sheet No. 24.

DELAWARE
STATE HIGHWAY DEPARTMENT
INTERSTATE ROUTE F.A.I.-1
CHRISTINA RIVER INTERCHANGE
BRIDGE NOS. 6-6, 6-7 & 6-8
SLOPE PROTECTION & DRAINAGE DETAILS
J.E. GREINER CO.
MORAN, PROCTOR, MUESER & RUTLEDGE
CONSULTING ENGINEERS
DESIGNED: W.A.A. CHECKED: M.W.K. DATE: 7/31/53
DRAWN: S.E. IN CHARGE: N.W.S. SCALE: AS NOTED


APPROVED *[Signature]* BRIDGE ENGINEER

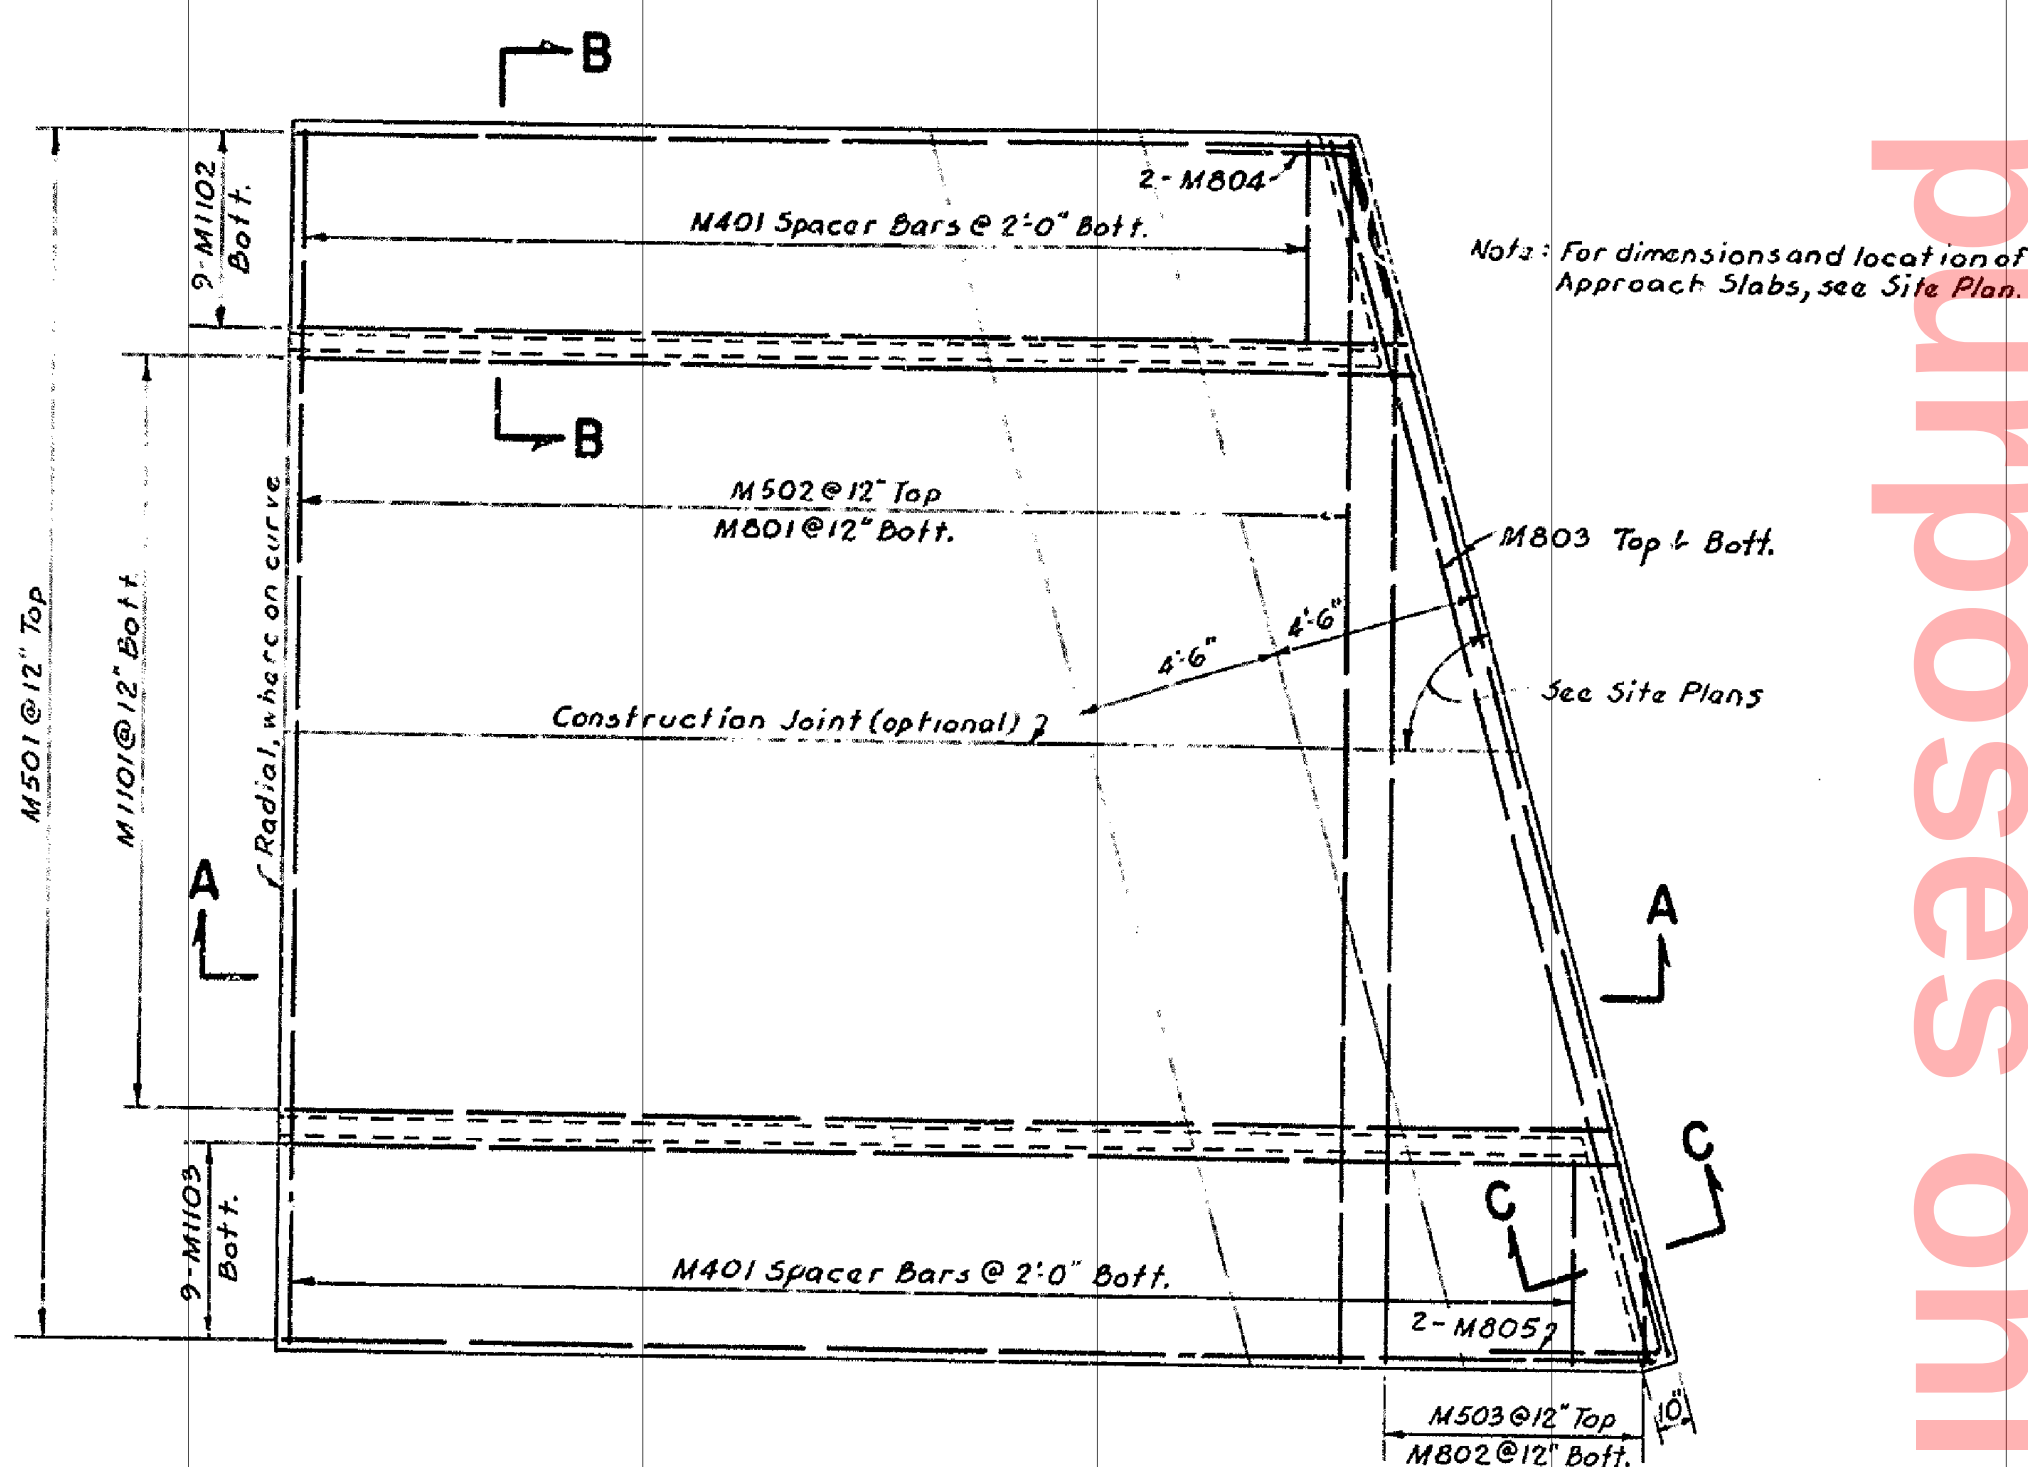


DECK PLAN
No Scale

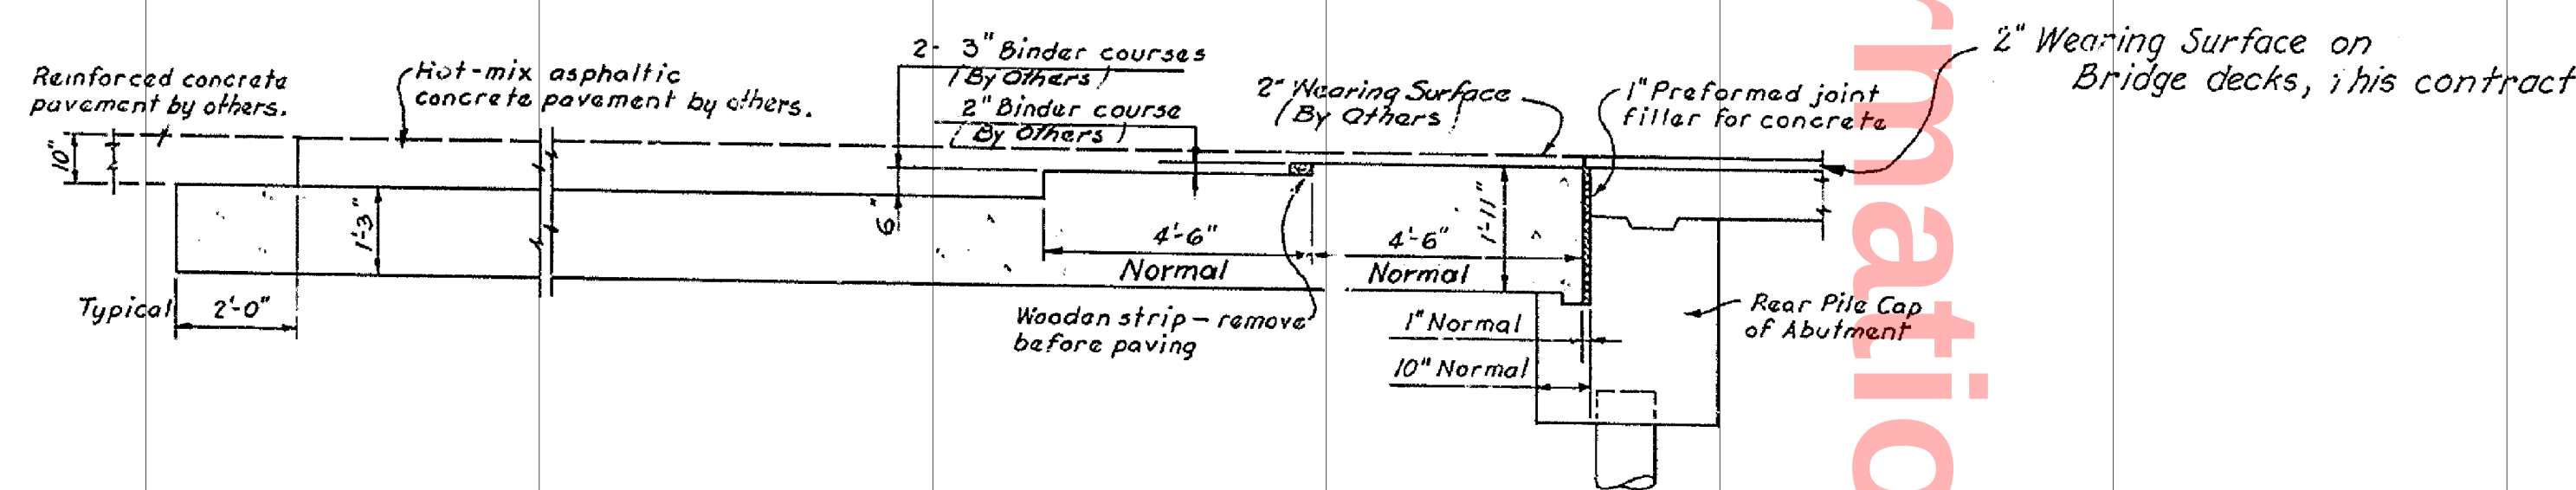

SECTION A-A
1/2" = 1'-0"

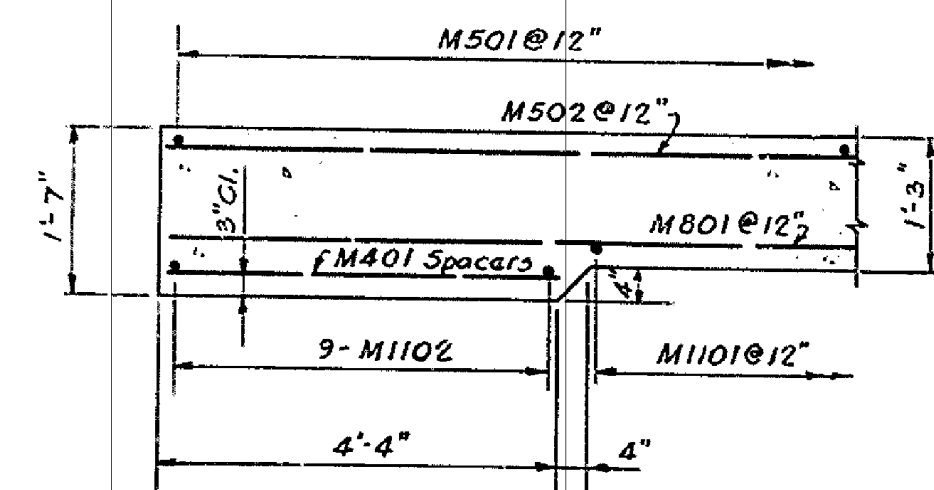


SECTION B-B
1/2" = 1'-0"

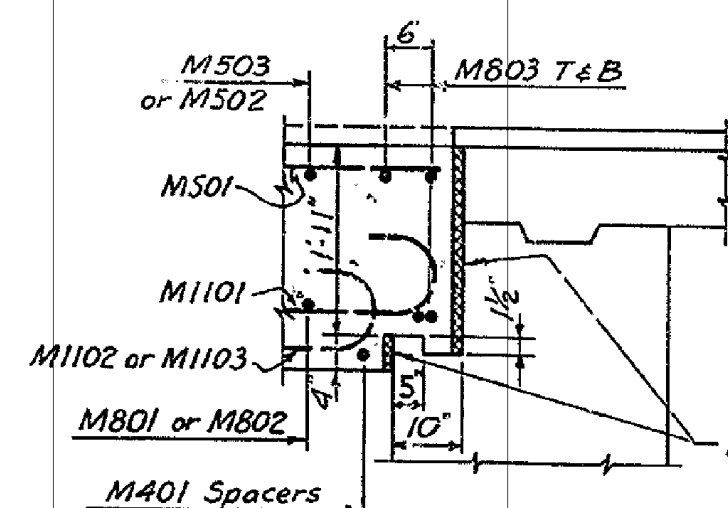

SECTION C-C
1/2" = 1'-0"

LONGITUDINAL CONSTRUCTION
JOINT DETAIL
No Scale

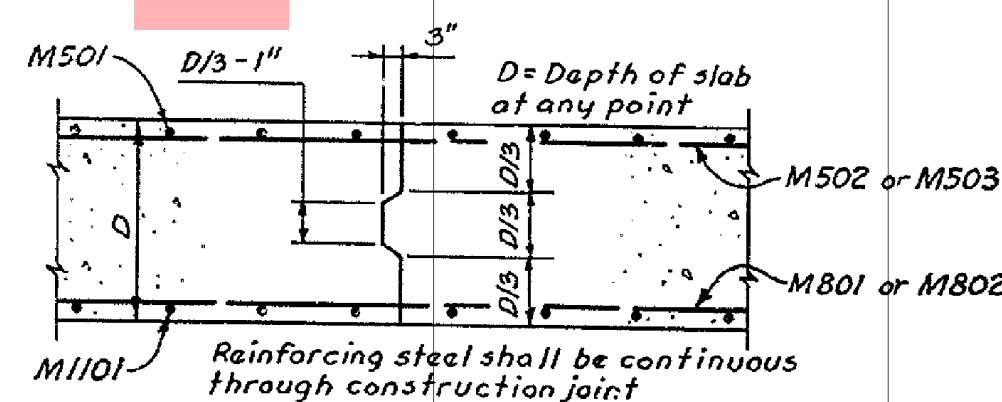

REINFORCING SCHEDULE															
BRIDGE N° 6-6								BRIDGE N° 6-7							
ABUTMENT "A"				ABUTMENT "B"				ABUTMENT "A"				ABUTMENT "B"			
Mark	Type	Number Required	Length "L"	Number Required	Length "L"	Number Required	Length "L"	Mark	Type	Number Required	Length "L"	Number Required	Length "L"	Number Required	Length "L"
M 1101	③	16 1 Ea.	Varies 25'-0" to 27'-4"	16 1 Ea.	Varies 23'-5" to 25'-9"	16 1 Ea.	Varies 24'-3" to 26'-3"	M 1102	③	9 1 Ea.	Varies 23'-5" to 23'-11"	9 1 Ea.	Varies 21'-8" to 22'-4"	9 1 Ea.	Varies 20'-7" to 21'-10"
M 1102	③	9 1 Ea.	Varies 23'-5" to 23'-11"	9 1 Ea.	Varies 21'-8" to 22'-4"	9 1 Ea.	Varies 20'-7" to 21'-10"	M 1103	③	9 1 Ea.	Varies 26'-1" to 26'-9"	9 1 Ea.	Varies 24'-6" to 25'-2"	9 1 Ea.	Varies 23'-5" to 24'-1"
M 801	St.	23	23'-8"	25	23'-8"	21	23'-8"	M 802	St.	3 1 Ea.	Varies 22'-4" to 10'-4"	12 1 Ea.	Varies 22'-9" to 3'-9"	8 1 Ea.	Varies 21'-0" to 3'-0"
M 802	St.	4	23'-10"	4	23'-8"	4	23'-7"	M 803	St.	4	23'-10"	4	23'-8"	4	23'-5"
M 803	St.	4	23'-10"	4	23'-8"	4	23'-7"	M 804	①	2	6'-0"	2	6'-0"	2	6'-0"
M 804	①	2	6'-0"	2	6'-0"	2	6'-0"	M 805	②	2	6'-0"	2	6'-0"	2	6'-0"
M 501	St.	24 1 Ea.	Varies 19'-9" to 26'-4"	24 1 Ea.	Varies 24'-3" to 24'-8"	24 1 Ea.	Varies 19'-9" to 29'-2"	M 502	St.	23	23'-8"	25	23'-8"	18	23'-8"
M 502	St.	23	23'-8"	25	23'-8"	21	23'-8"	M 503	St.	3 1 Ea.	Varies 22'-4" to 10'-4"	12 1 Ea.	Varies 22'-9" to 3'-9"	8 1 Ea.	Varies 21'-0" to 3'-0"
M 503	St.	3 1 Ea.	Varies 22'-4" to 10'-4"	-	-	8 1 Ea.	Varies 21'-0" to 4'-0"	M 401	St.	25	4'-0"	26	4'-0"	24	4'-0"
M 401	St.	25	4'-0"	26	4'-0"	24	4'-0"								
Total Weights-Lbs.			7818		7831		7792		7766		7841		7862		
Total Weight = 46,910 Lbs.															
All dimensions are out to out. Bar size is indicated in the bar mark. The first digit where three digits are used, and the first two digits where four digits are used indicate the bar size.															

DELAWARE
STATE HIGHWAY DEPARTMENT
INTERSTATE ROUTE F.A.I.-1
CHRISTINA RIVER INTERCHANGE
BRIDGES NO. 6-6, 6-7 & 6-8
APPROACH SLABS

J.E. GREINER CO.
MORAN, PROCTOR, MUZZER & RUTLEDGE
CONSULTING ENGINEERS

DESIGNED: J.W.H. CHECKED: J.W.H. DATE: 12-19-63
DRAWN: W.W.W. IN CHARGE: G.B.M. SCALE: As Shown

APPROVED: [Signature] BRIDGE ENGINEER